



5212

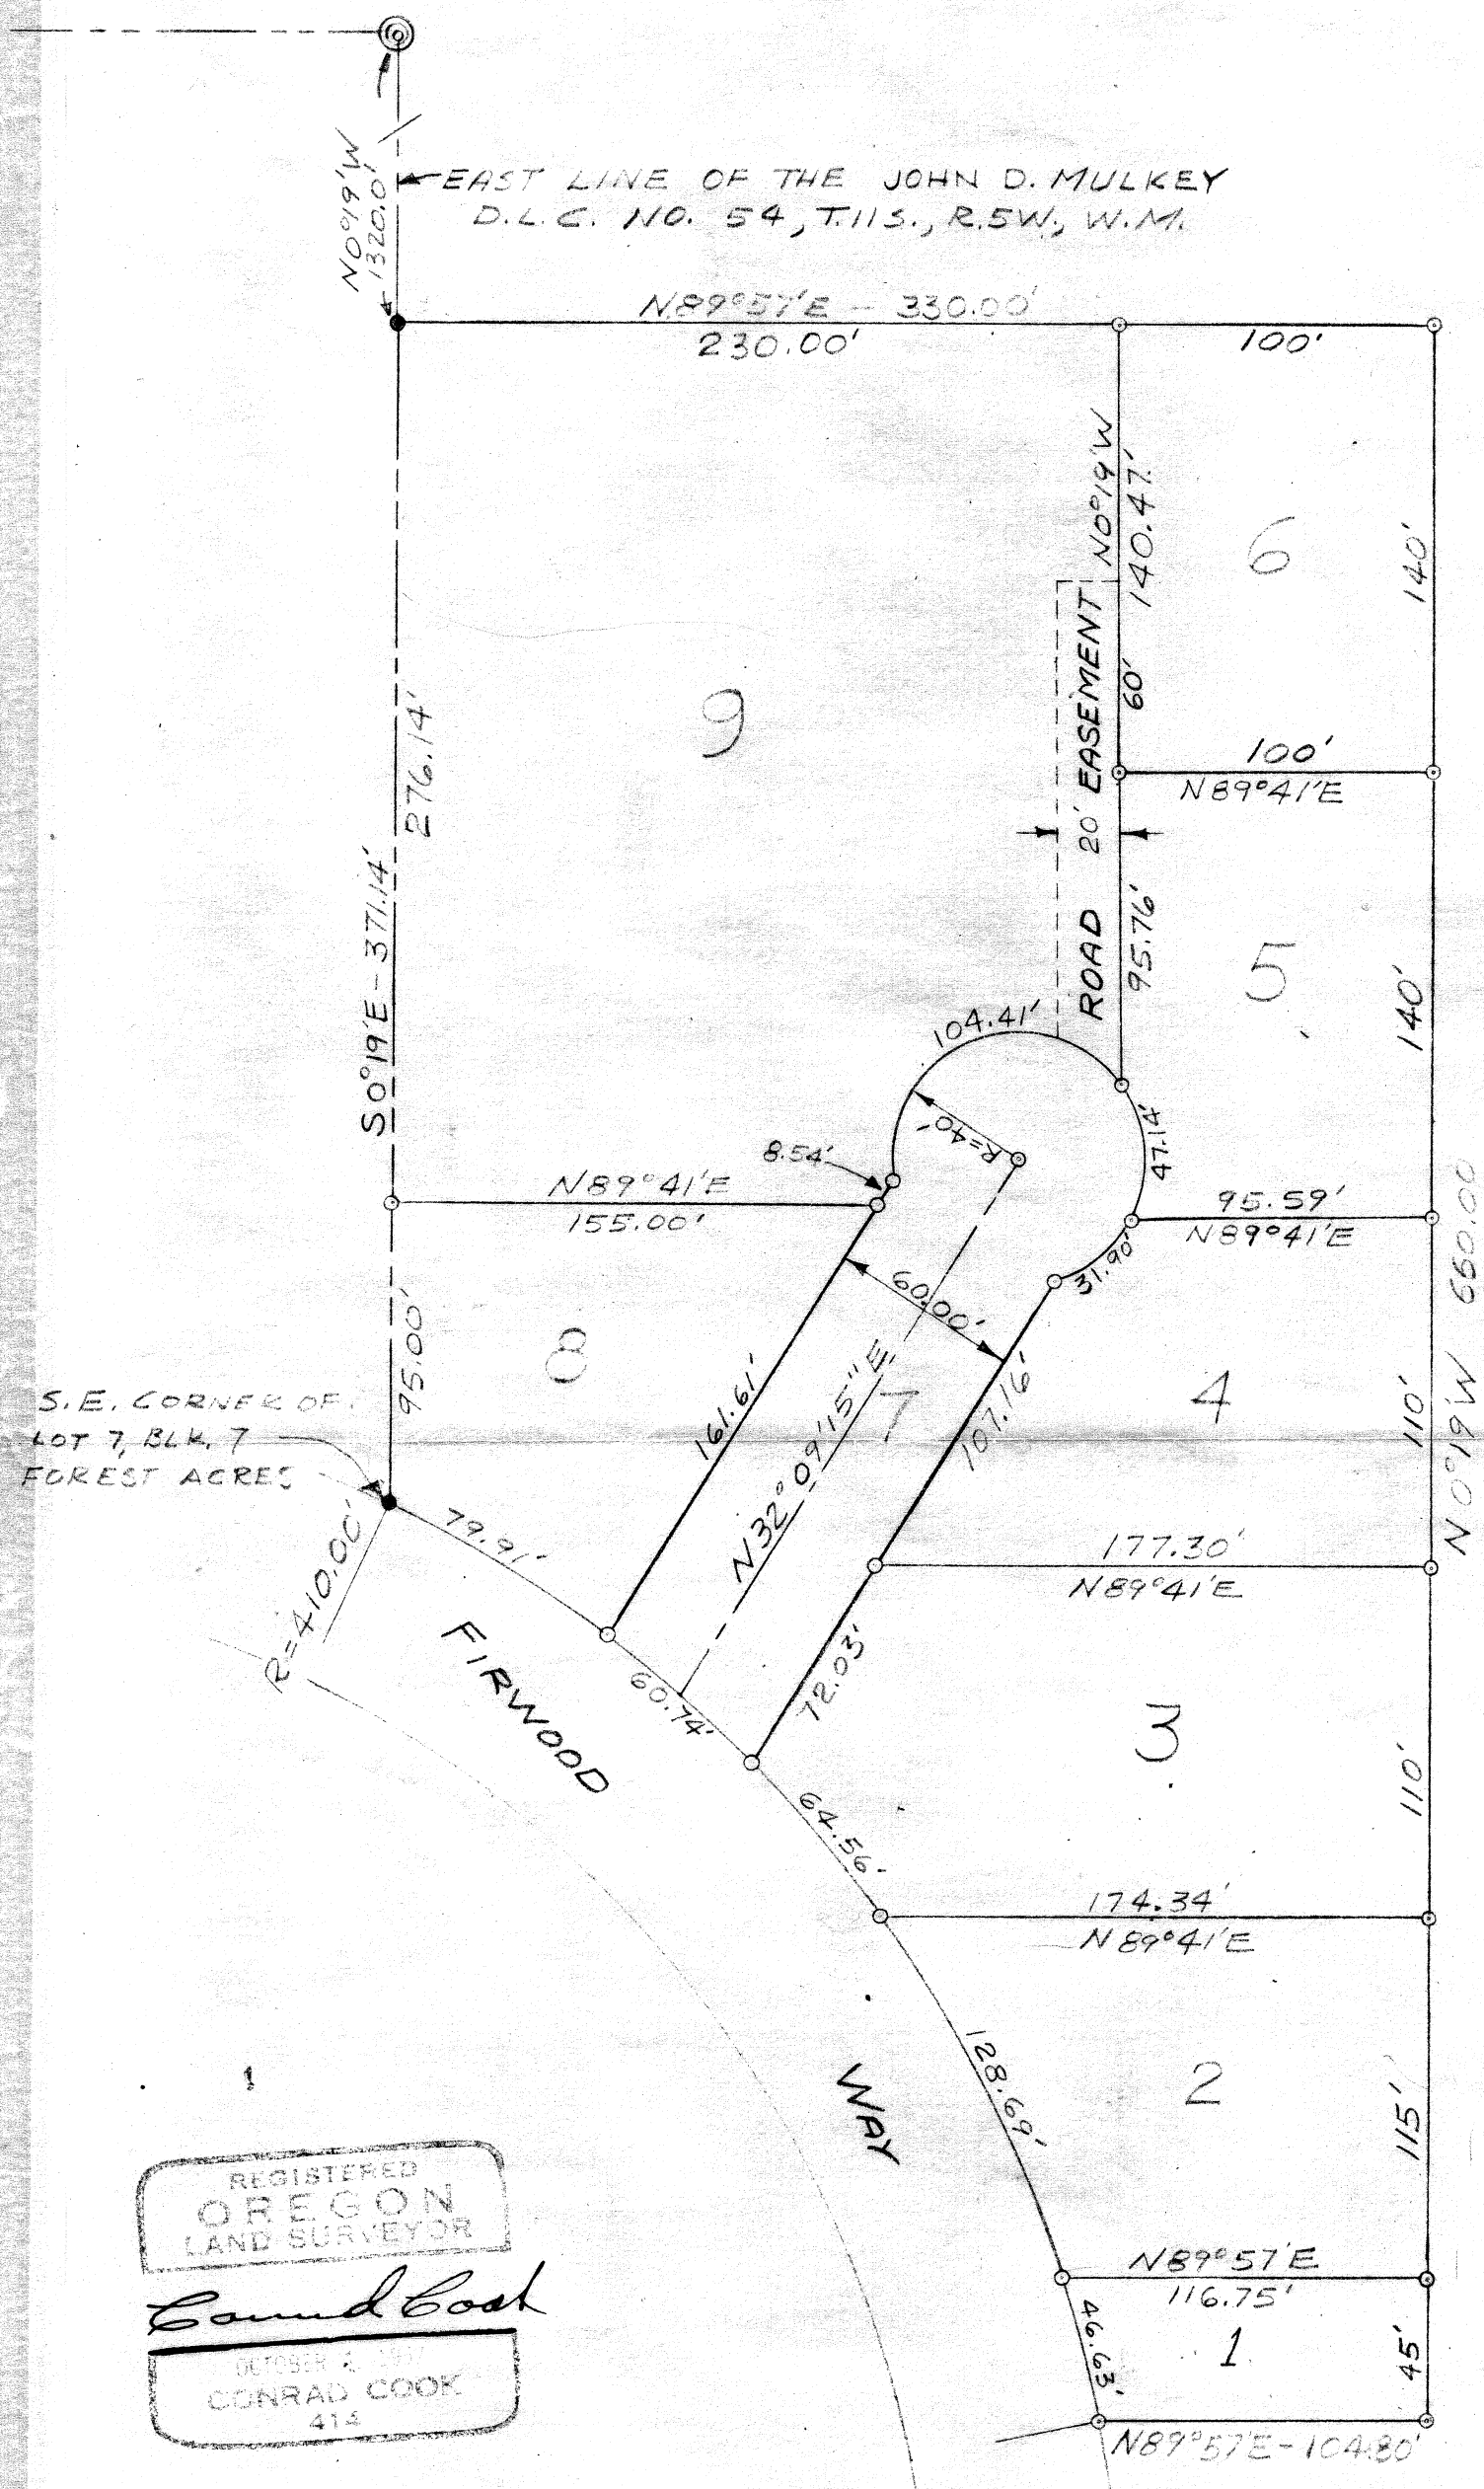

S.E. CORNER OF LOT 7, BLK. 7 FOREST ACRES

REGISTERED
 OREGON
 LAND SURVEYOR
Conrad Cook
 OCTOBER 2, 1959
 CONRAD COOK
 412

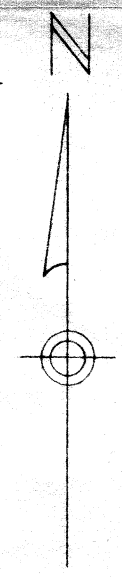

SCALE: 1"=60'

● PIPES FOUND
 ○ ROD SET
 DATE 2-3-59
 C.S. 3212

ROBERTS' TRACTS

3212

5212