


C.S. NO. 3215

DOUGLAS J. WILLSON

H.C. LEWIS D.L.C. 47, T. 11 S. R. 5 W. W.M.

SCALE : 1" = 100'

MARCH 18, 1959

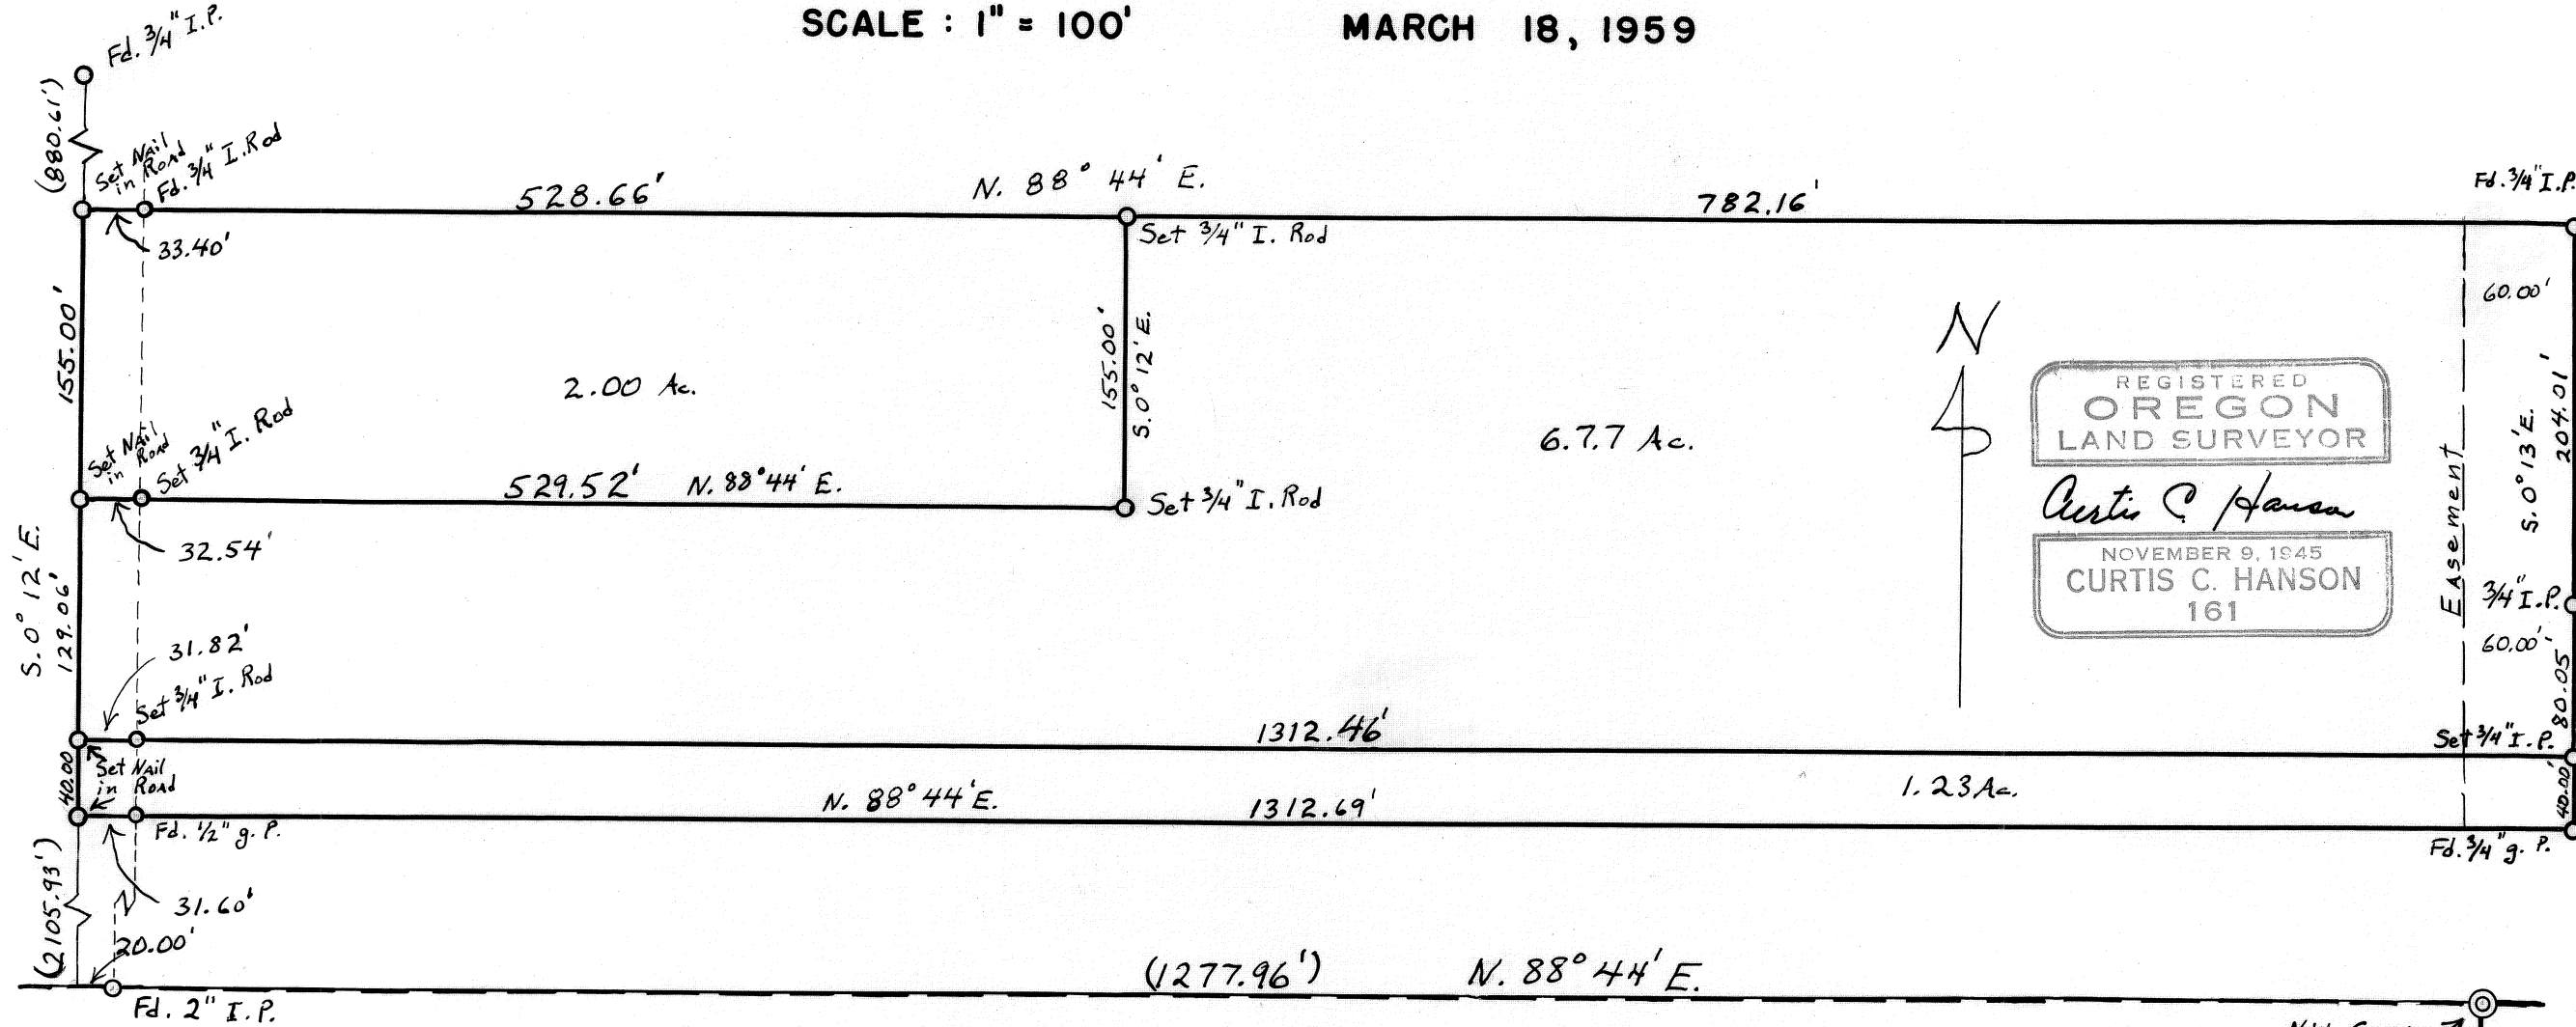

REGISTERED
OREGON
 LAND SURVEYOR
Curtis C. Hanson
 NOVEMBER 9, 1945
CURTIS C. HANSON
 161

N.W. Corner →
 John Stewart
 D.L.C. No. 49