


SURVEY FOR C.S. 3623
C.W. CARTER

LOT 10, BLOCK 4, JOB'S ADDITION
 CORVALLIS, OREGON

Scale: 1" = 40' March 23, 1962

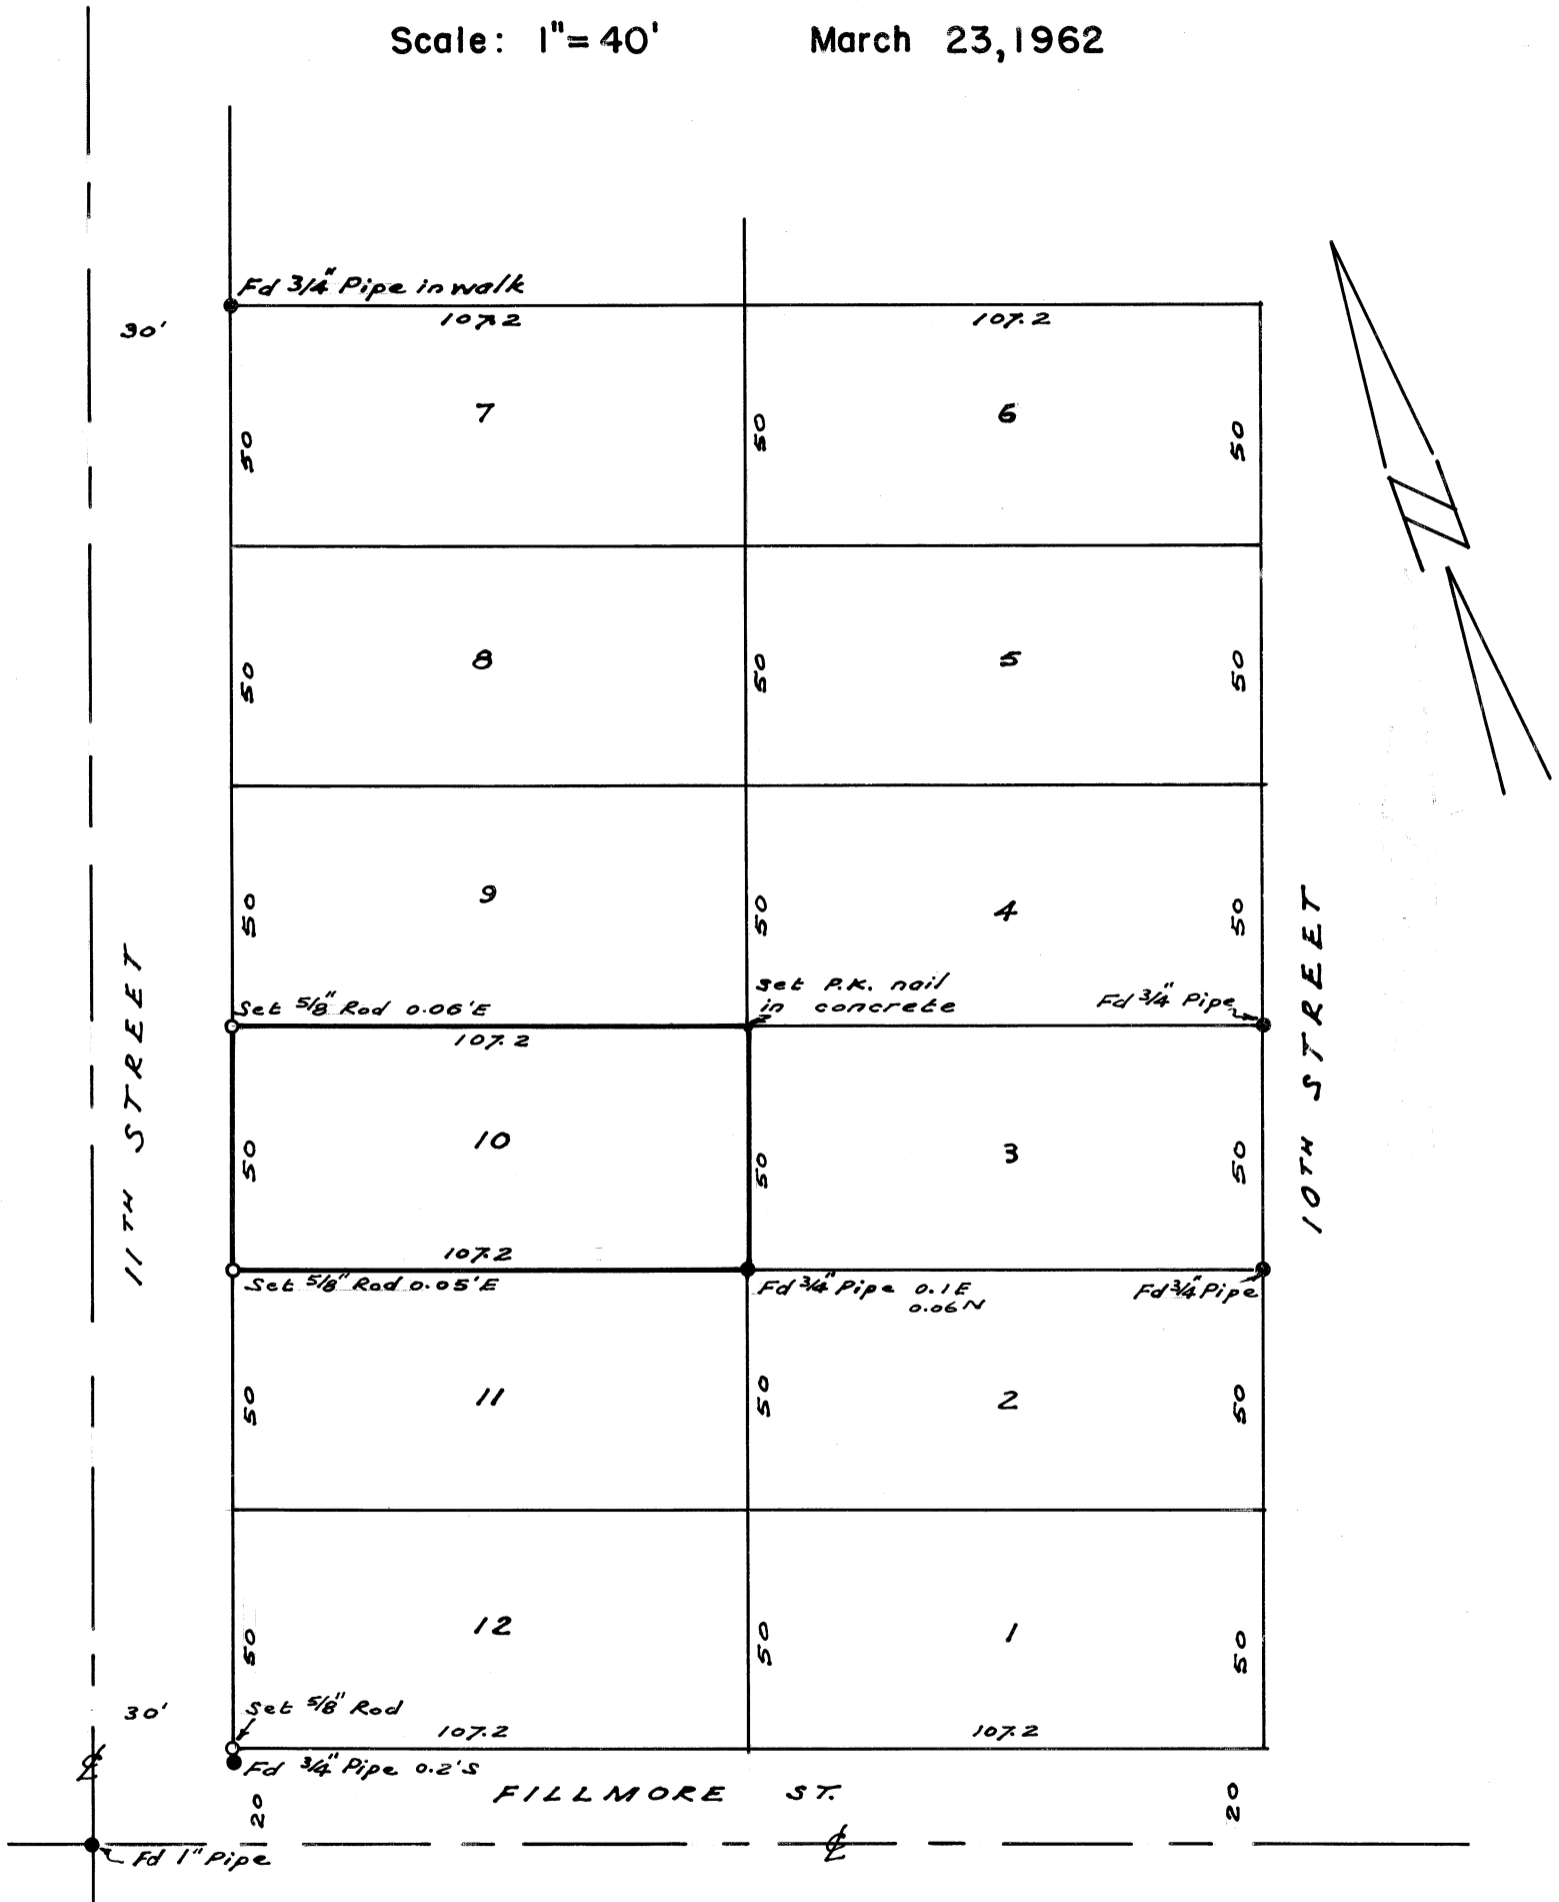

REGISTERED
 OREGON
 LAND SURVEYOR

Fred I. Lemke

MAY 8 1956
 FRED I. LEMKE
 443