

C.S. N^o 3840
 BLISS B. DALLAS

Sec. 18, T.11S., R.4W., W.B.&M.


Scale: 1" = 300'

Oct. 28, 1963

REGISTERED
 OREGON
 LAND SURVEYOR

Curtis C. Hanson

NOVEMBER 9, 1945
 CURTIS C. HANSON
 161

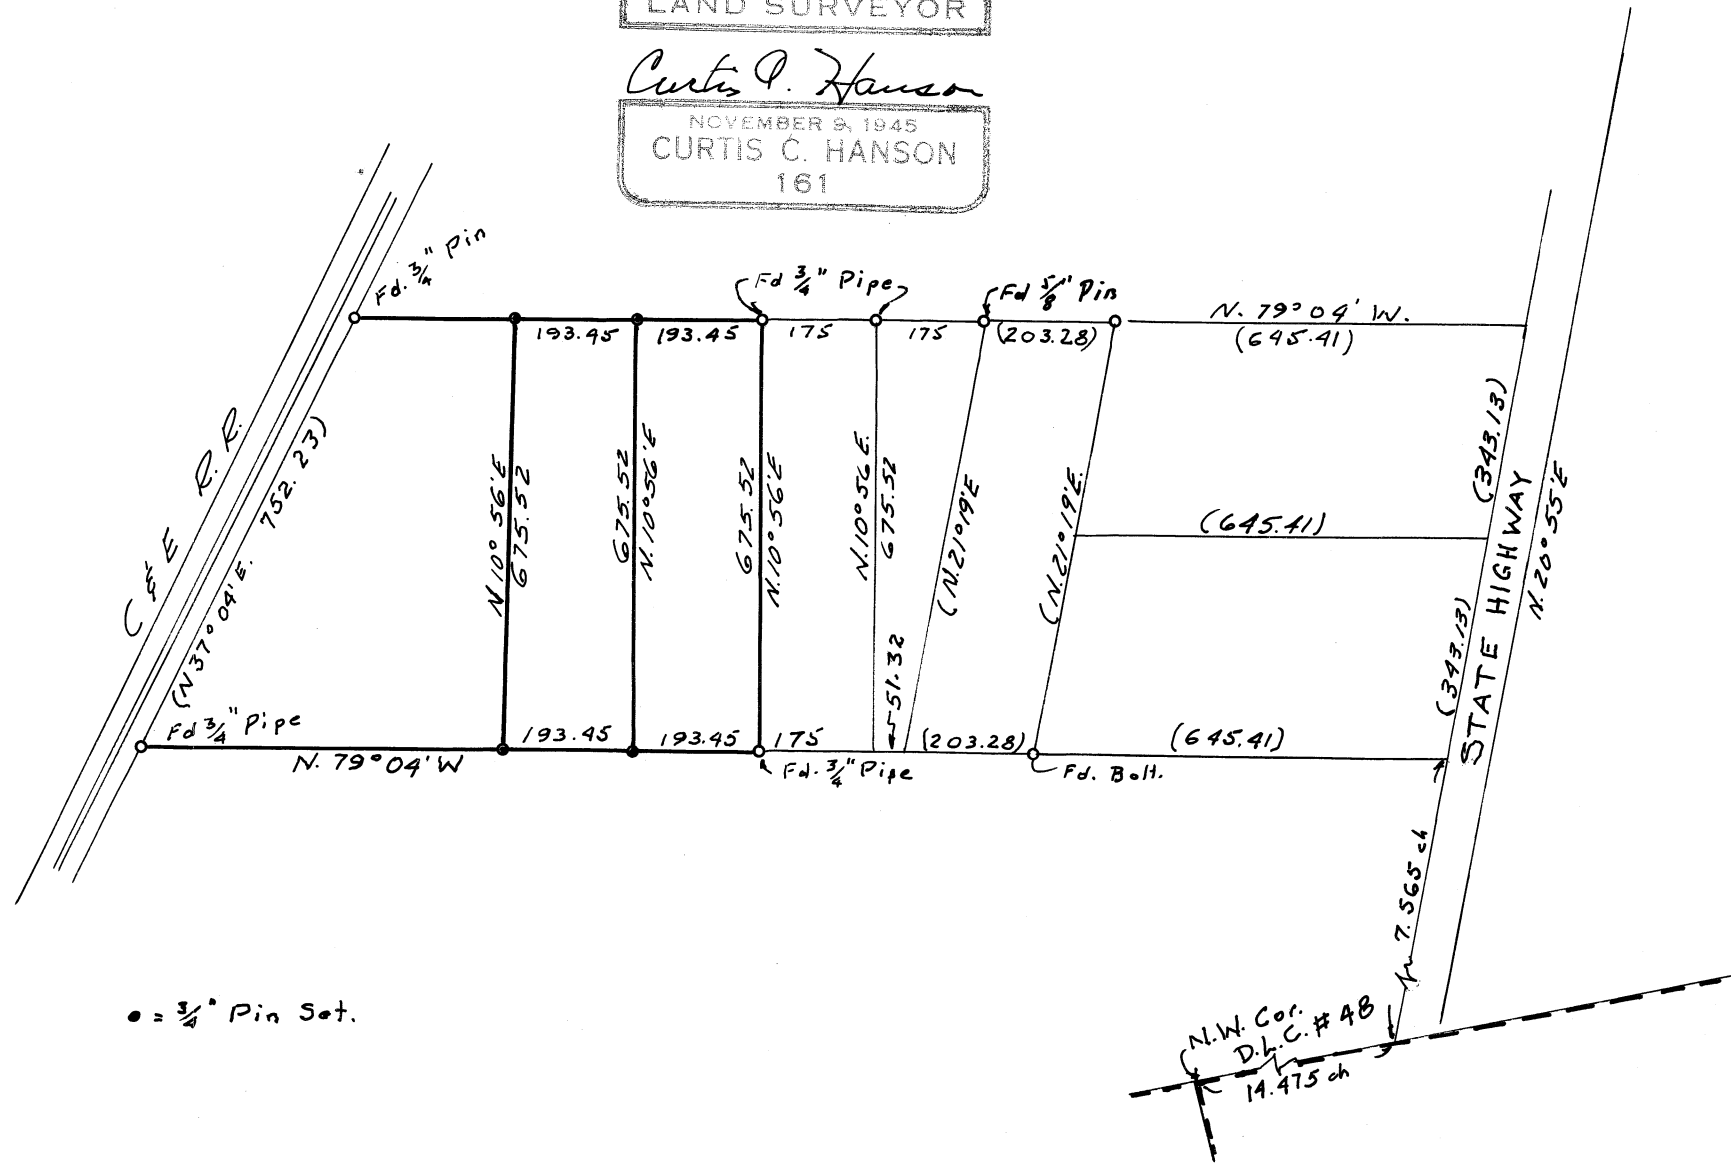

• = 3/4" Pin Set.

