


C.S. 3854
SURVEY FOR
LEE E. STEWART
 A Portion of Block 2 Willamette Dale Farms
 Benton County, Oregon
 Scale: 1"=50' Oct. 28, 1963

REGISTERED
OREGON
 LAND SURVEYOR

Fred I. Lemke
 MAY 2, 1958
FRED I. LEMKE
 443

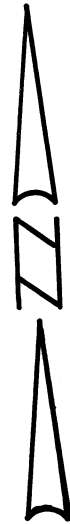

O Denotes 1/2" Pipe Set

