

Stone $S\frac{1}{4}$ cor
Sec 34
Not Fd.


C.S. 3904

GEORGE KOUNS

NE $\frac{1}{4}$ SEC. 3, T11S, R4W

APRIL 1964 SCALE 1"=400'

BERT W. UDELL R.P.E. #2301
By Ralph D. Wilkinson R.P.E. #3759

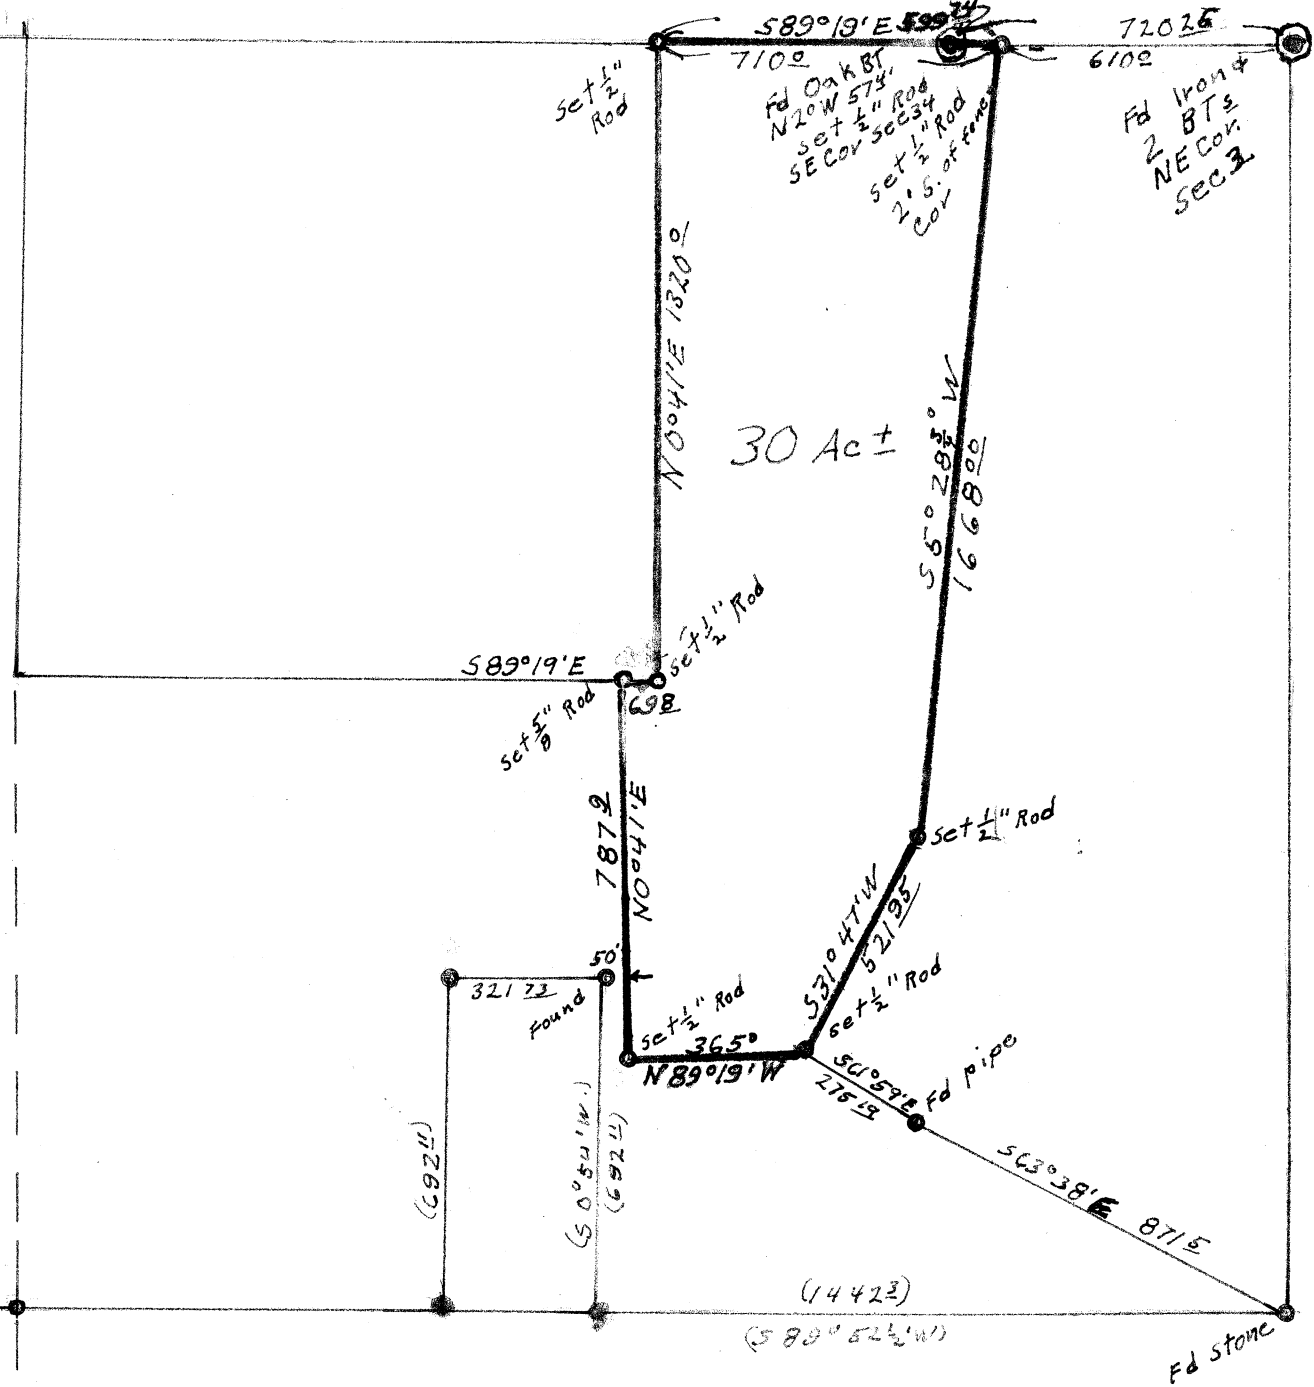

Ralph D. Wilkinson