


C.S. 3964  
 RECORD OF SURVEY  
 for  
 GLENN BROWN  
 in the OSCAR F. CLARK D.L.C.42 - T11S, R5W, W.M.  
 BENTON COUNTY, OREGON  
 SCALE 1"=100' JULY 16, 1964.

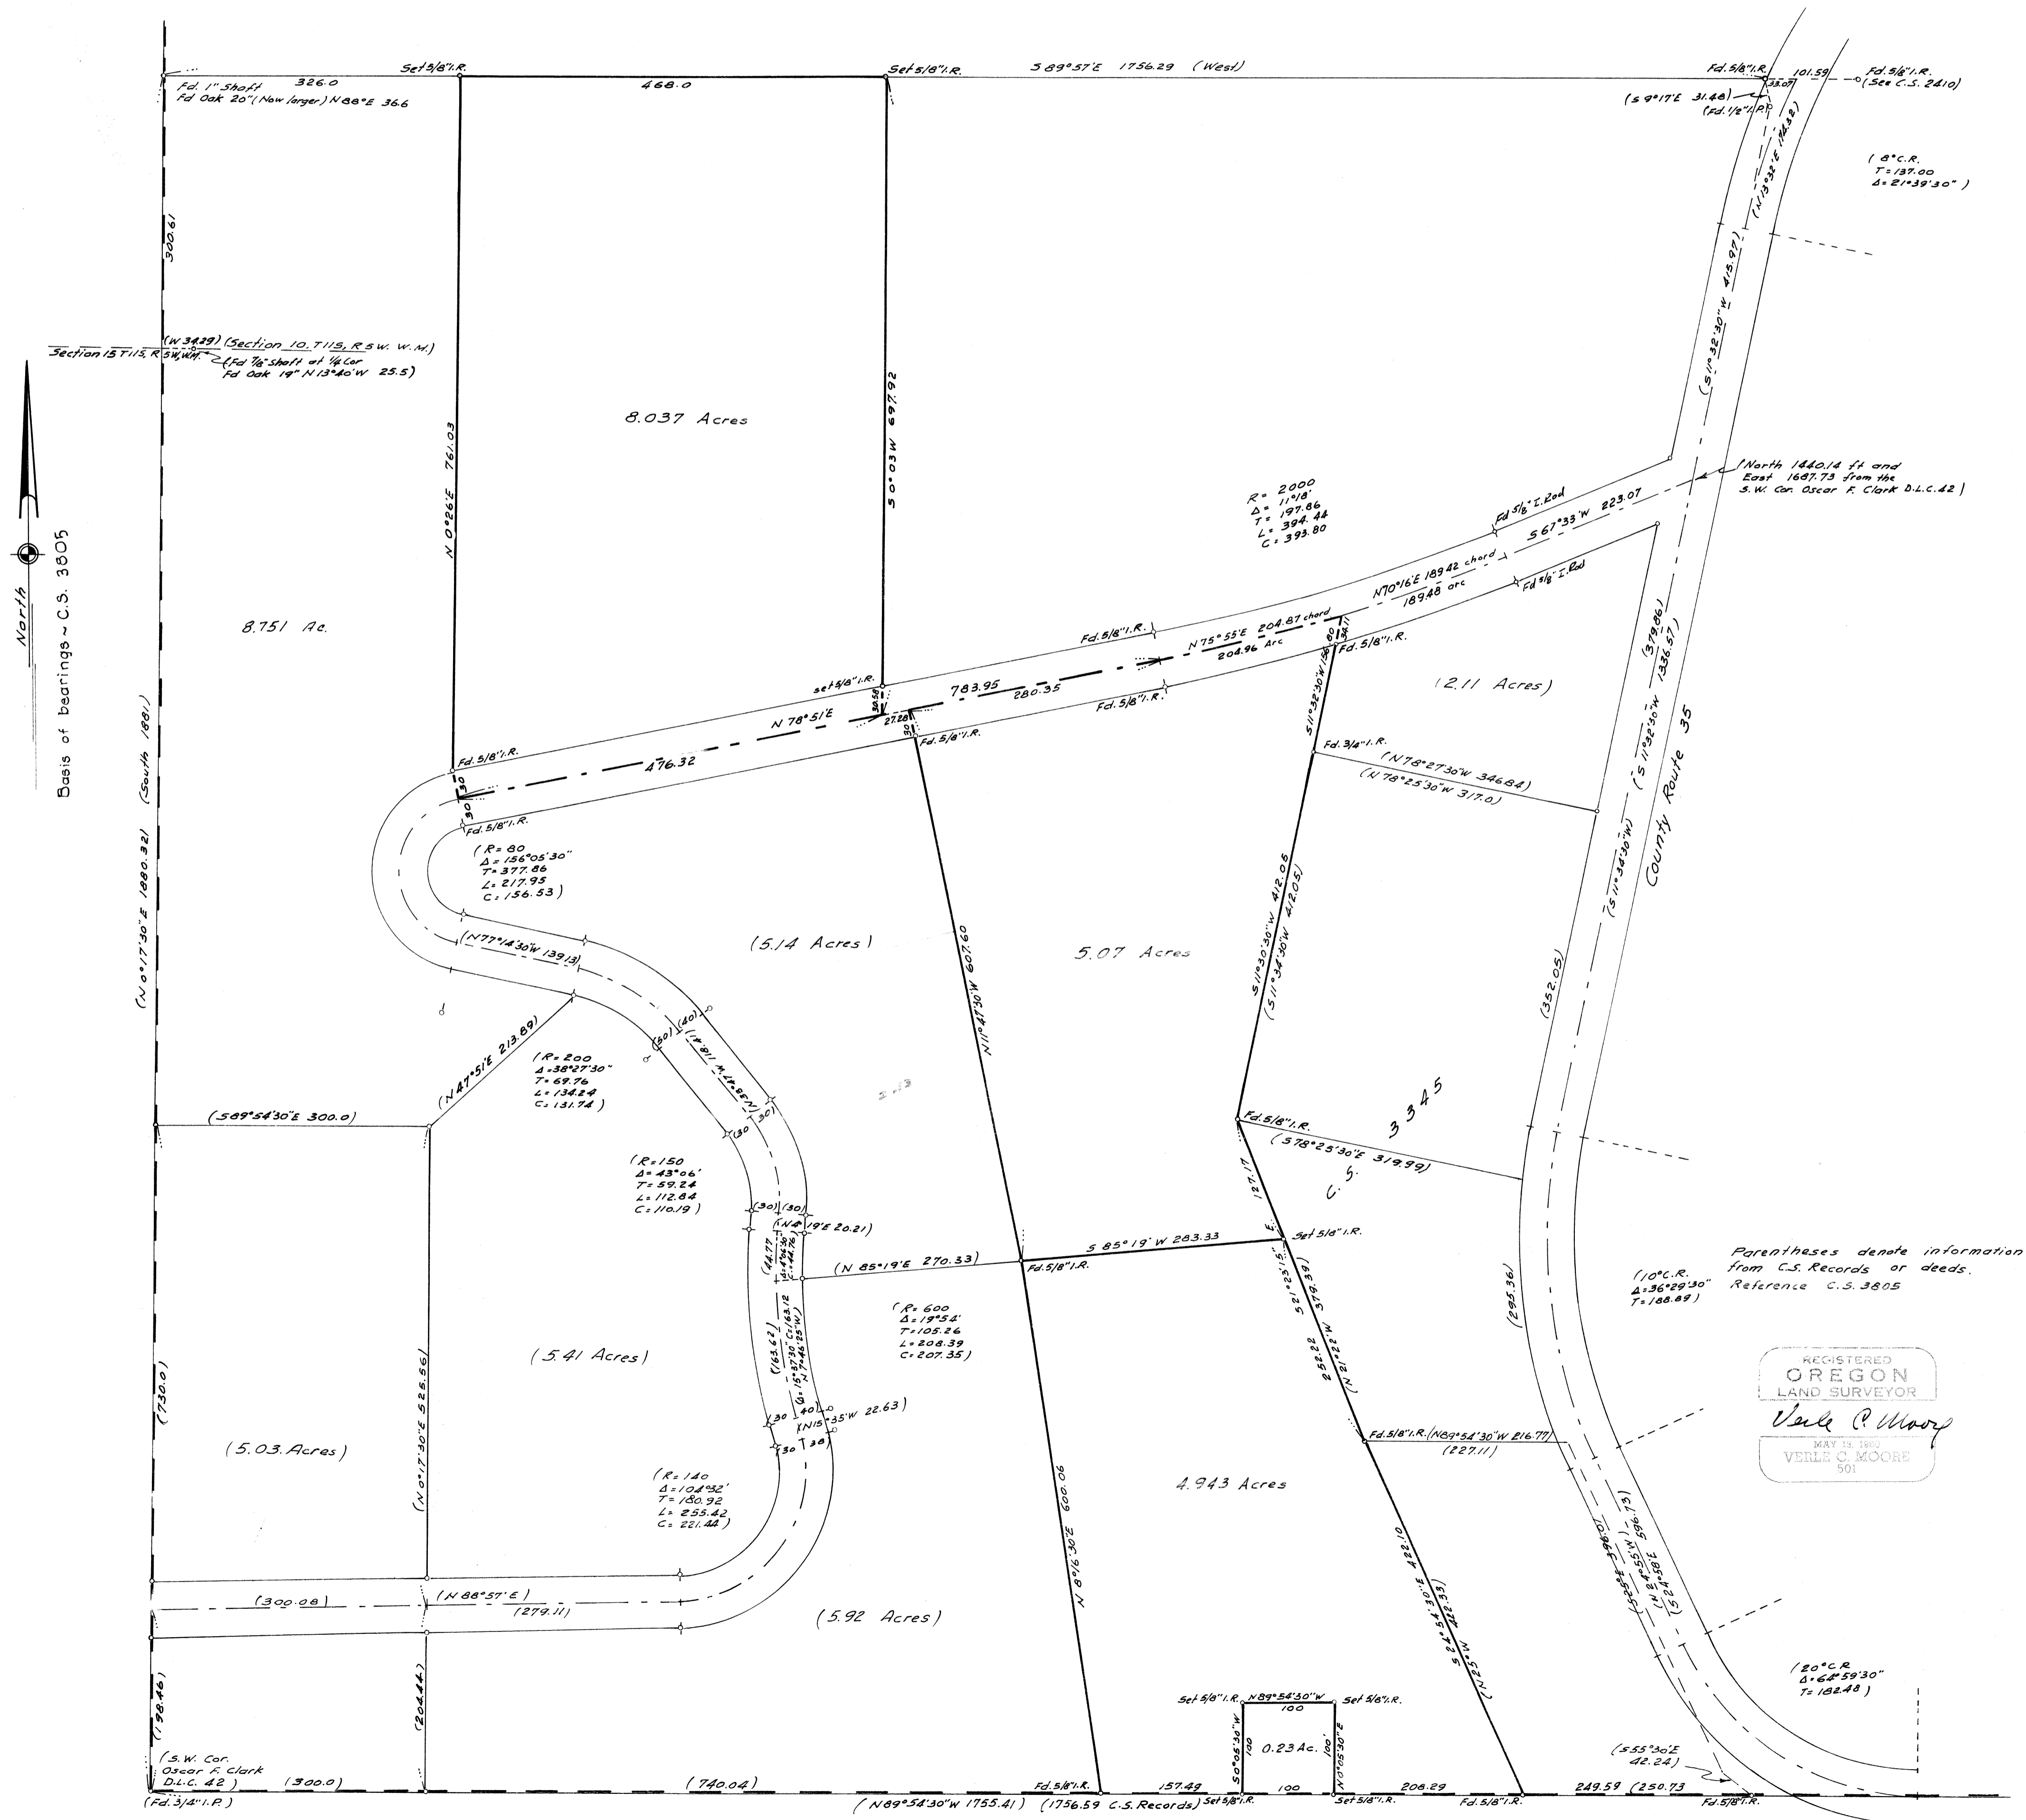

REGISTERED  
 OREGON  
 LAND SURVEYOR  
 Verle C. Moore  
 501

Parentheses denote information  
 from C.S. Records or deeds.  
 Reference C.S. 3805

North  
 Basis of bearings - C.S. 3805