


C.S. No 4035

Dean L. Tatam &
Lynn E. Abraham et. all

BLOCK 41 BROWN'S ADDITION
PHILOMATH, OREGON

Feb. 1, 1965

26

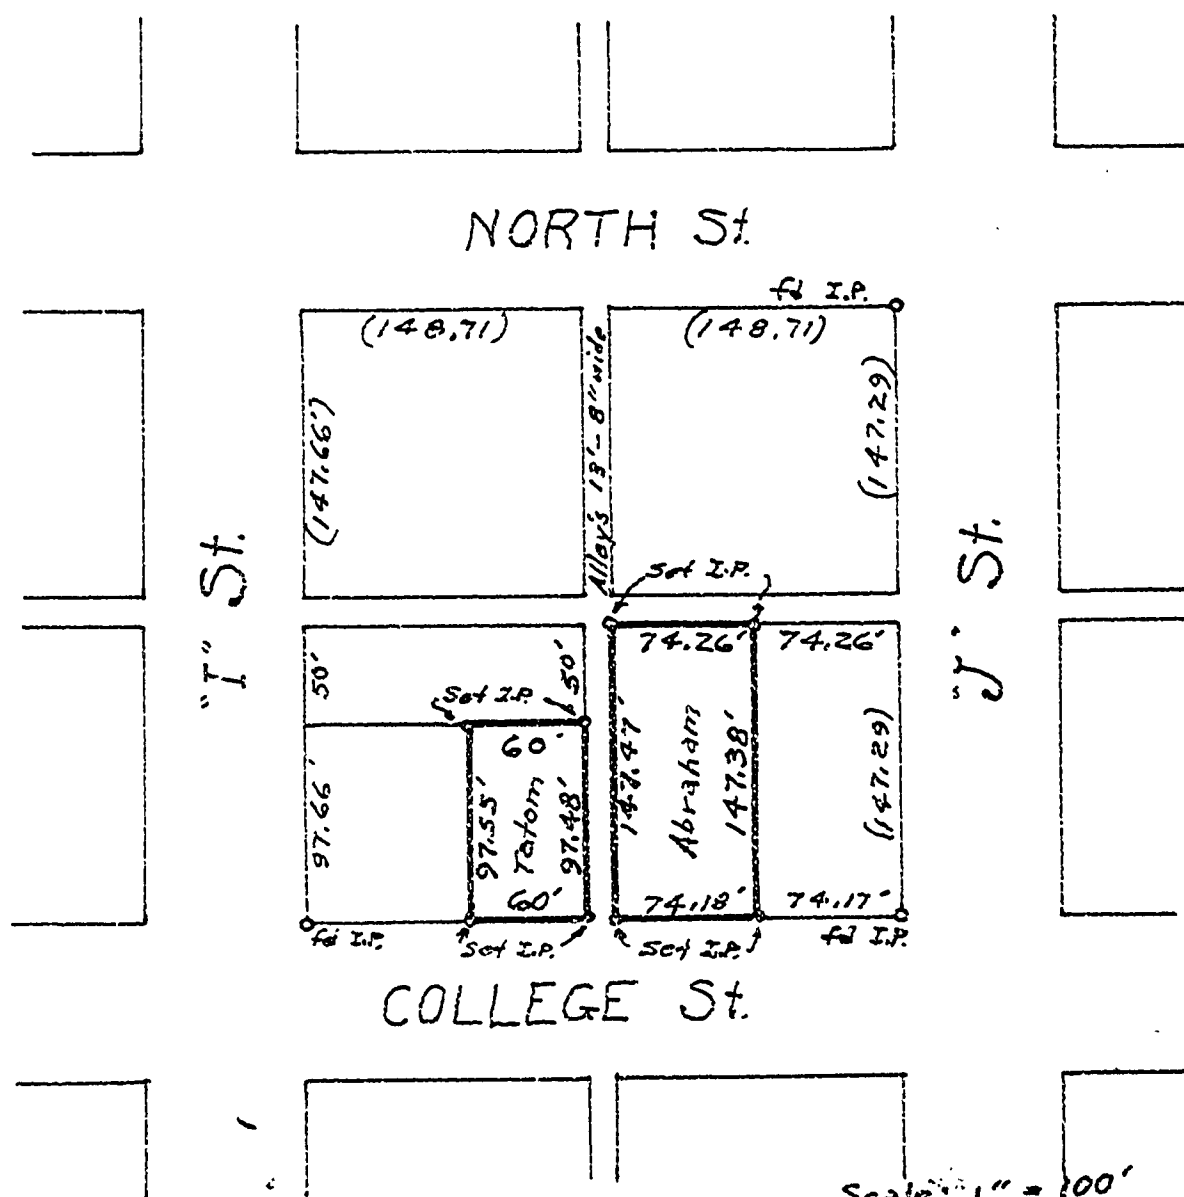

REGISTERED
OREGON
LAND SURVEYOR

Martin L. Beyerlein

NOV. 5, 1948
MARTIN L. BEYERLEIN
247