


C.S. 4139
 Record of Survey
 for
MOUNTAIN VIEW TERRACE INC.
 an Oregon Corporation
 in the
 Arnold Fuller DLC. 38
 Section 2, T.11S., R.5W. W.M.
 Benton County, Oregon
 Scale 1"=100' August 13, 1965

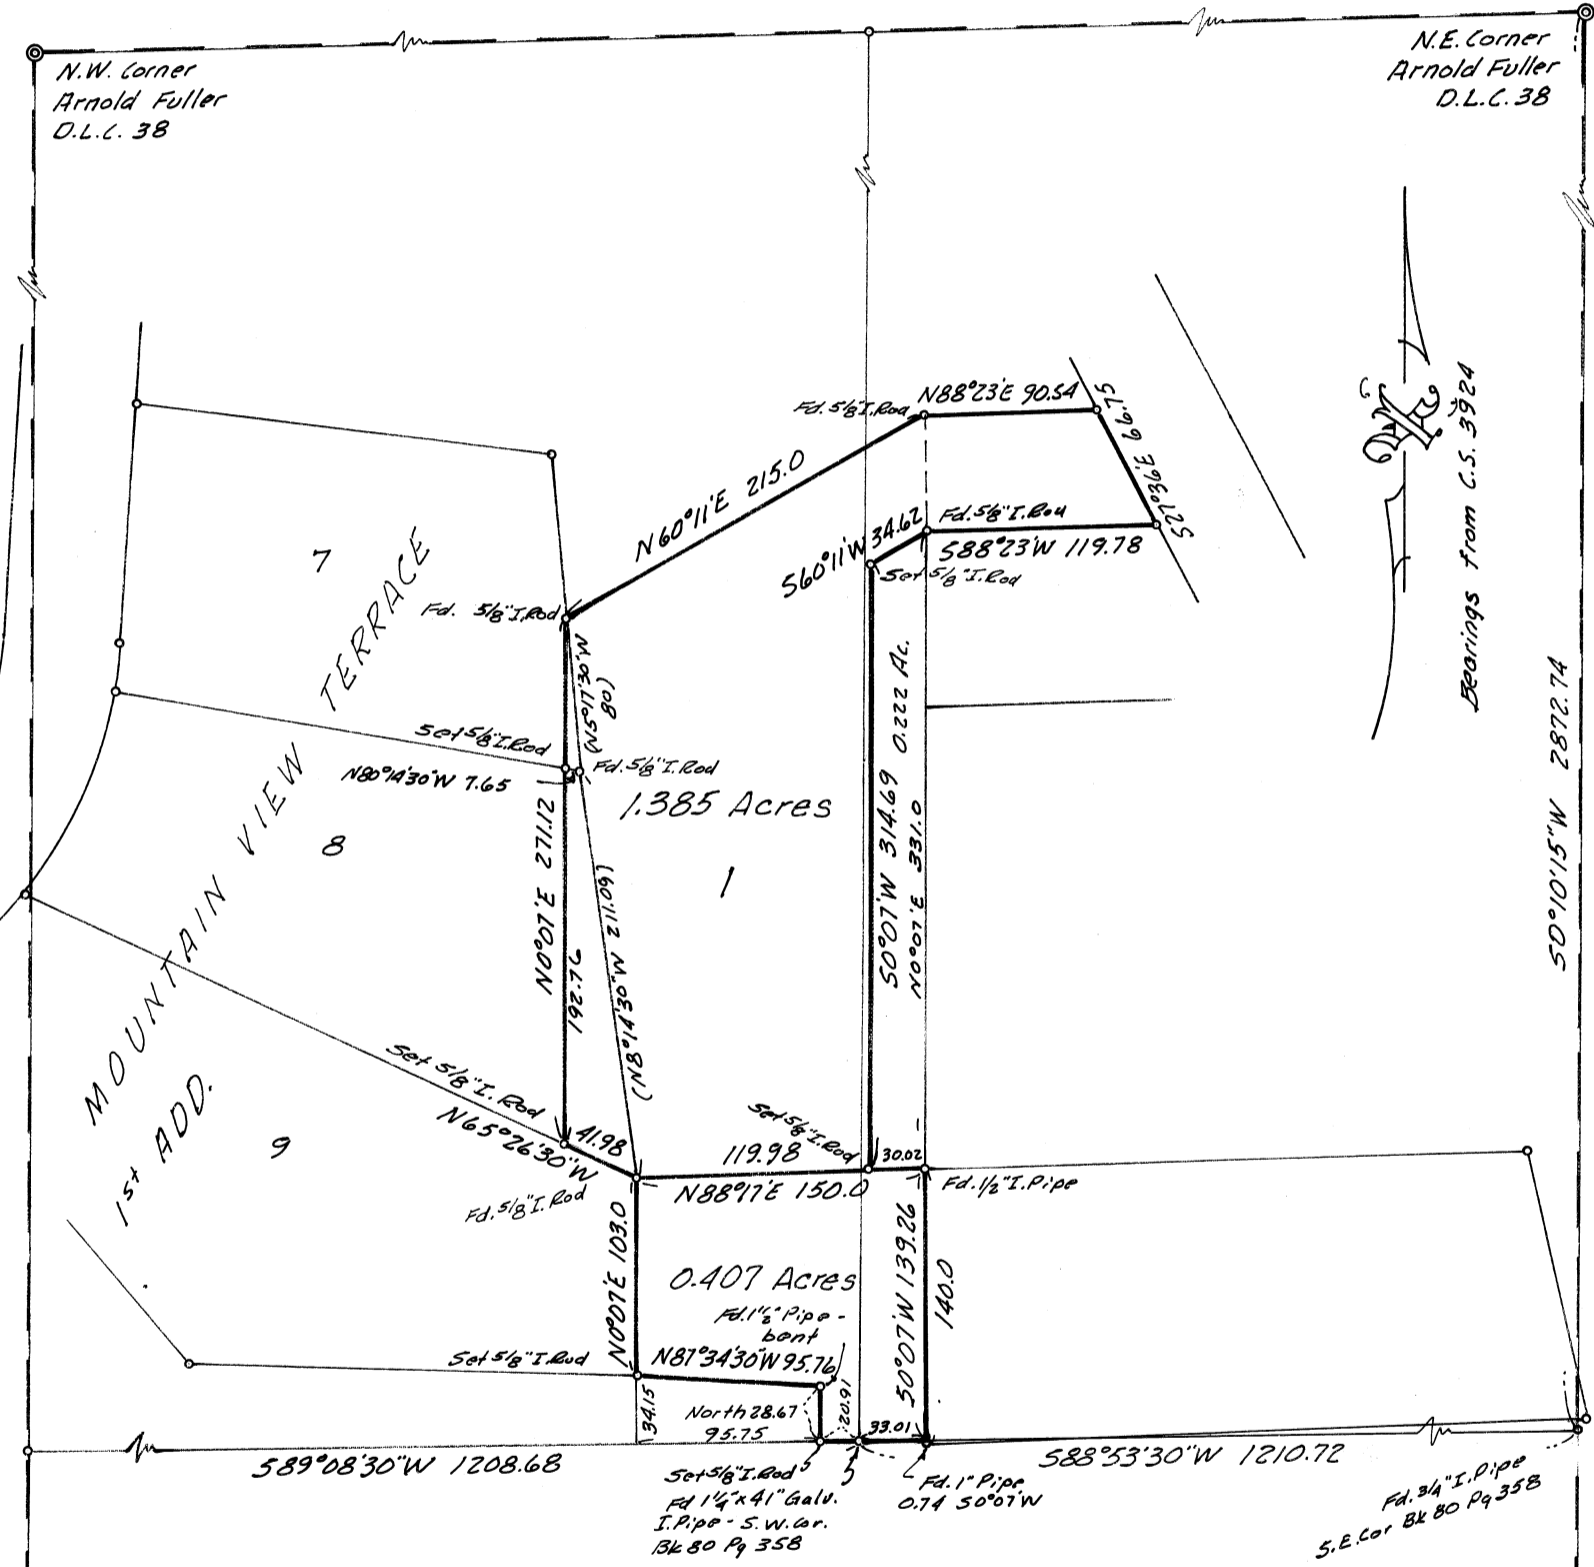

REGISTERED
OREGON
 LAND SURVEYOR
Verle C. Moore
 MAY 13, 1960
VERLE C. MOORE
 501

Re-entrant Corner
 Arnold Fuller D.L.C. 38