


C S 4206

SURVEY for RONALD K. BECKER in  
Sections 15 and 22, Township 14 South, Range 5 West, W.M.,  
Benton County, Oregon

February 16, 1966

Scale: 1 inch = 100 feet

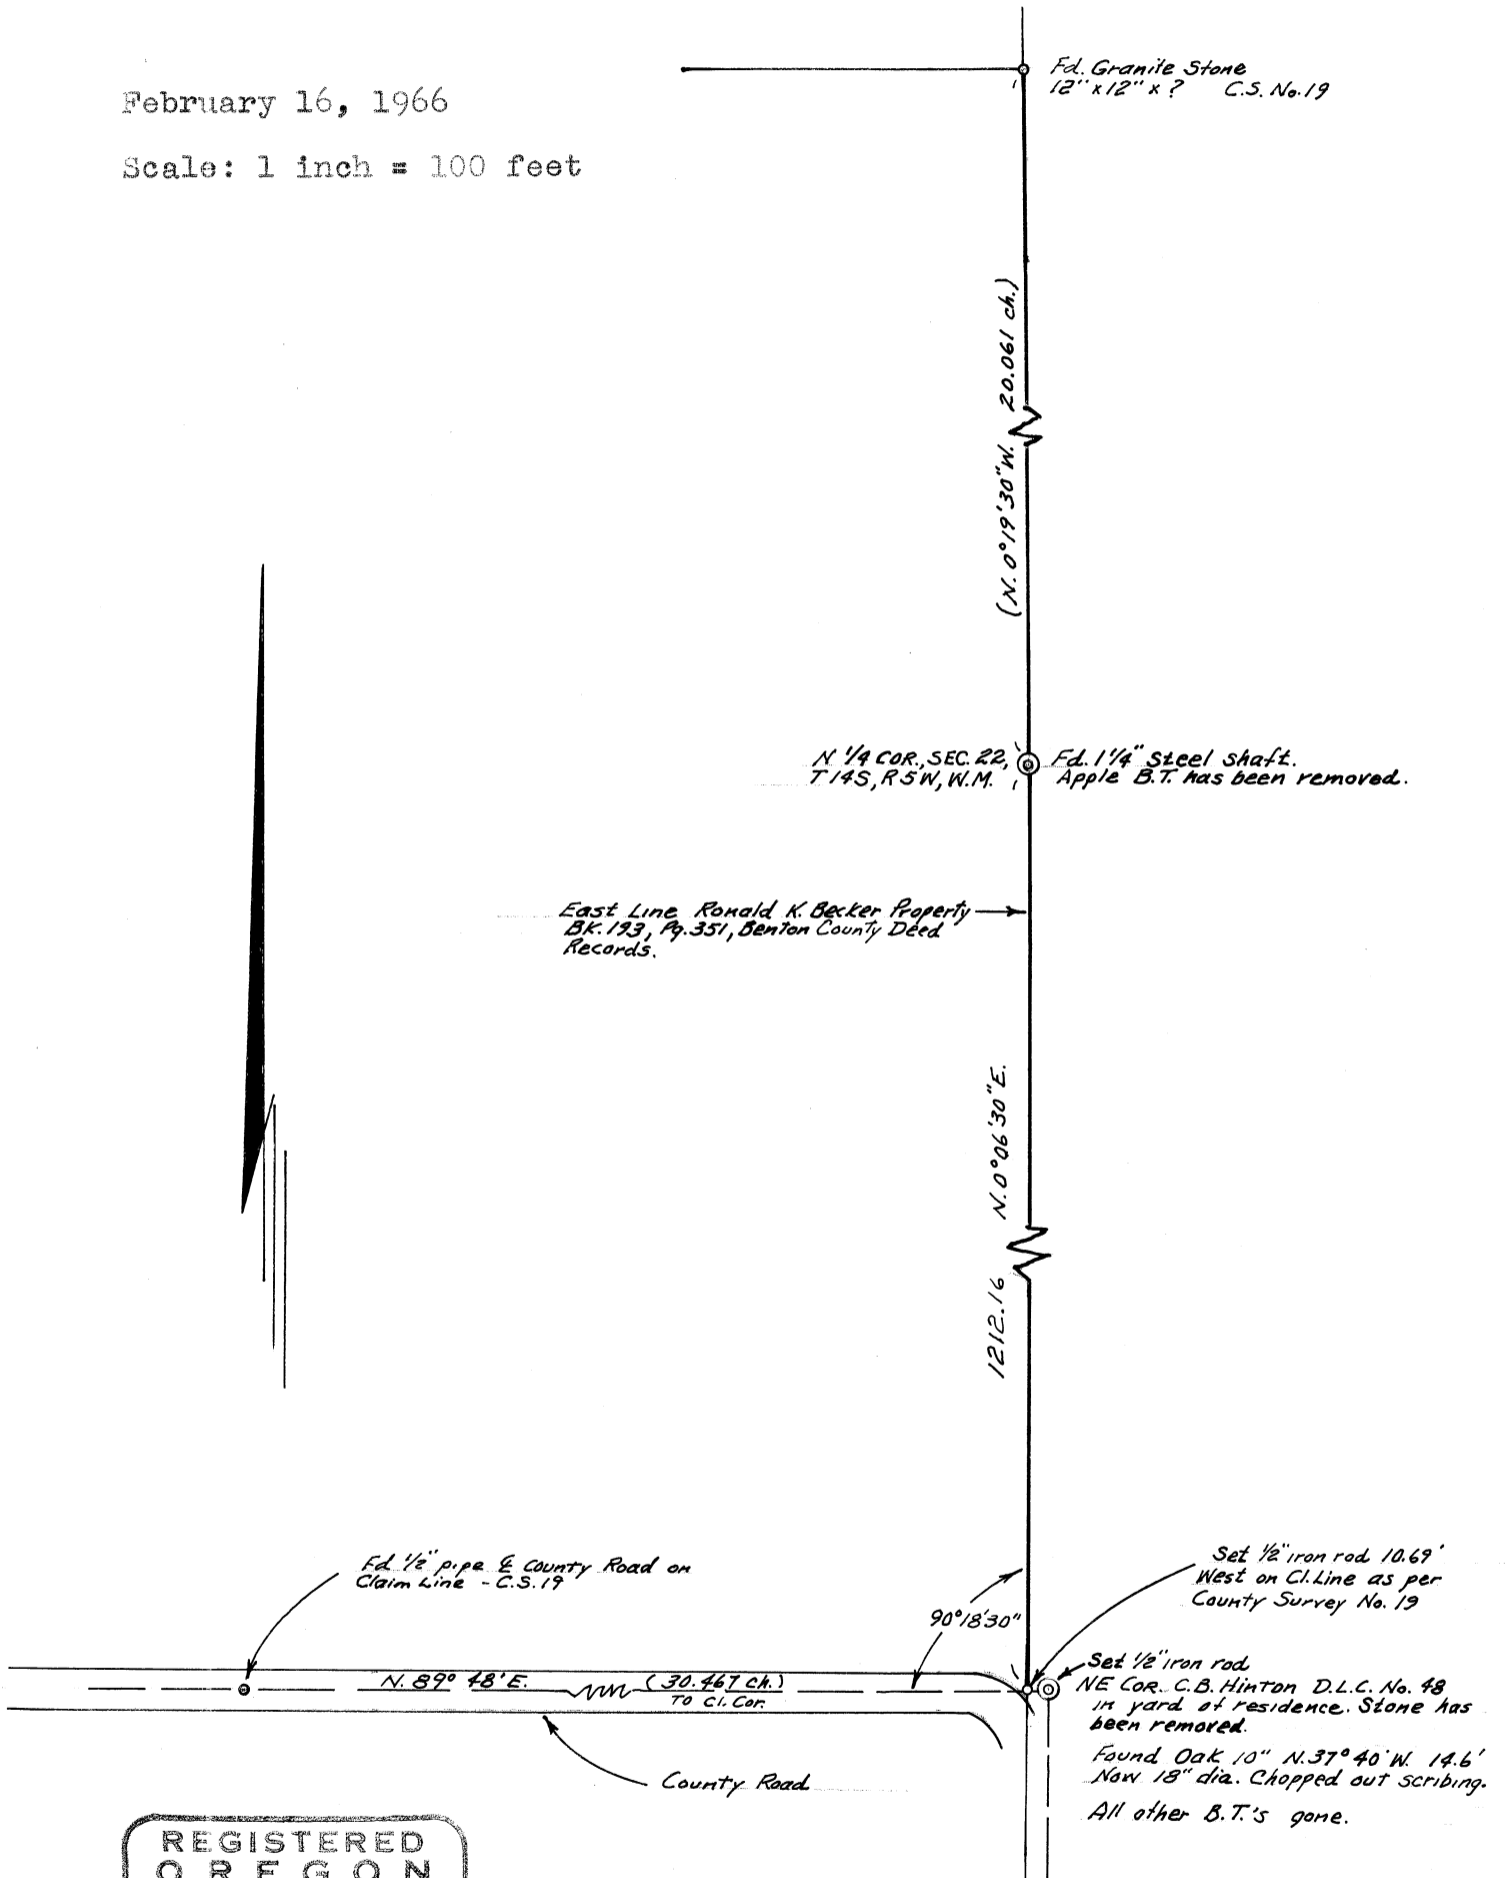

REGISTERED  
OREGON  
LAND SURVEYOR

*John F. Gannon*

JULY 12, 1963  
JOHN F. GANNON  
607