


C 5 4230
 Record of Survey
 for
 HOWARD CARPENTER
 in the
 Gallatin Adkins D.L.C. 43, T.10S., R.4W. W.M.
 Section 36
 Benton County, Oregon
 Scale: 1"=100' January 22, 1966

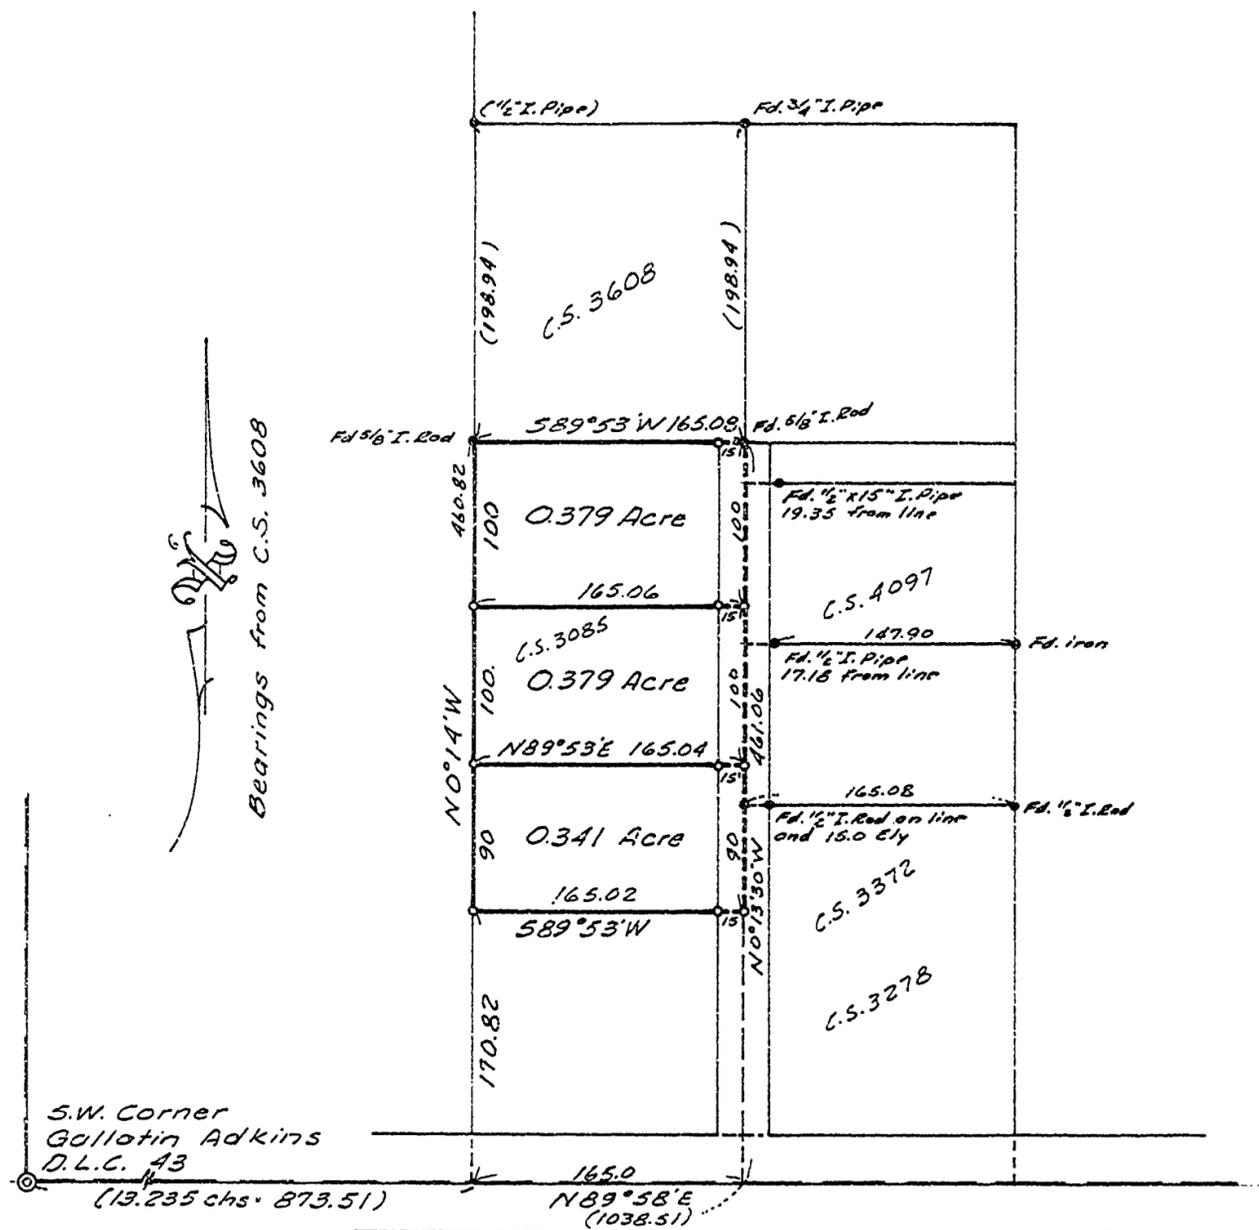

o Denotes Set $\frac{5}{8}$ "x30" re-enforcing steel rod

Parentheses denote information from
C.S. Records

REGISTERED
 OREGON
 LAND SURVEYOR

Verle C. Moore

MAY 13, 1960
 VERLE C. MOORE
 501