


C.S. 4335

Improvement Location Survey
for
FIRST FEDERAL SAVINGS & LOAN ASSN
Re: Jake Prince, Jr.
in
PRINCETON HEIGHTS SUBDIVISION
Section 26, T.10 S., R.4 W., W.B. & M.
Benton County, Oregon

Scale: 1" = 20' October 6, 1966

Parentheses denote information
from plat of Princeton Heights
Subdivision

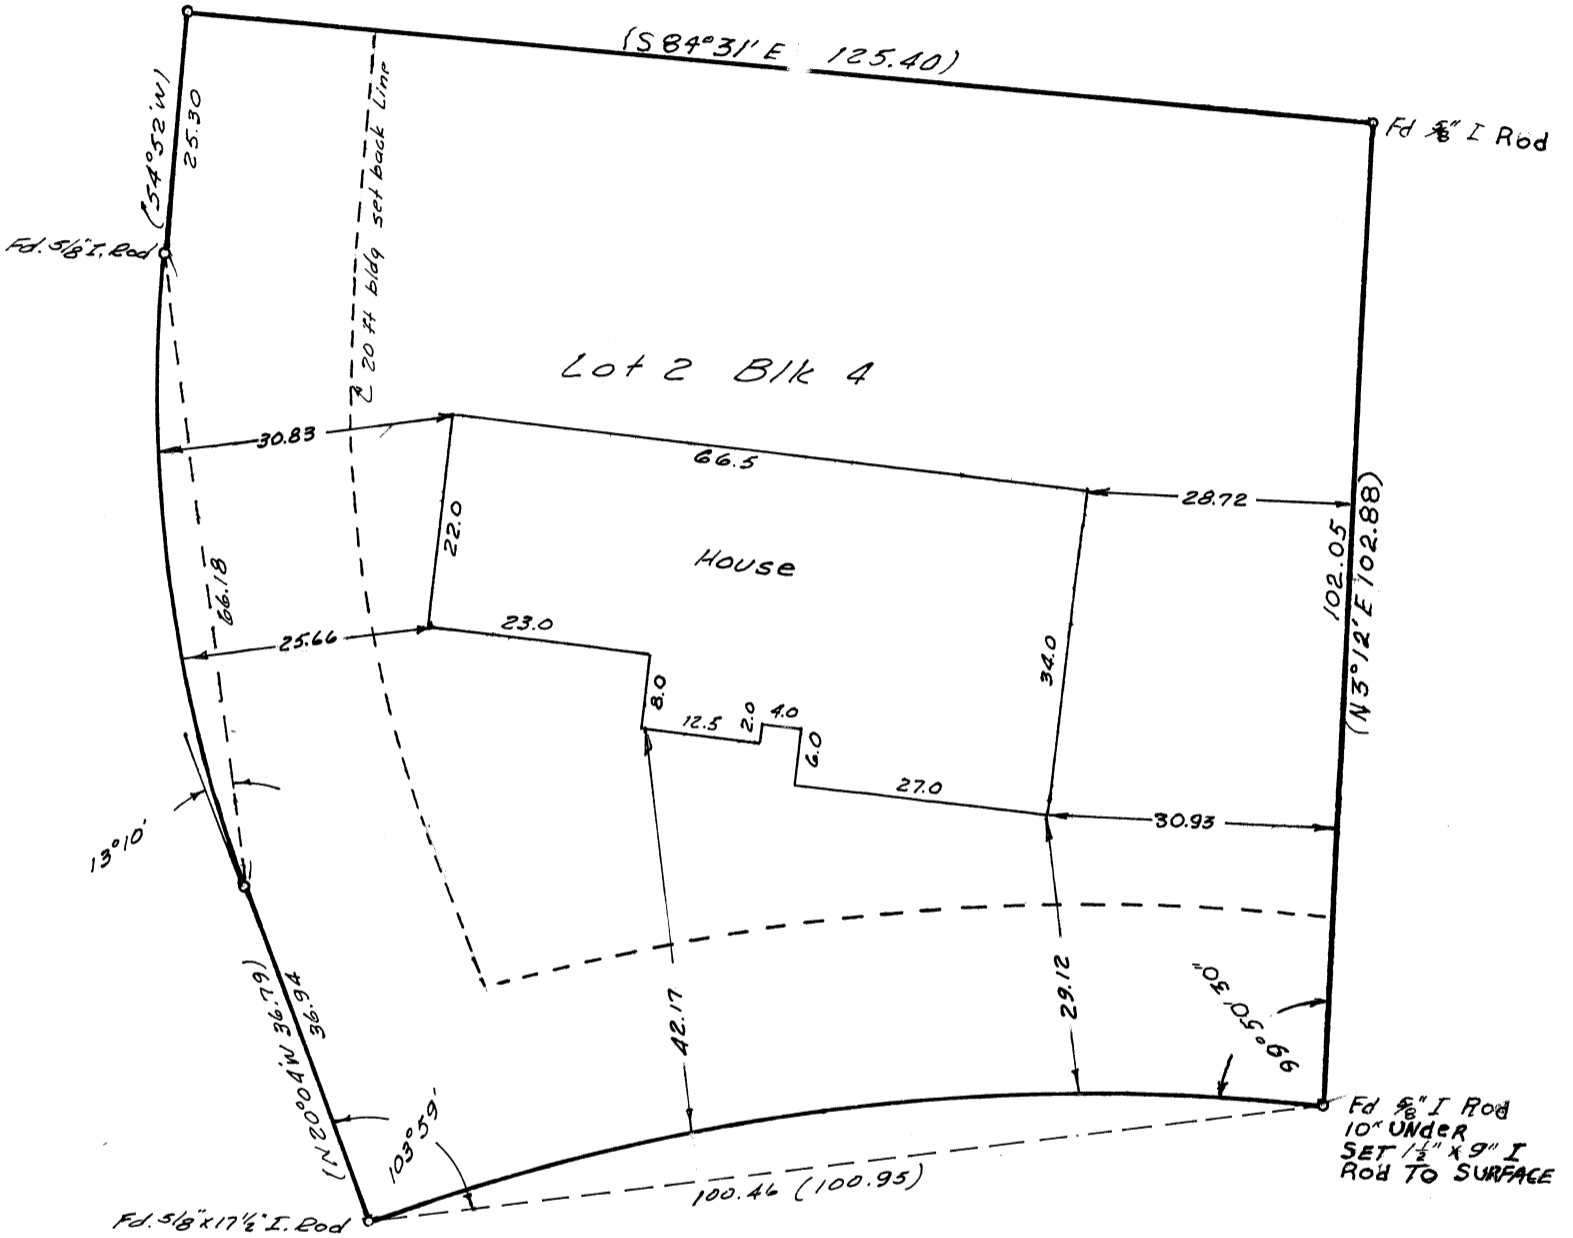

DESCRIPTION: Lot 2, Block 4, PRINCETON HEIGHTS
SUBDIVISION

CERTIFICATE: I hereby certify that I find the
improvements made on the above described
property to be on the premises in
question and that they do not overlap or
encroach on the property lying adjacent
thereto.

Handwritten signature/initials

REGISTERED
OREGON
LAND SURVEYOR

Verle C. Moore

MAY 13, 1966
VERLE C. MOORE
501