

C 5 4360



SURVEY FOR

# PROPOSED HIGH SCHOOL SITE

IN JOHN ROBINSON D.L.C. # 44 AND OSCAR F. CLARK D.L.C. # 42  
SECTION 15, TOWNSHIP II SOUTH, RANGE 5 WEST, WILLAMETTE  
BENTON COUNTY OREGON

SCALE: 1" = 200'

DATE: 3/22/67

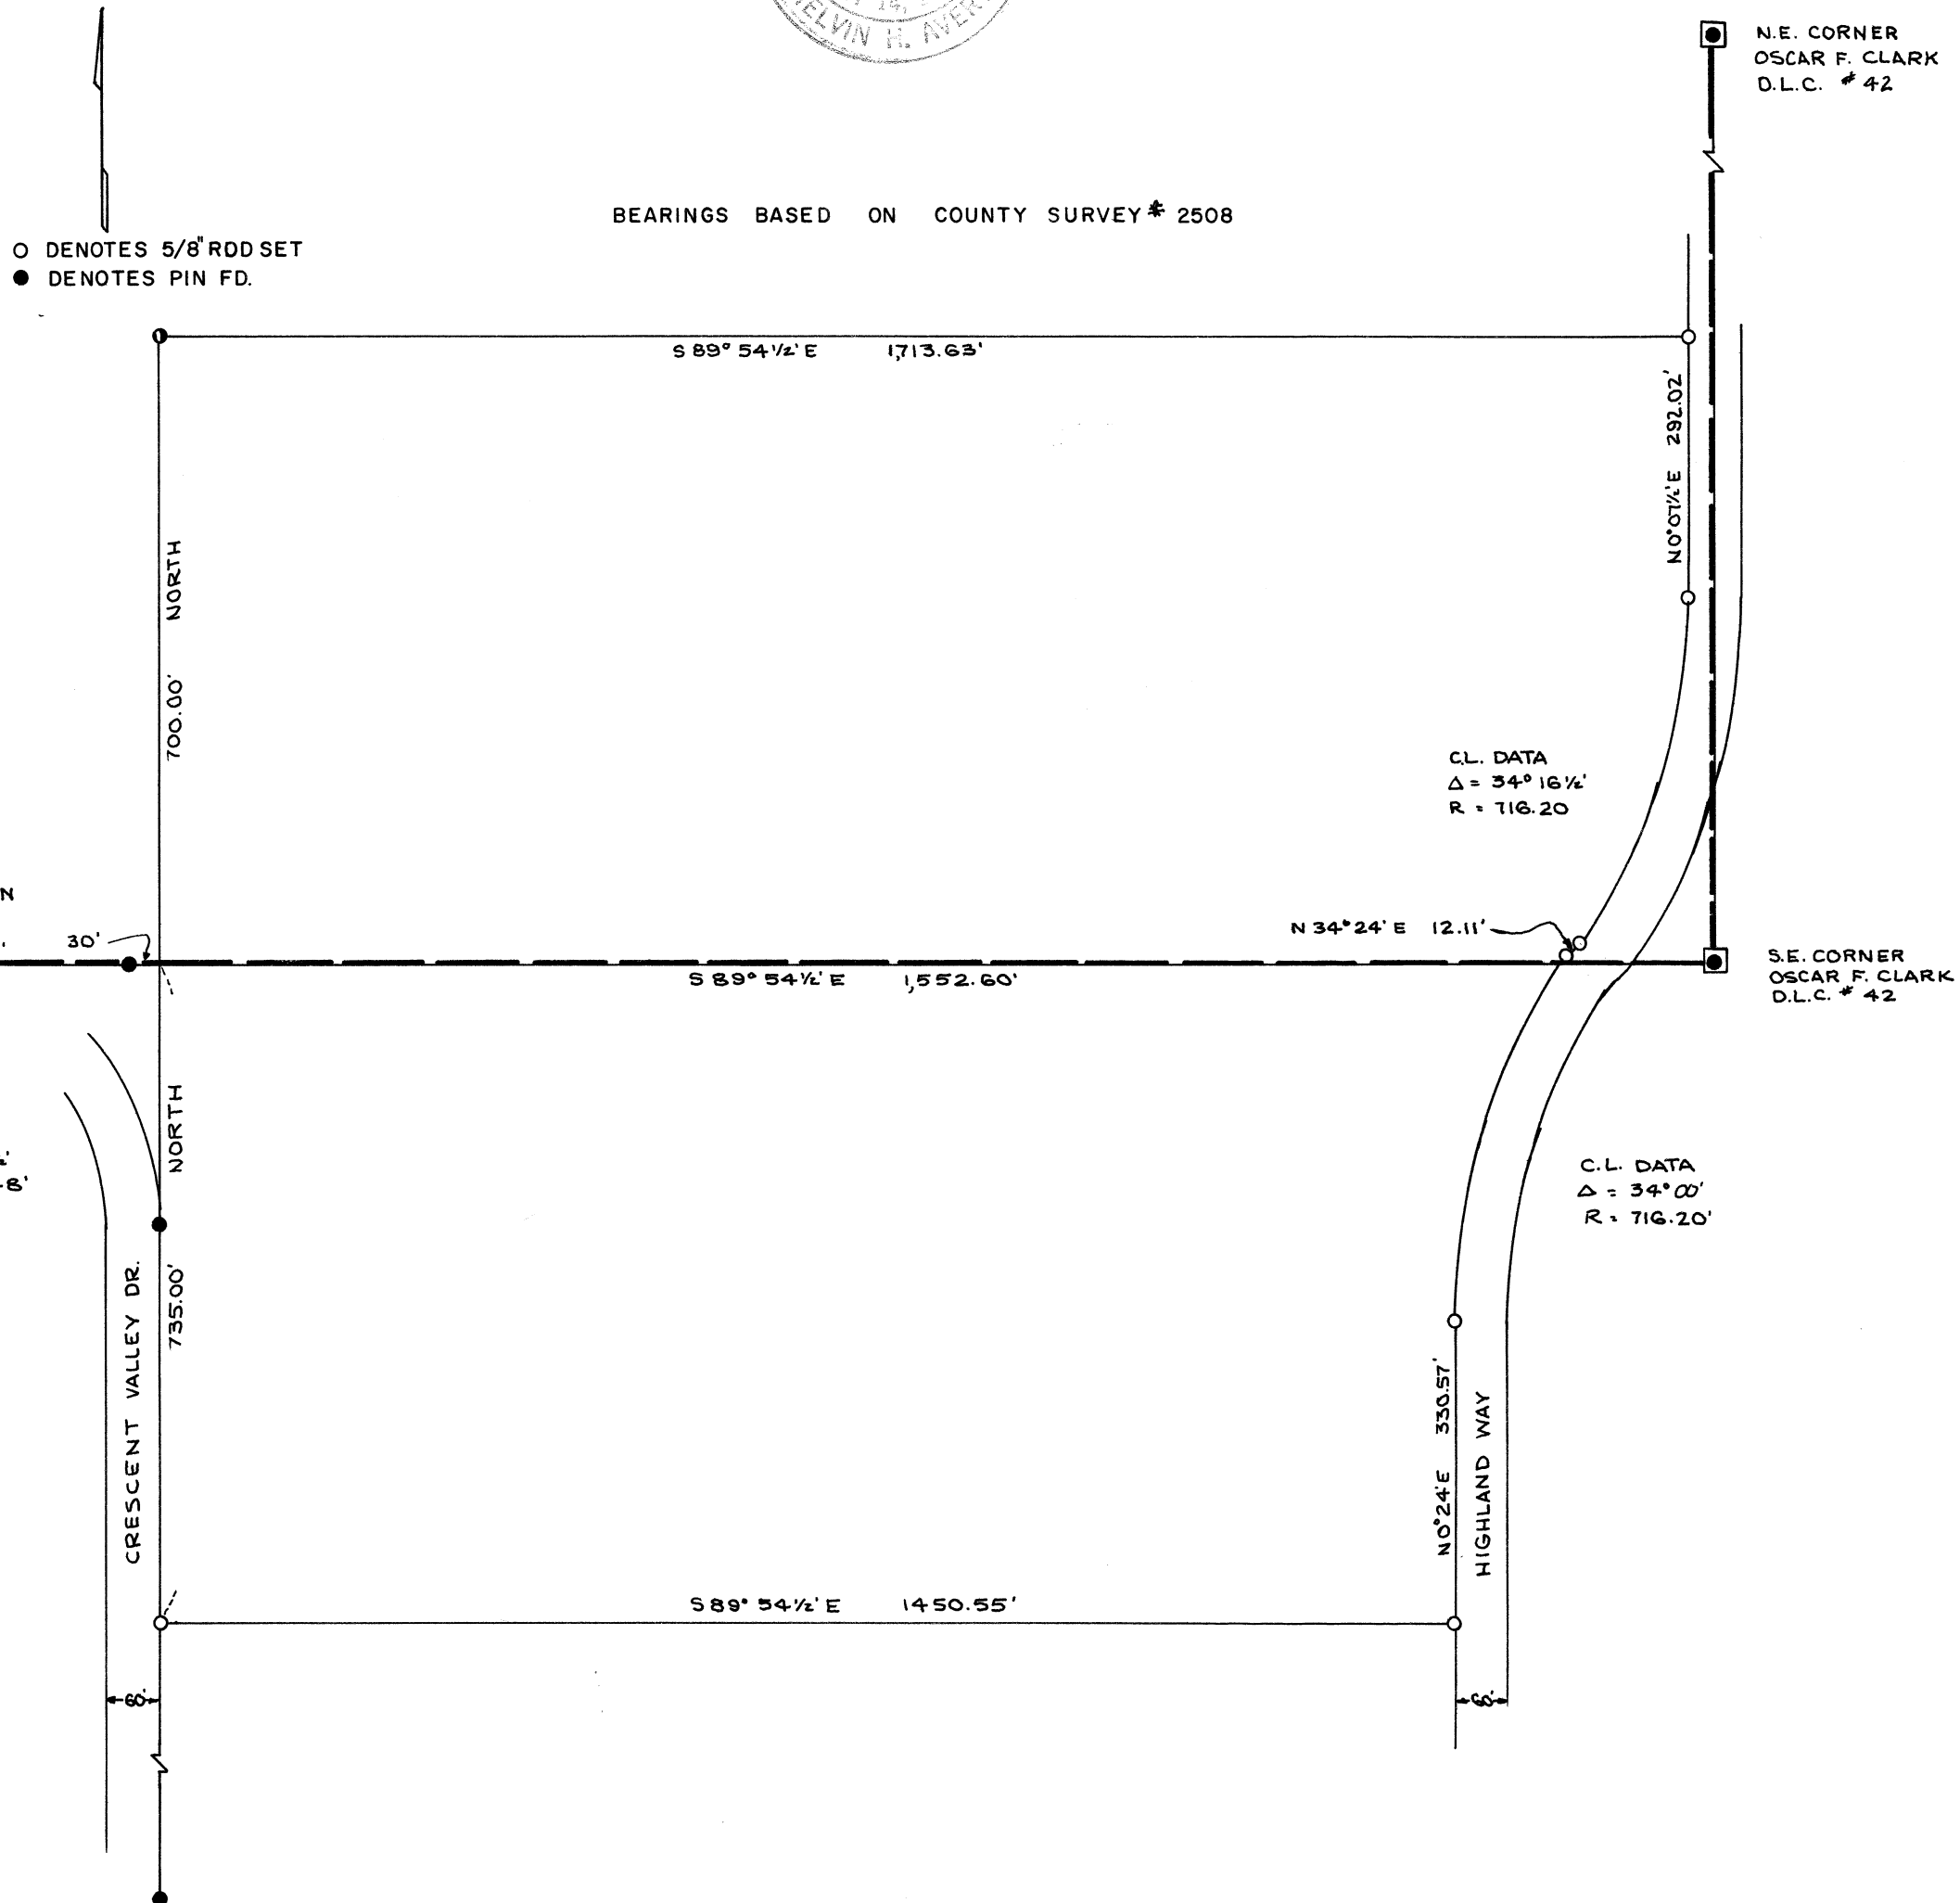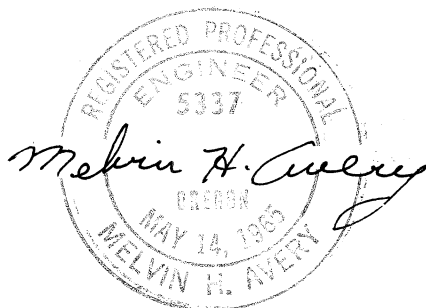

4360