


O DENOTES 5/8" ROD SET

NOTE:

BEARINGS BASED ON C.S. # 195

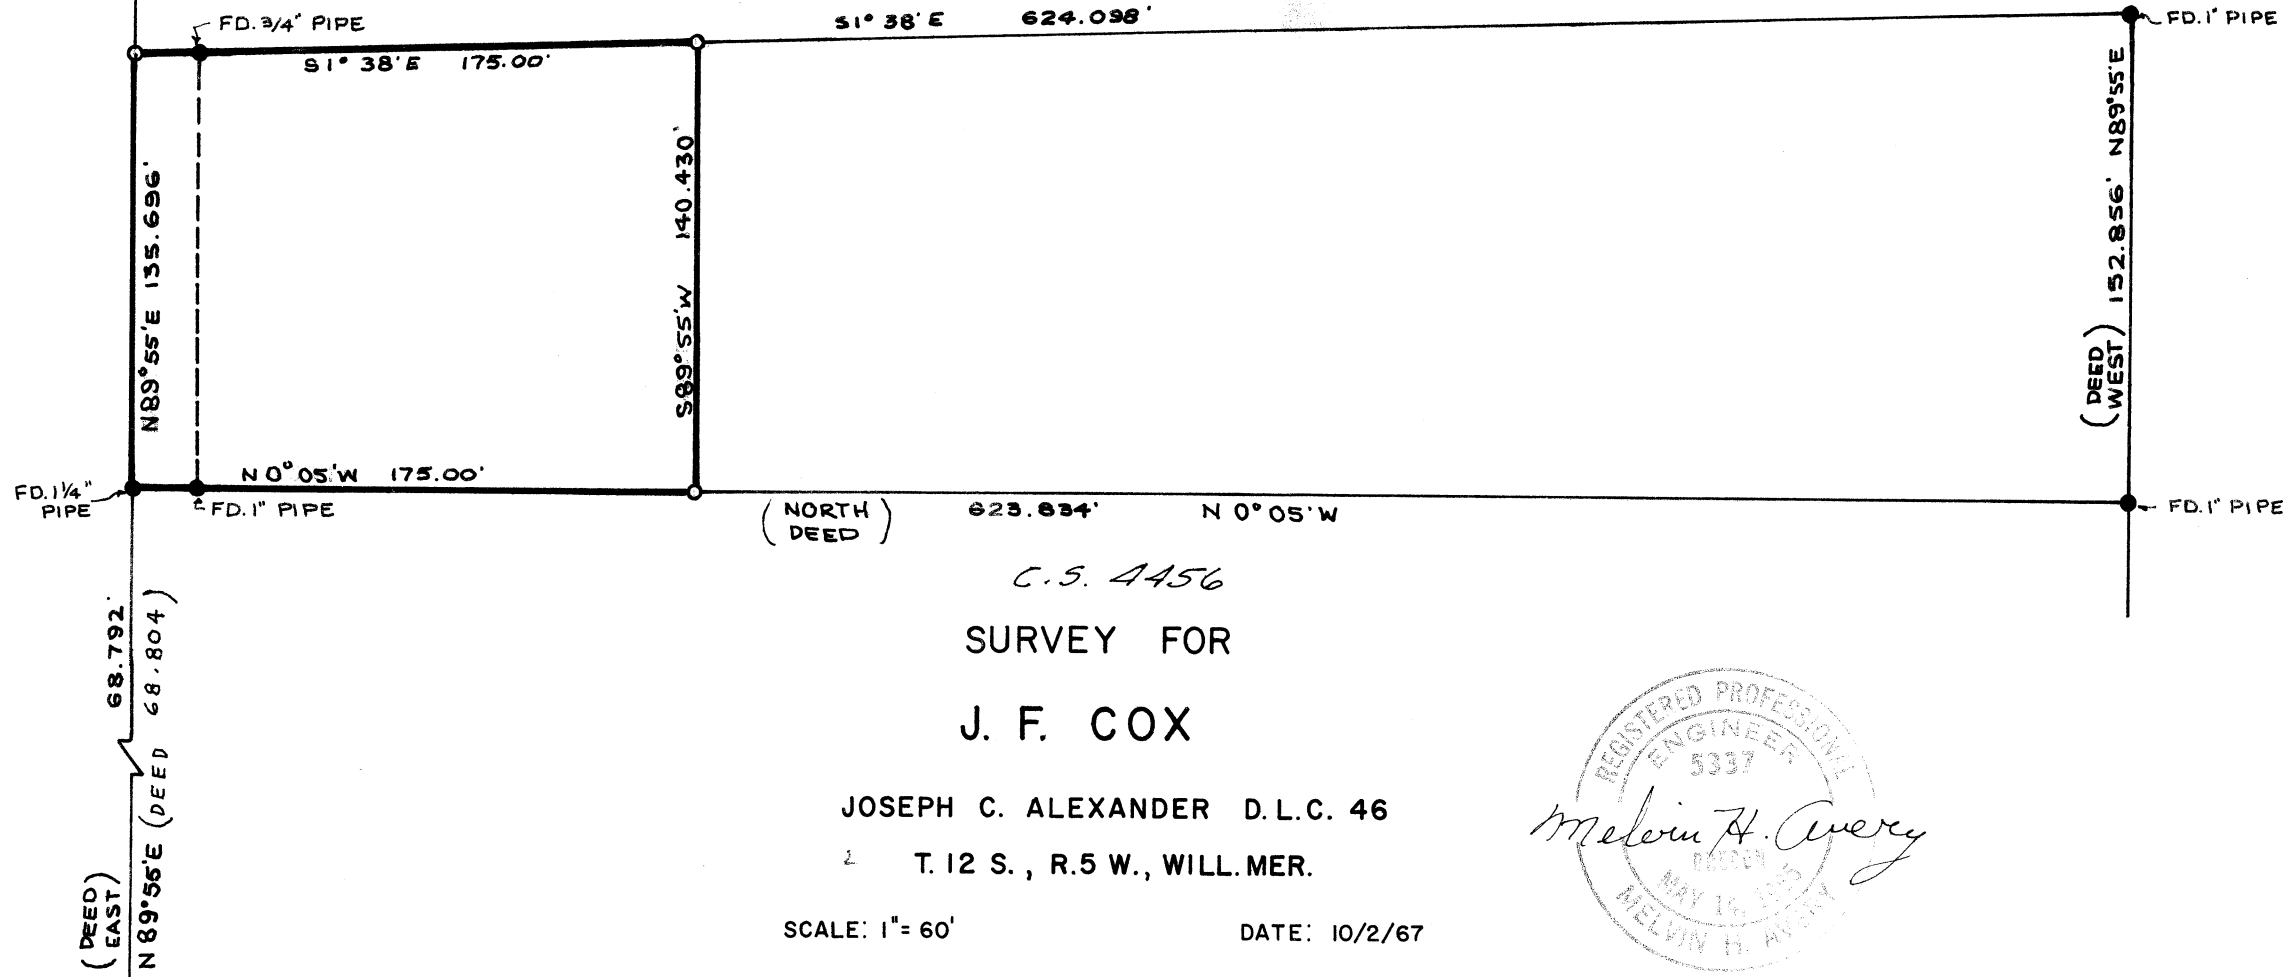

(NORTH DEED) 623.834' N 0° 05' W

C.S. 4456
SURVEY FOR
J. F. COX

JOSEPH C. ALEXANDER D.L.C. 46
T. 12 S., R. 5 W., WILL. MER.

SCALE: 1" = 60'

DATE: 10/2/67



(DEED EAST)
N 89° 55' E (DEED 68.804)
68.792'

N 89° 55' E 135.696'

FD. 3/4" PIPE

S 1° 38' E 175.00'

S 89° 55' W 140.430'

N 0° 05' W 175.00'

FD. 1" PIPE

(NORTH DEED)

(DEED WEST) 152.856' N 89° 55' E

FD. 1" PIPE

FD. 1" PIPE

N.W. COR. JOS. C. ALEXANDER
DONATION LAND CLAIM NO. 46