

Fd. 3/4" Pipe

29 ch

CS 4483

ALVIN HAMM SEC. 10 T.12S. R6W

JAN. 1968

SCALE 1" = 200'


Bert W. Ubell R.P.E. # 2301

Chained 1689.8 (25.30chs)

Set 3/4" pipe at cor
and 5/8" Rod 10' South
N89°23'E

300.00

Set 5/8" Rod

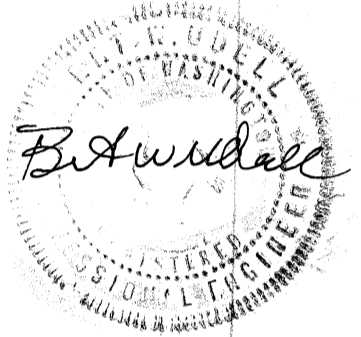

10.0ac. ±

N0°37'W
1318.94

1051.49
N0°37'W

Set 5/8" Rod
at Top of
slide.

N48°41'W
401.25

Fd. 3/4" pipe
135.56
N88°15'E

Fd. 3/4" pipe
N89°50'E

462.93
C.S. No. 65

Fd. 1/2" pipe
307.43

Fd. 1/2" pipe

NW Cor.
T. J. Blair
DLC #68

(26.035 ch)
CS No. 65