

4662

SURVEY FOR
WAYNE ALLEN


Lot 8, Block 3

Rose Park Subdivision

Philomath, Oregon

Scale: 1"=50

Date: April 7, 1967

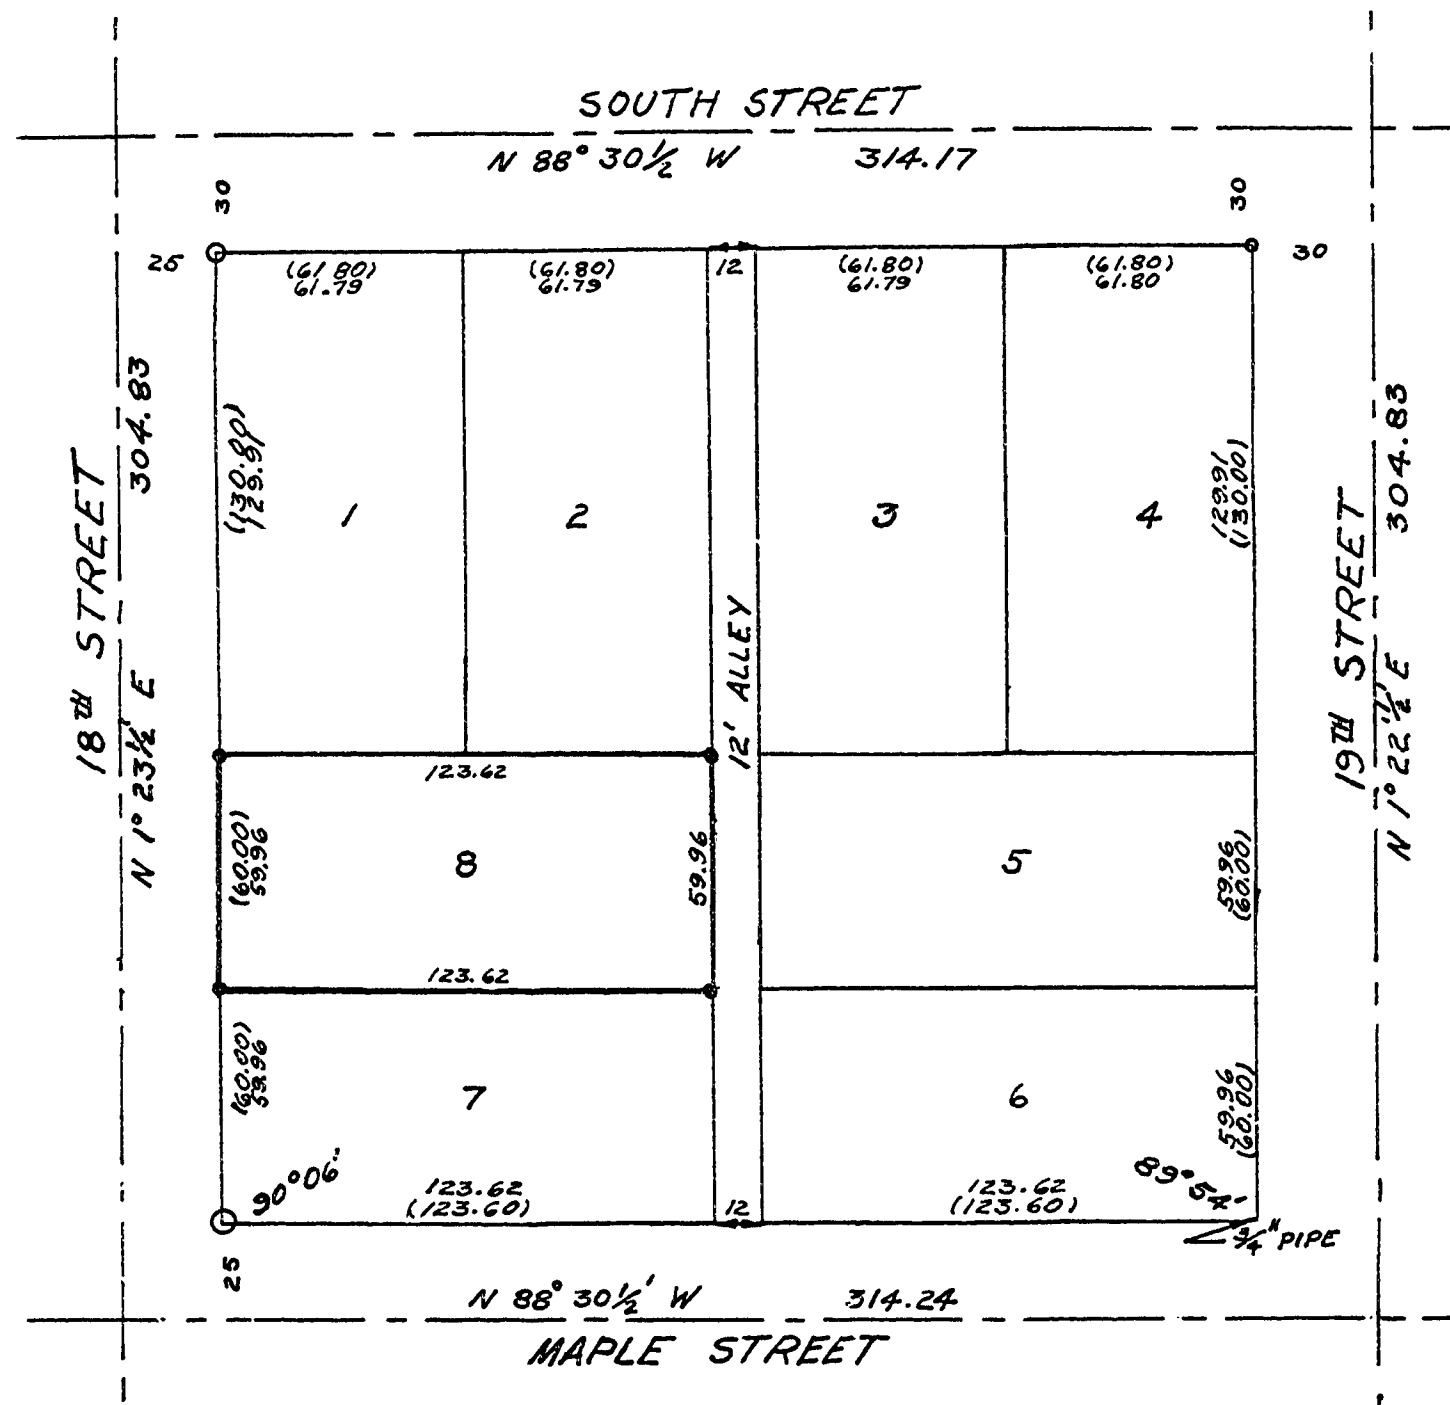

- DENOTES $\frac{5}{8}$ ROD FOUND
- DENOTES $\frac{3}{4}$ " PIPE FOUND
- DENOTES $\frac{1}{2}$ " PIPE SET

REGISTERED
PROFESSIONAL
LAND SURVEYOR

Fred J. Leake

OREGON
MAY 2, 1966
FRED J. LEAKE
443