

C.S. # 469

Hardcopy City Plat # 8

also see notes in file

F. B. 17-62

Book #17

MENING
TRANSIT BOOK
363

17

Byron Taylor City
Miscellaneous


357.68
50.10
335.58
30.447
304.1407
35.473
115.470
140.89
41.888
76.67
76.31



#469

Q. MOIROC

4
 1
 2
 3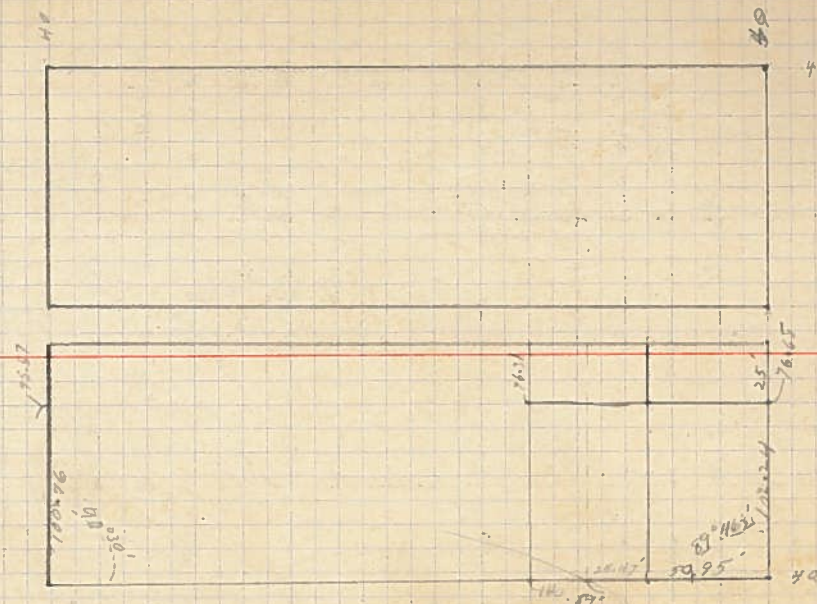
Q. 3rd ST 3.8568

Q. MADISON

1
 2
 3
 30