


4719

SURVEY FOR
Earl Jondahl
LOT 6, BLOCK 4 ROSE PARK SUBDIVISION
PHILOMATH, BENTON COUNTY, OREGON
(IN LOTS 3 & 4, BROWN'S ADDITION)

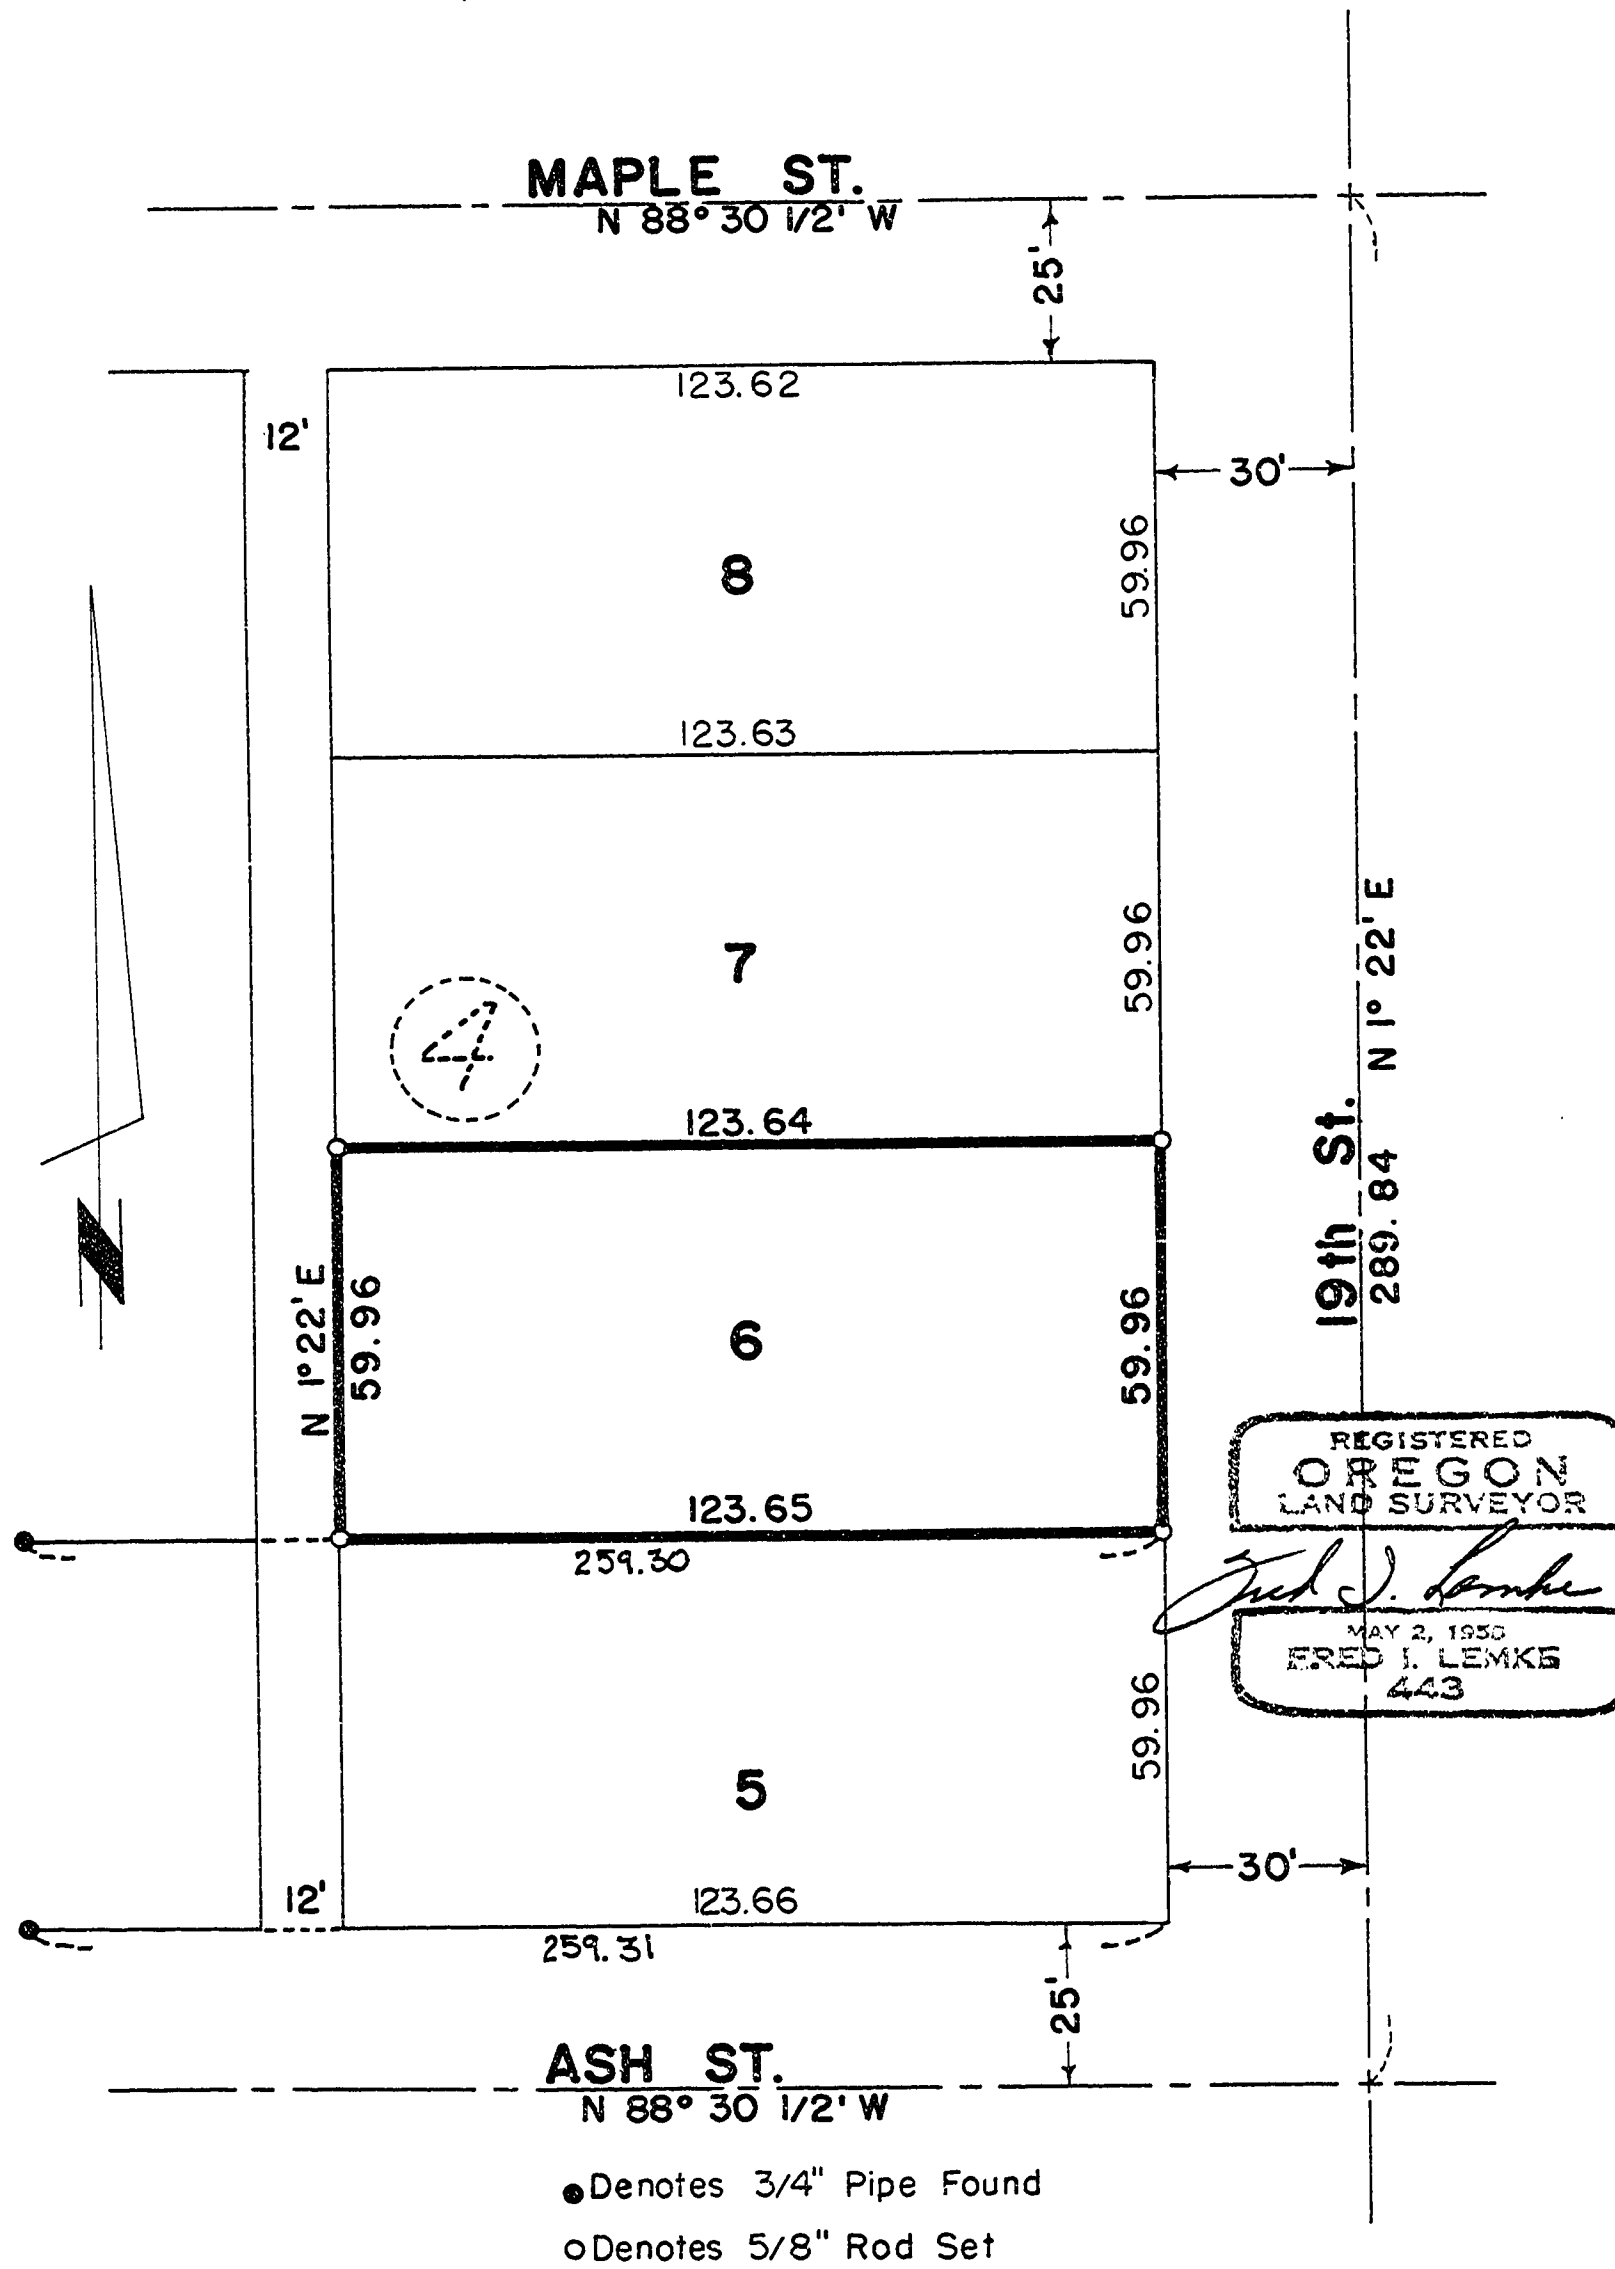

February 26, 1969

Scale: 1" = 30'