

4904

RECORD OF SURVEY

FURTICK - SAWIN

Sec. 10, T. 12S., R. 5 W., W.M.

Benton County, Oregon


Scale: 1" = 100' May 28, 1970

REGISTERED
OREGON
LAND SURVEYOR

Nickolas A. Yinger

JULY 12, 1968
NICKOLAS A. YINGER
876

Ref. C.S. 2682 - 2727

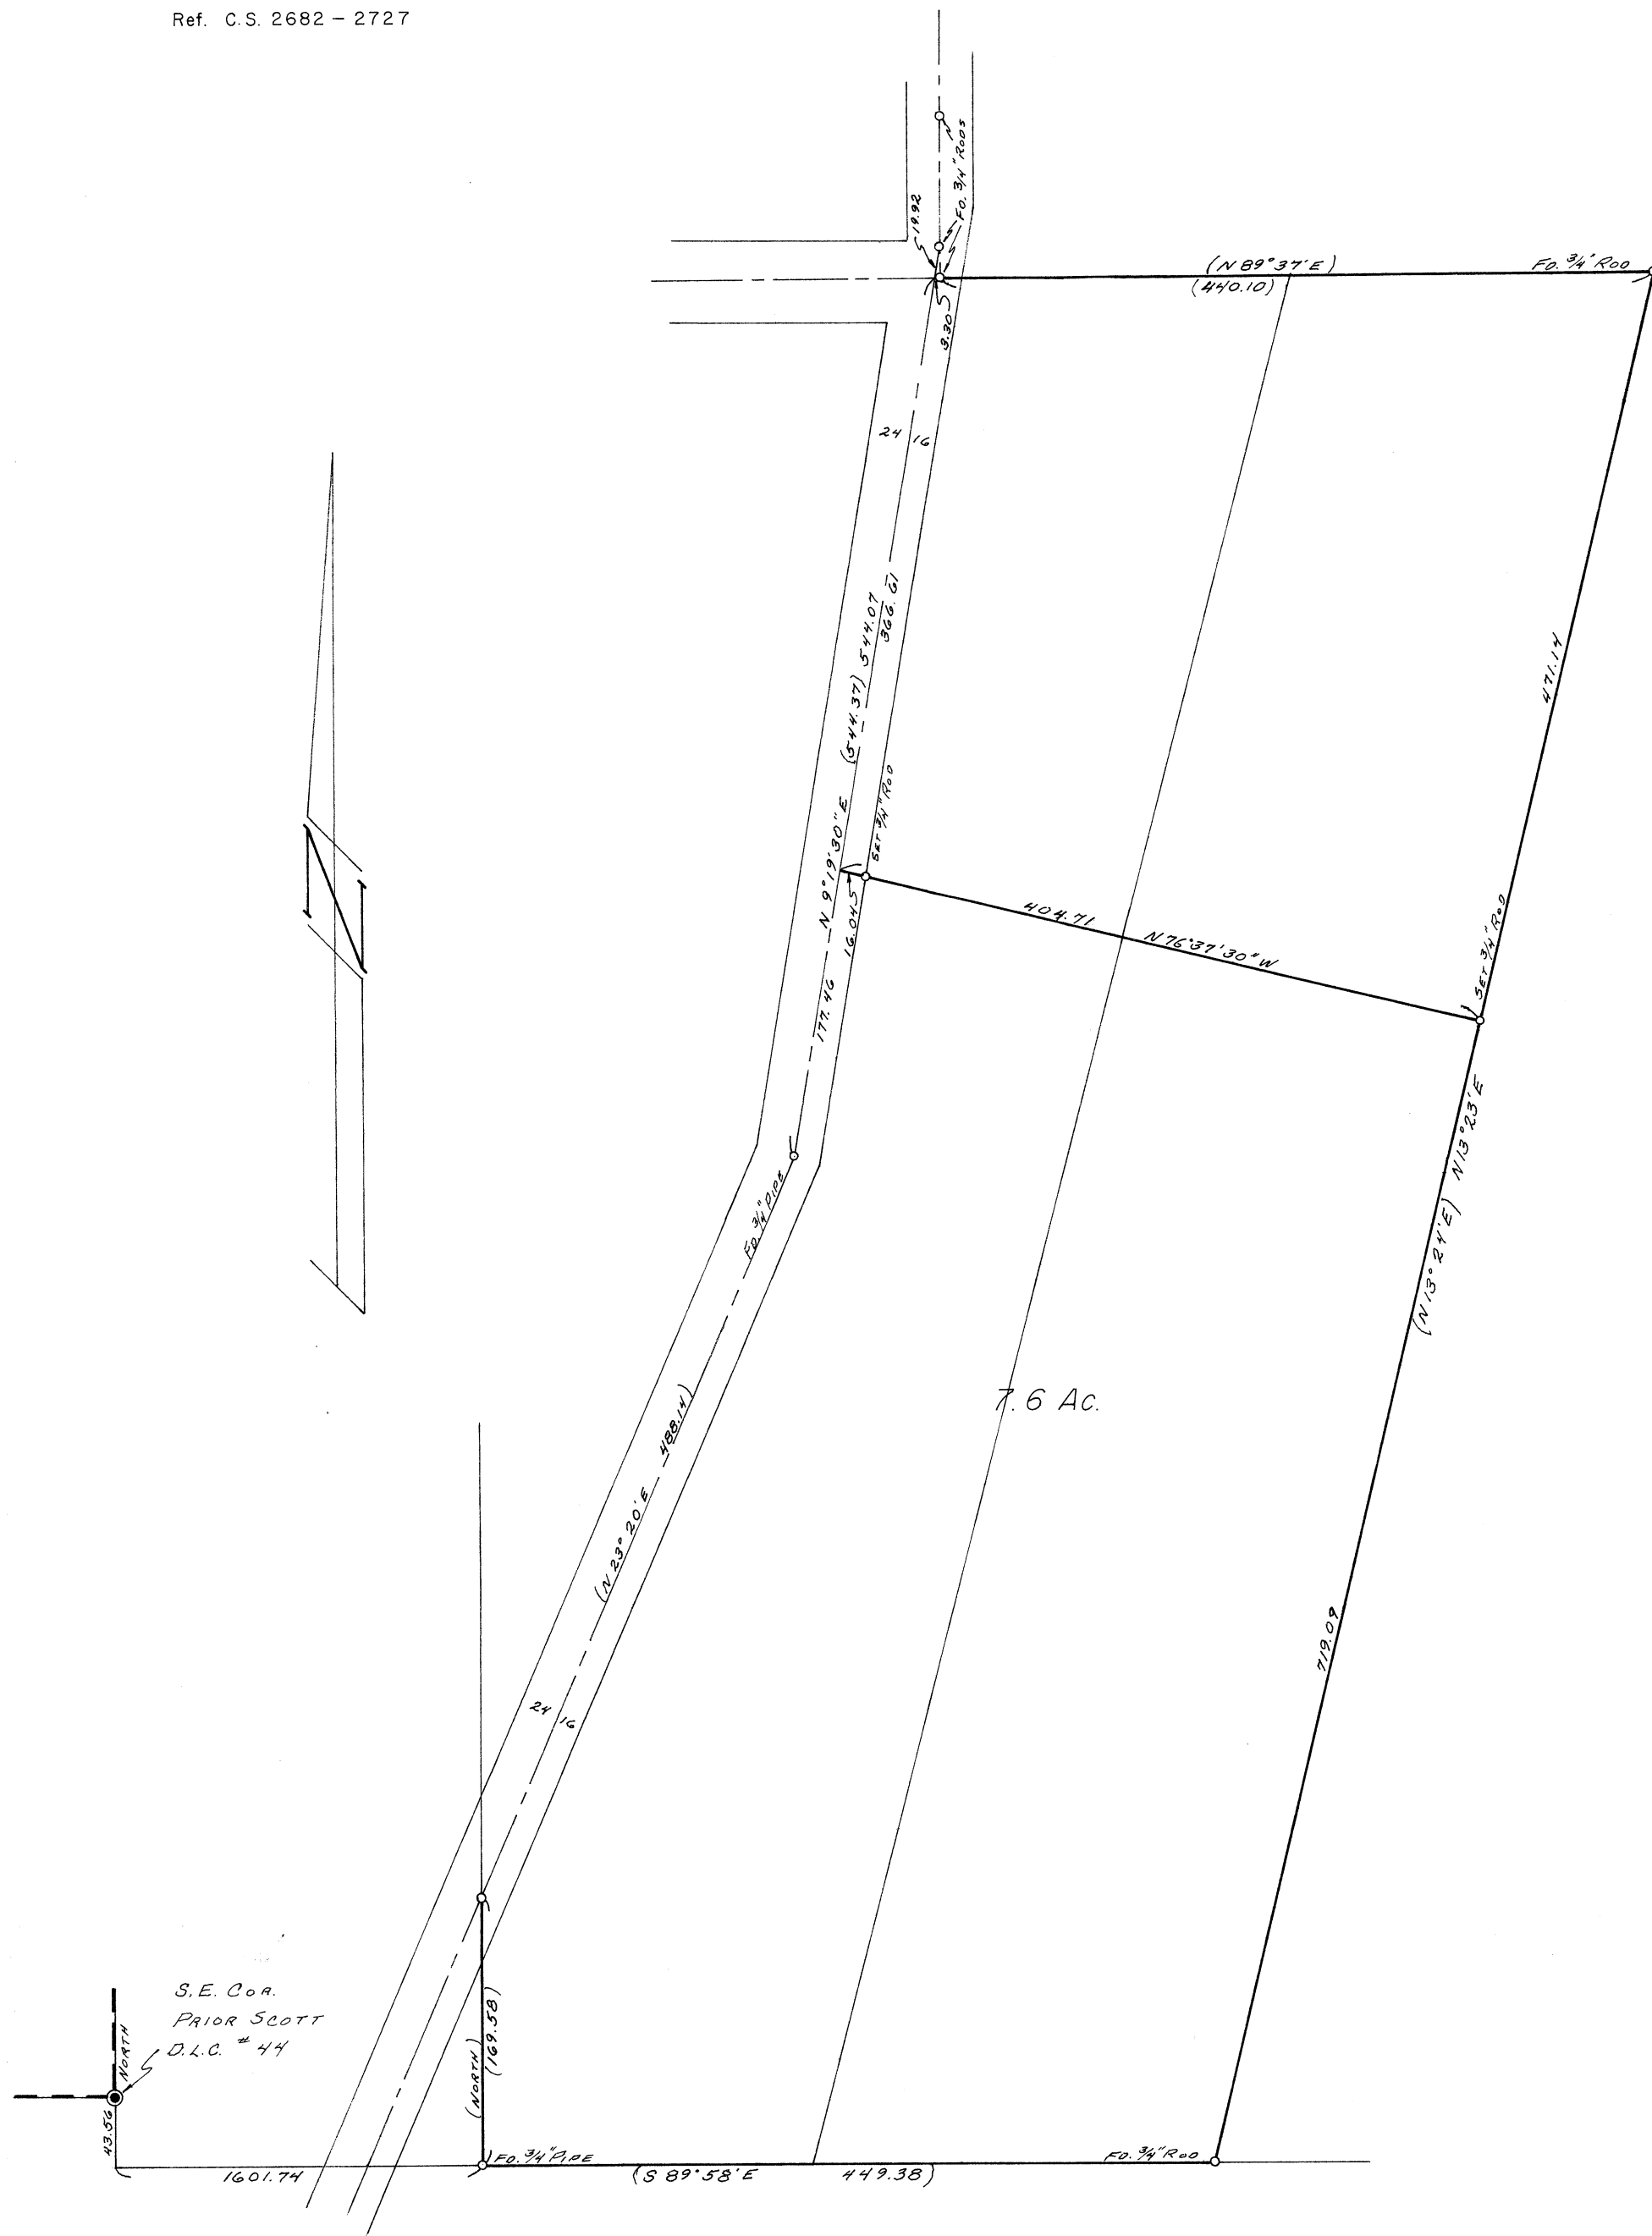

4904