


Northeast Corner
Price Fuller
D.L.C. 37

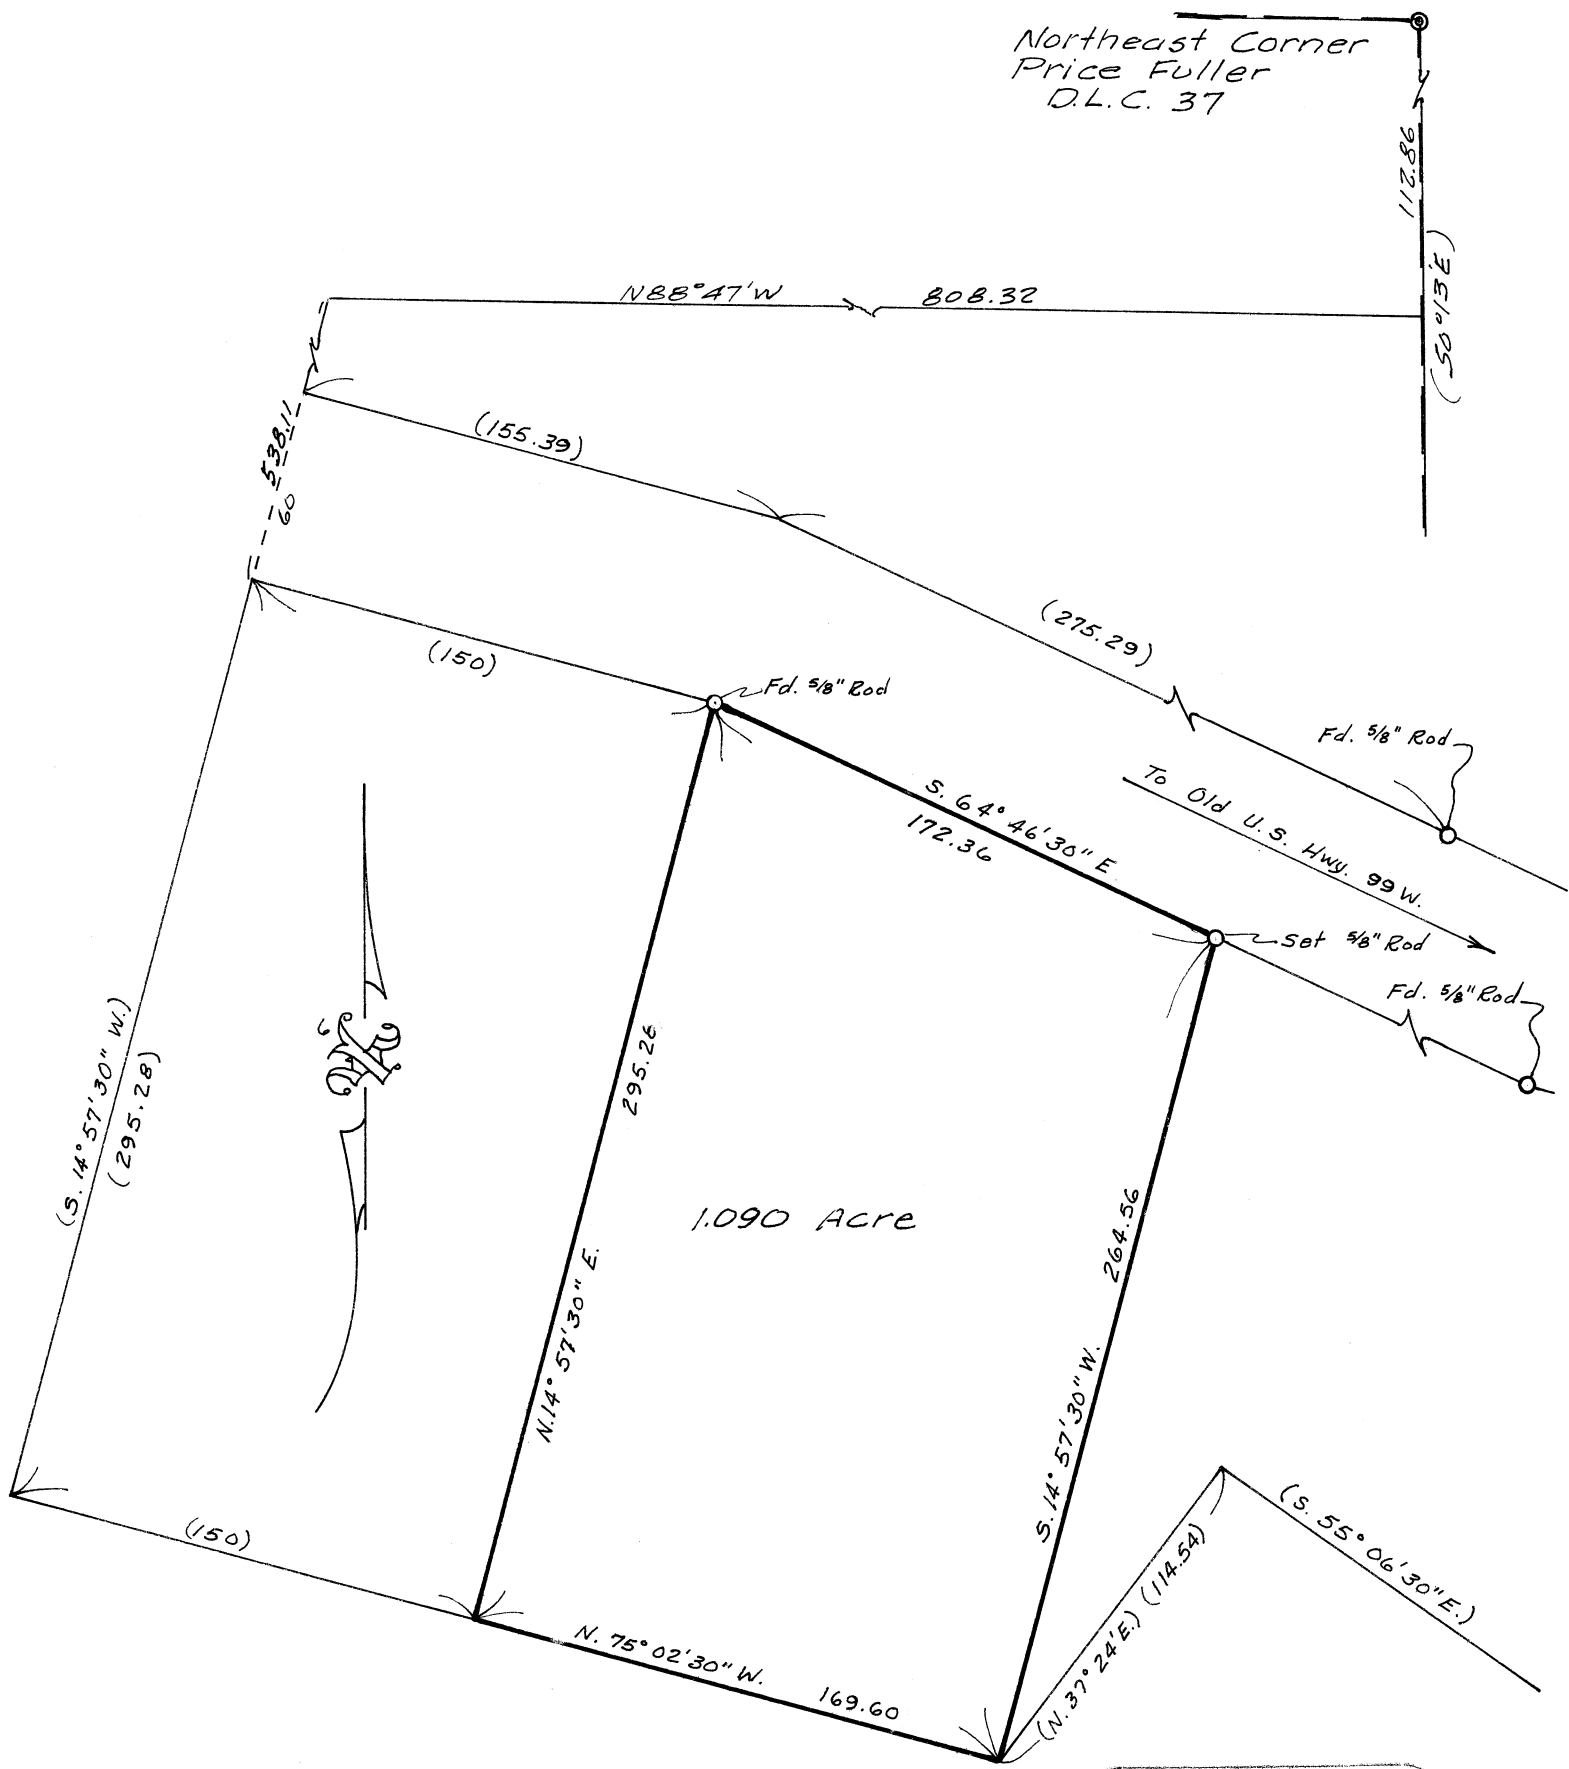

REGISTERED
OREGON
 LAND SURVEYOR
Verle C. Moore
 MAY 13, 1960
VERLE C. MOORE
 501

4948

RECORD OF SURVEY
FOR
ROBERT CANFIELD
IN THE

PRICE FULLER D.L.C. 37, T.11 S., R.5 W., W.B. & M.
BENTON COUNTY, OREGON

SCALE: 1" = 60'

JUNE 29, 1970