


4987

# CONSUMER'S POWER

IN JOHN D. MULKEY D.L.C. No. 54  
T.11S. R.5.W. OF W.M. IN BENTON Co.  
OREGON

SCALE: 1"=50' Oct. 14, 1970  
BERT W. UDELL R.P.E. #2301

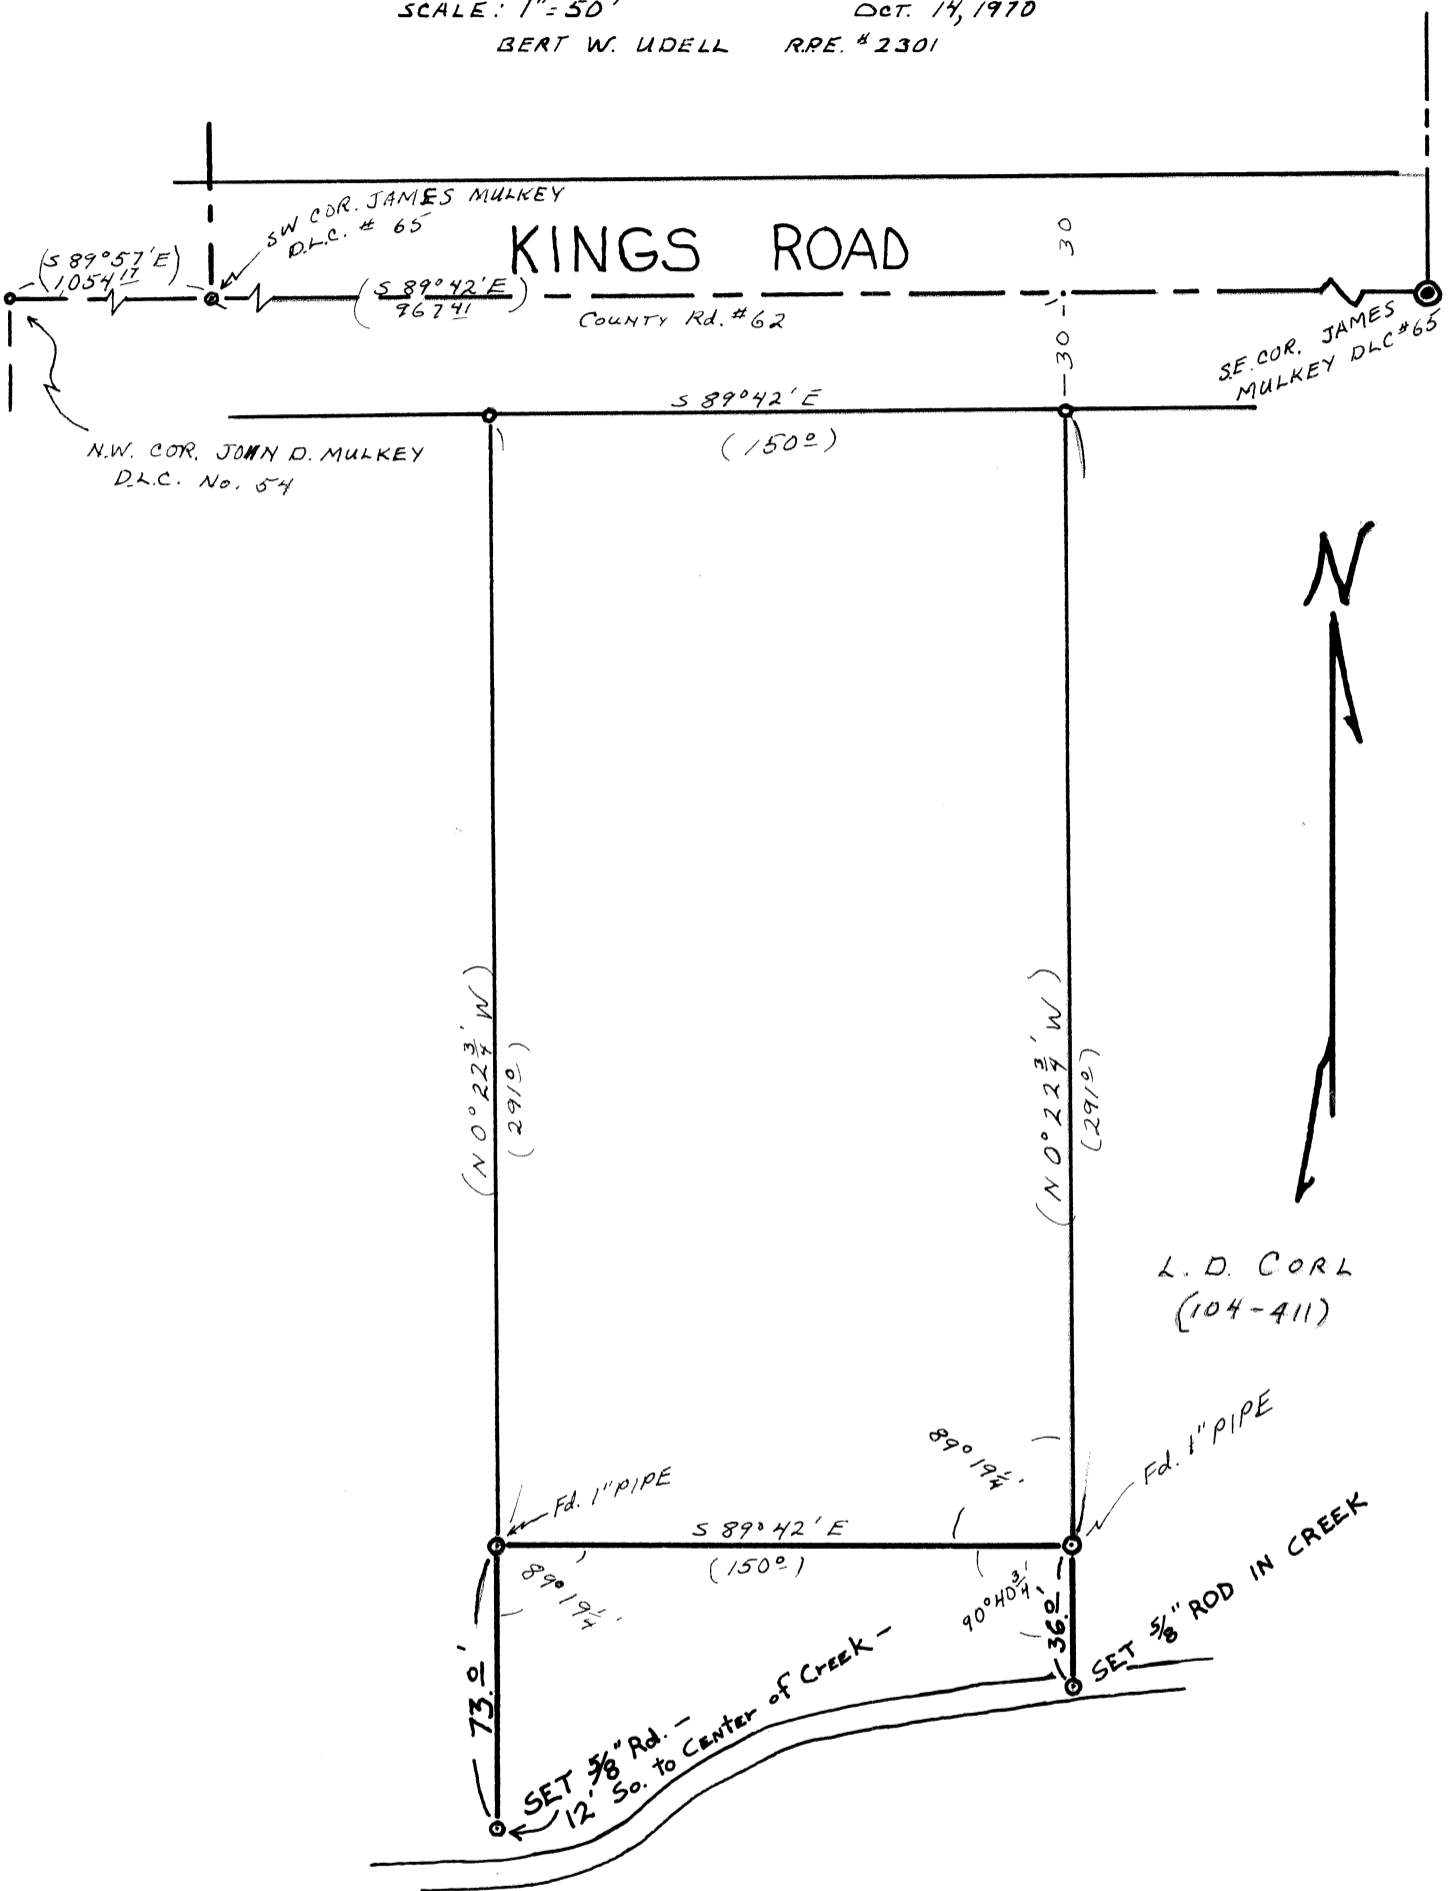

L. D. CORL  
(104-411)

Bert W. Udell