


1" = 6 CHAINS

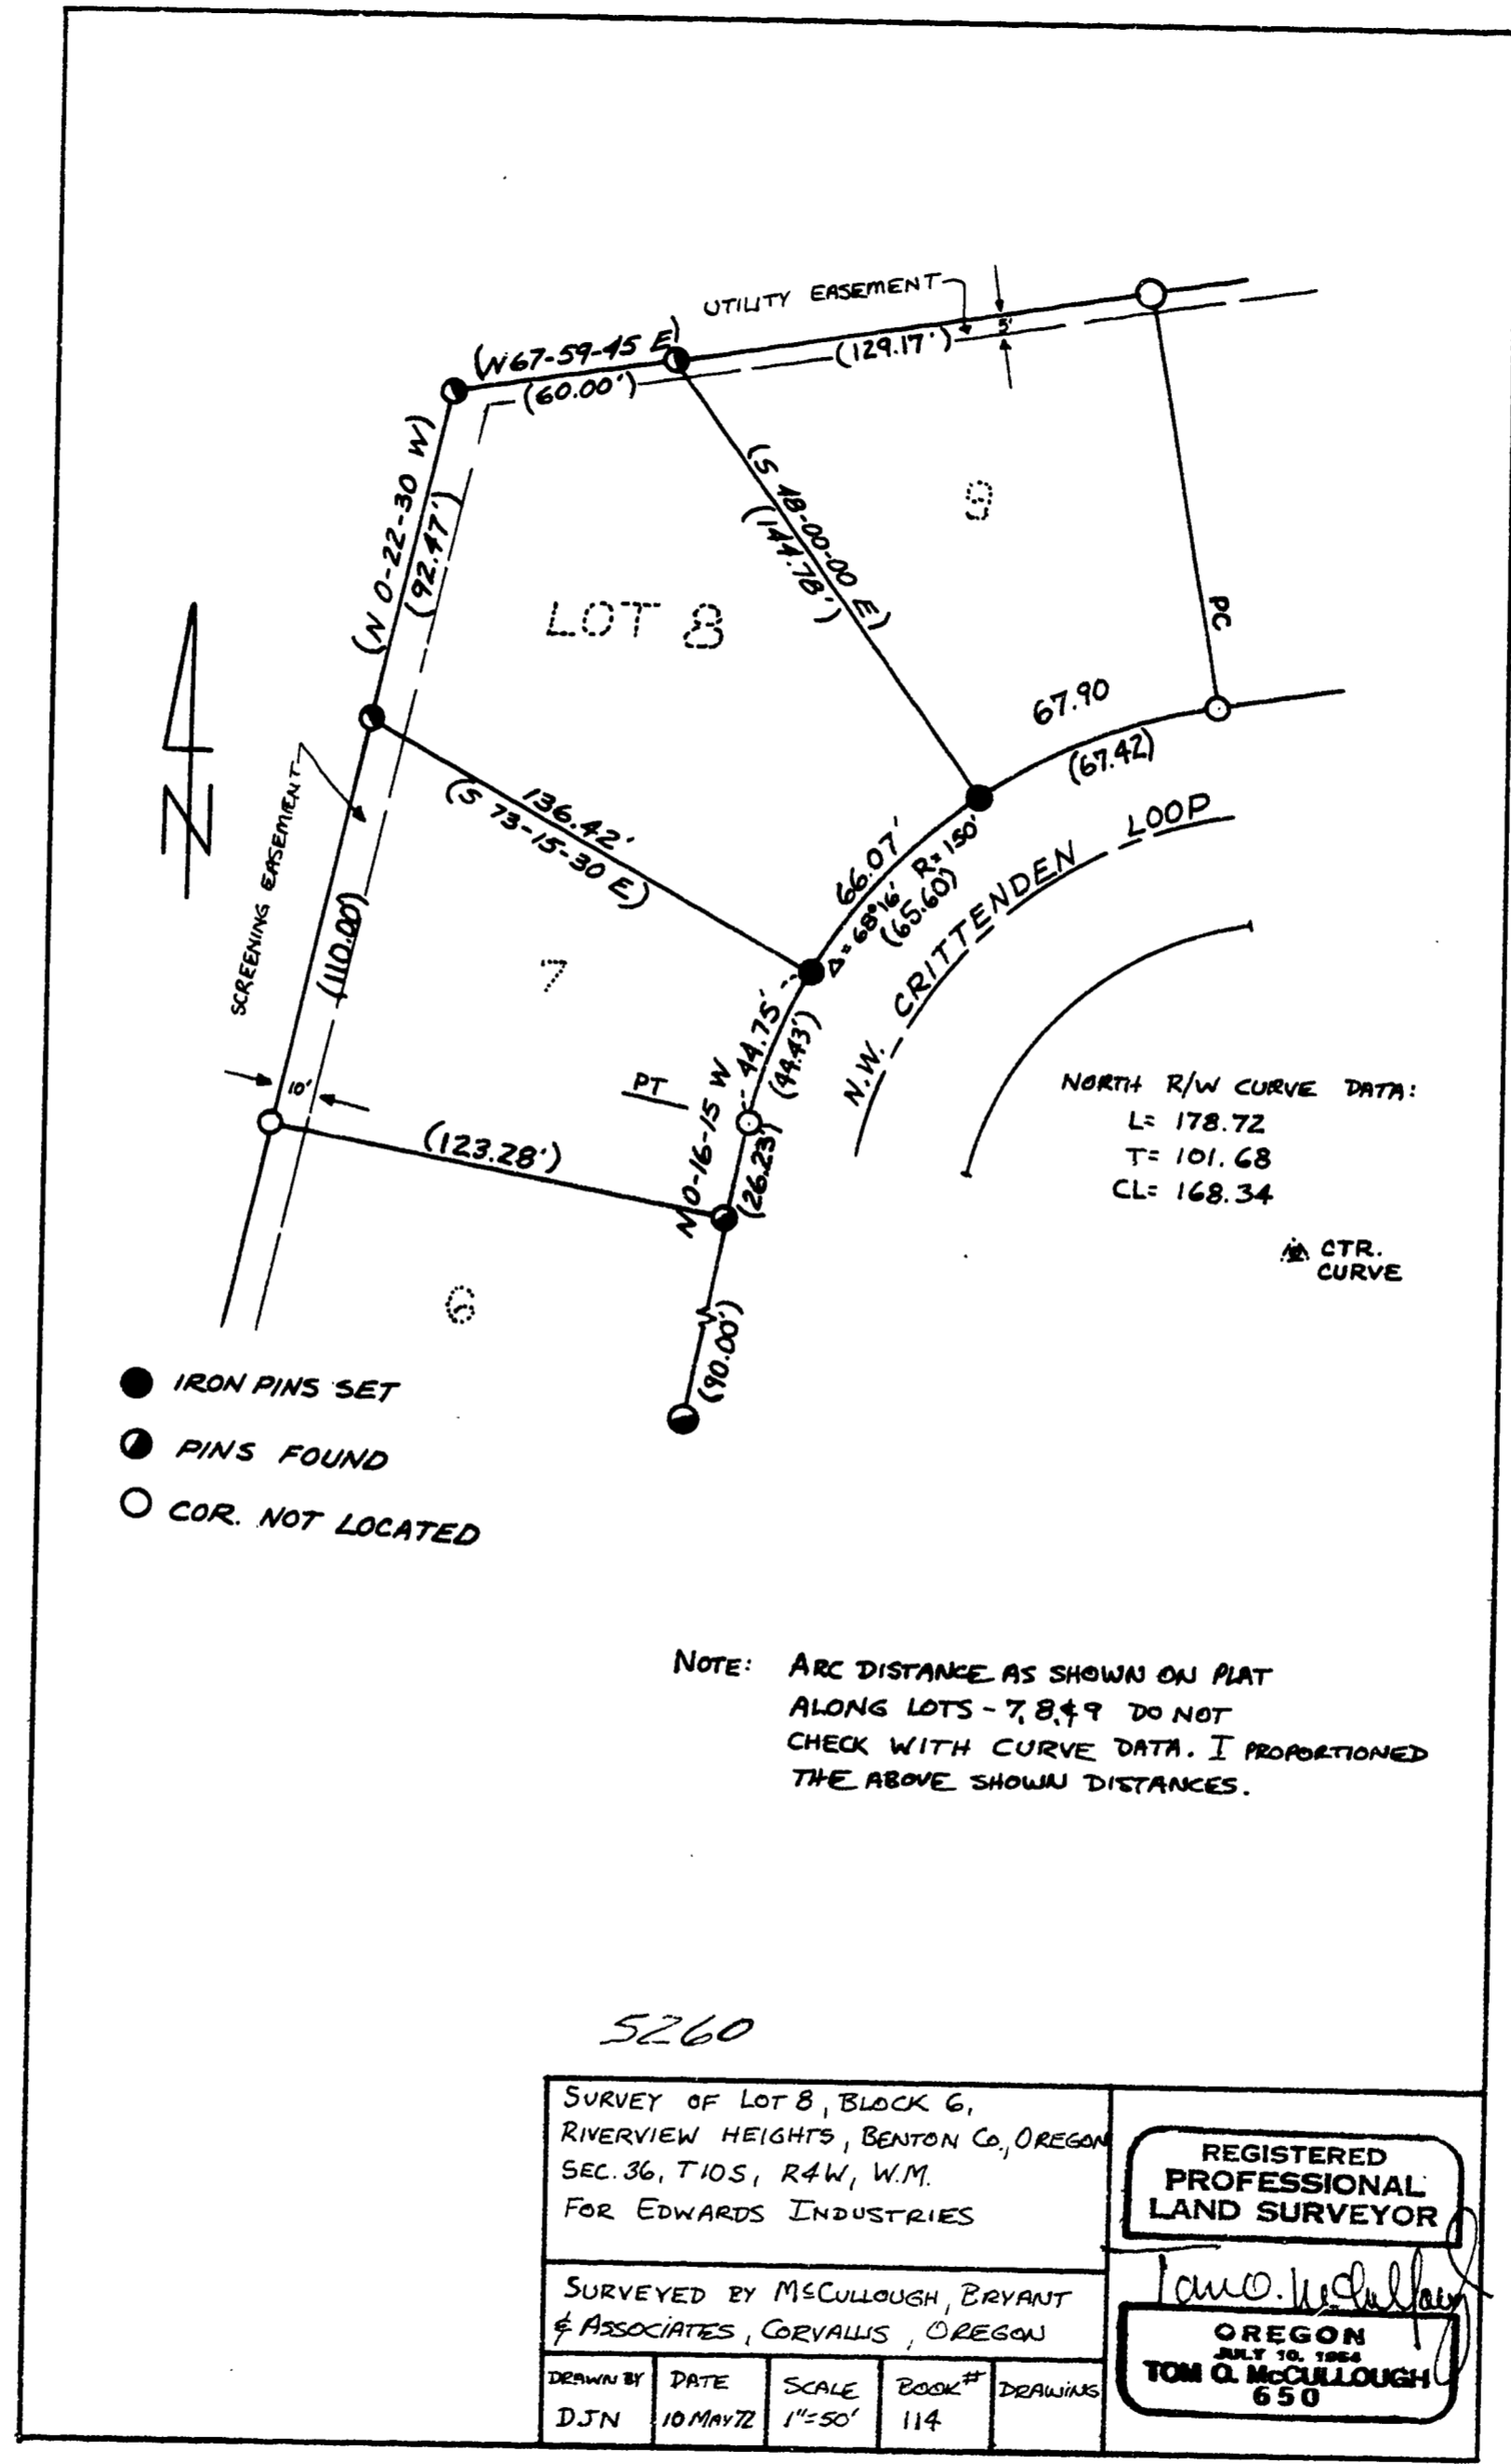

REEL 5 FRAME 480