


5604
 RECORD OF SURVEY
 FOR JOEL TIMIAN
 SEE S 7115, 2244 W.M.
 BENTON COUNTY, ORE.
 SCALE 1" = 100'
 MAY 13, 1973
 0 1/8" rods set

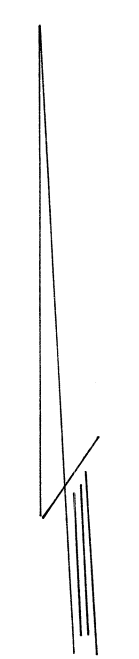

REGISTERED
 PROFESSIONAL
 LAND SURVEYOR
Richard W. Fall
 OREGON
 NOVEMBER 4, 1968
 RICHARD W. FALL
 357