
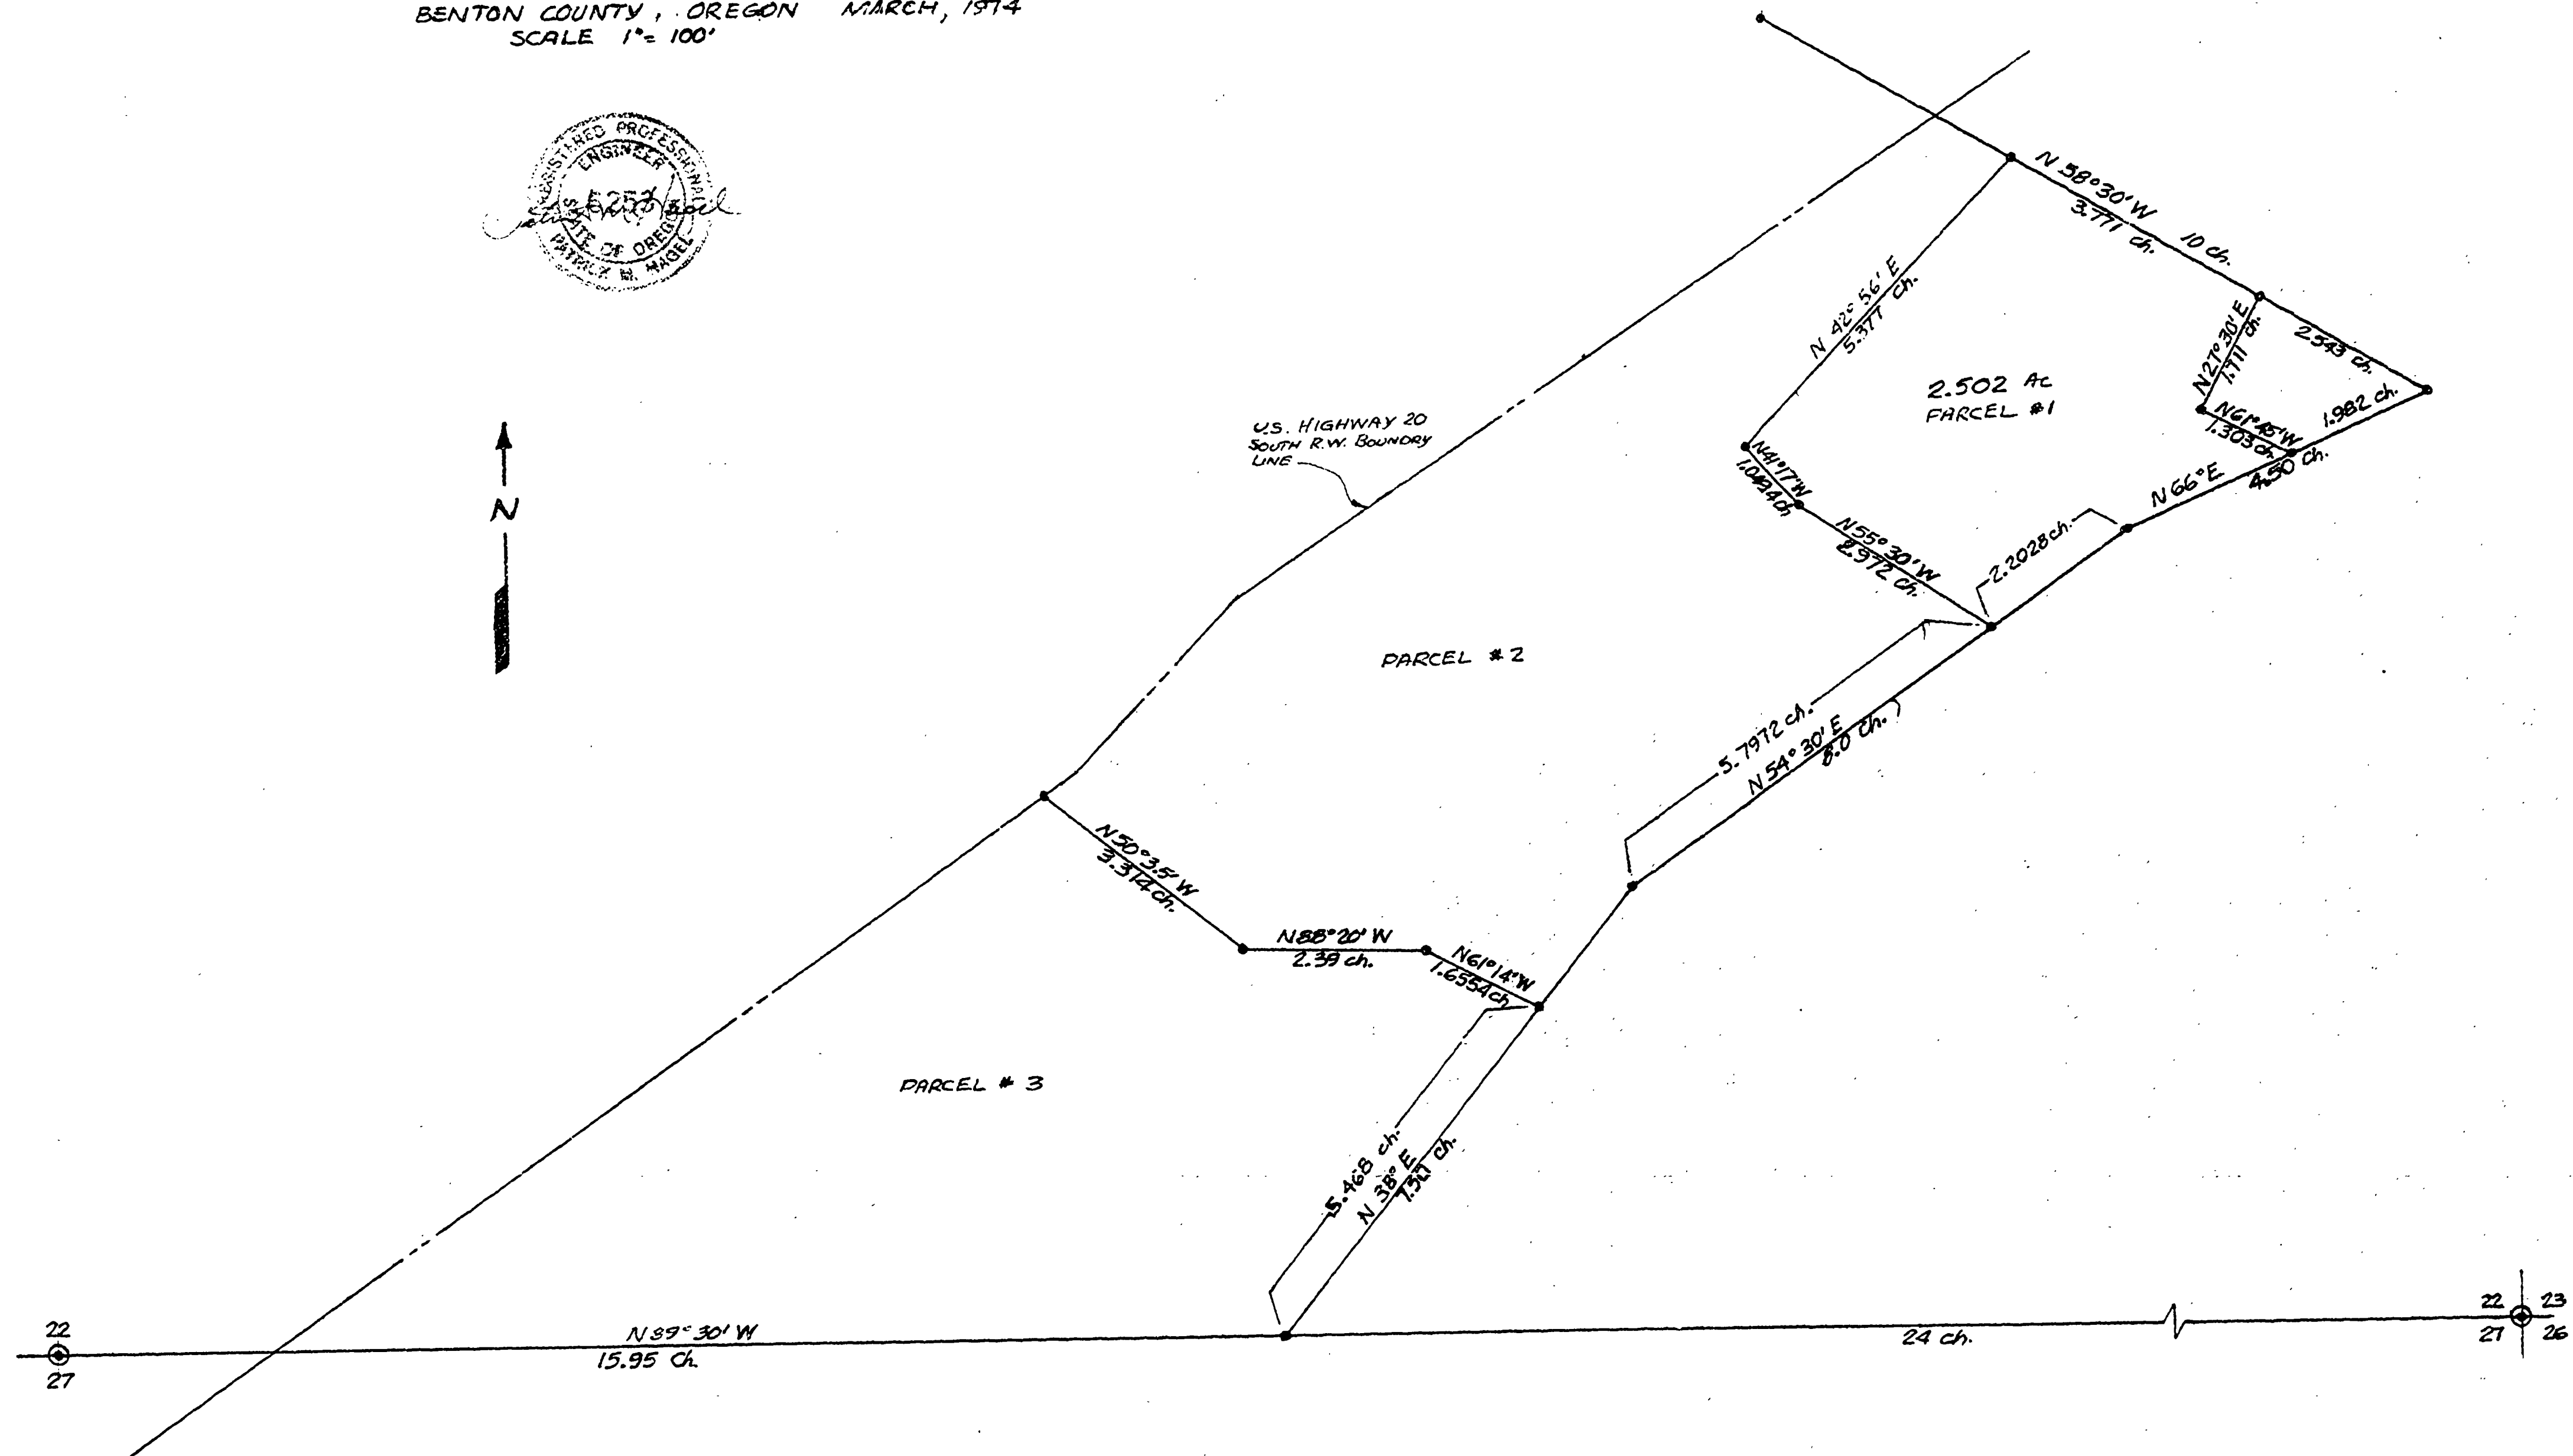


5676

RECORD OF SURVEY  
FOR ELDON CLAYTON  
IN: THE SOUTHEAST QUARTER OF  
SECTION 22, TOWNSHIP 11 SOUTH,  
RANGE 7 WEST, WB & M  
BENTON COUNTY, OREGON MARCH, 1914  
SCALE 1" = 100'

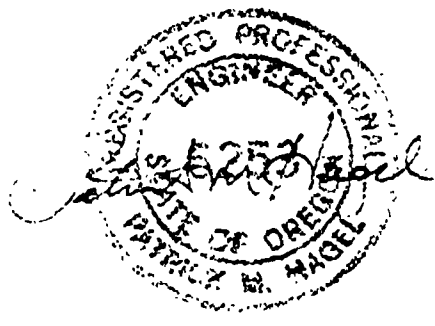

5676