

05839

RECORD OF SURVEY


FOR CONSER HOMES

IN The C. P. BLAIR D. L. C. No. 57

Township 12 South, Range 6 West, W. M.

Benton County, Oregon March, 1975

Scale: 1" = 100'

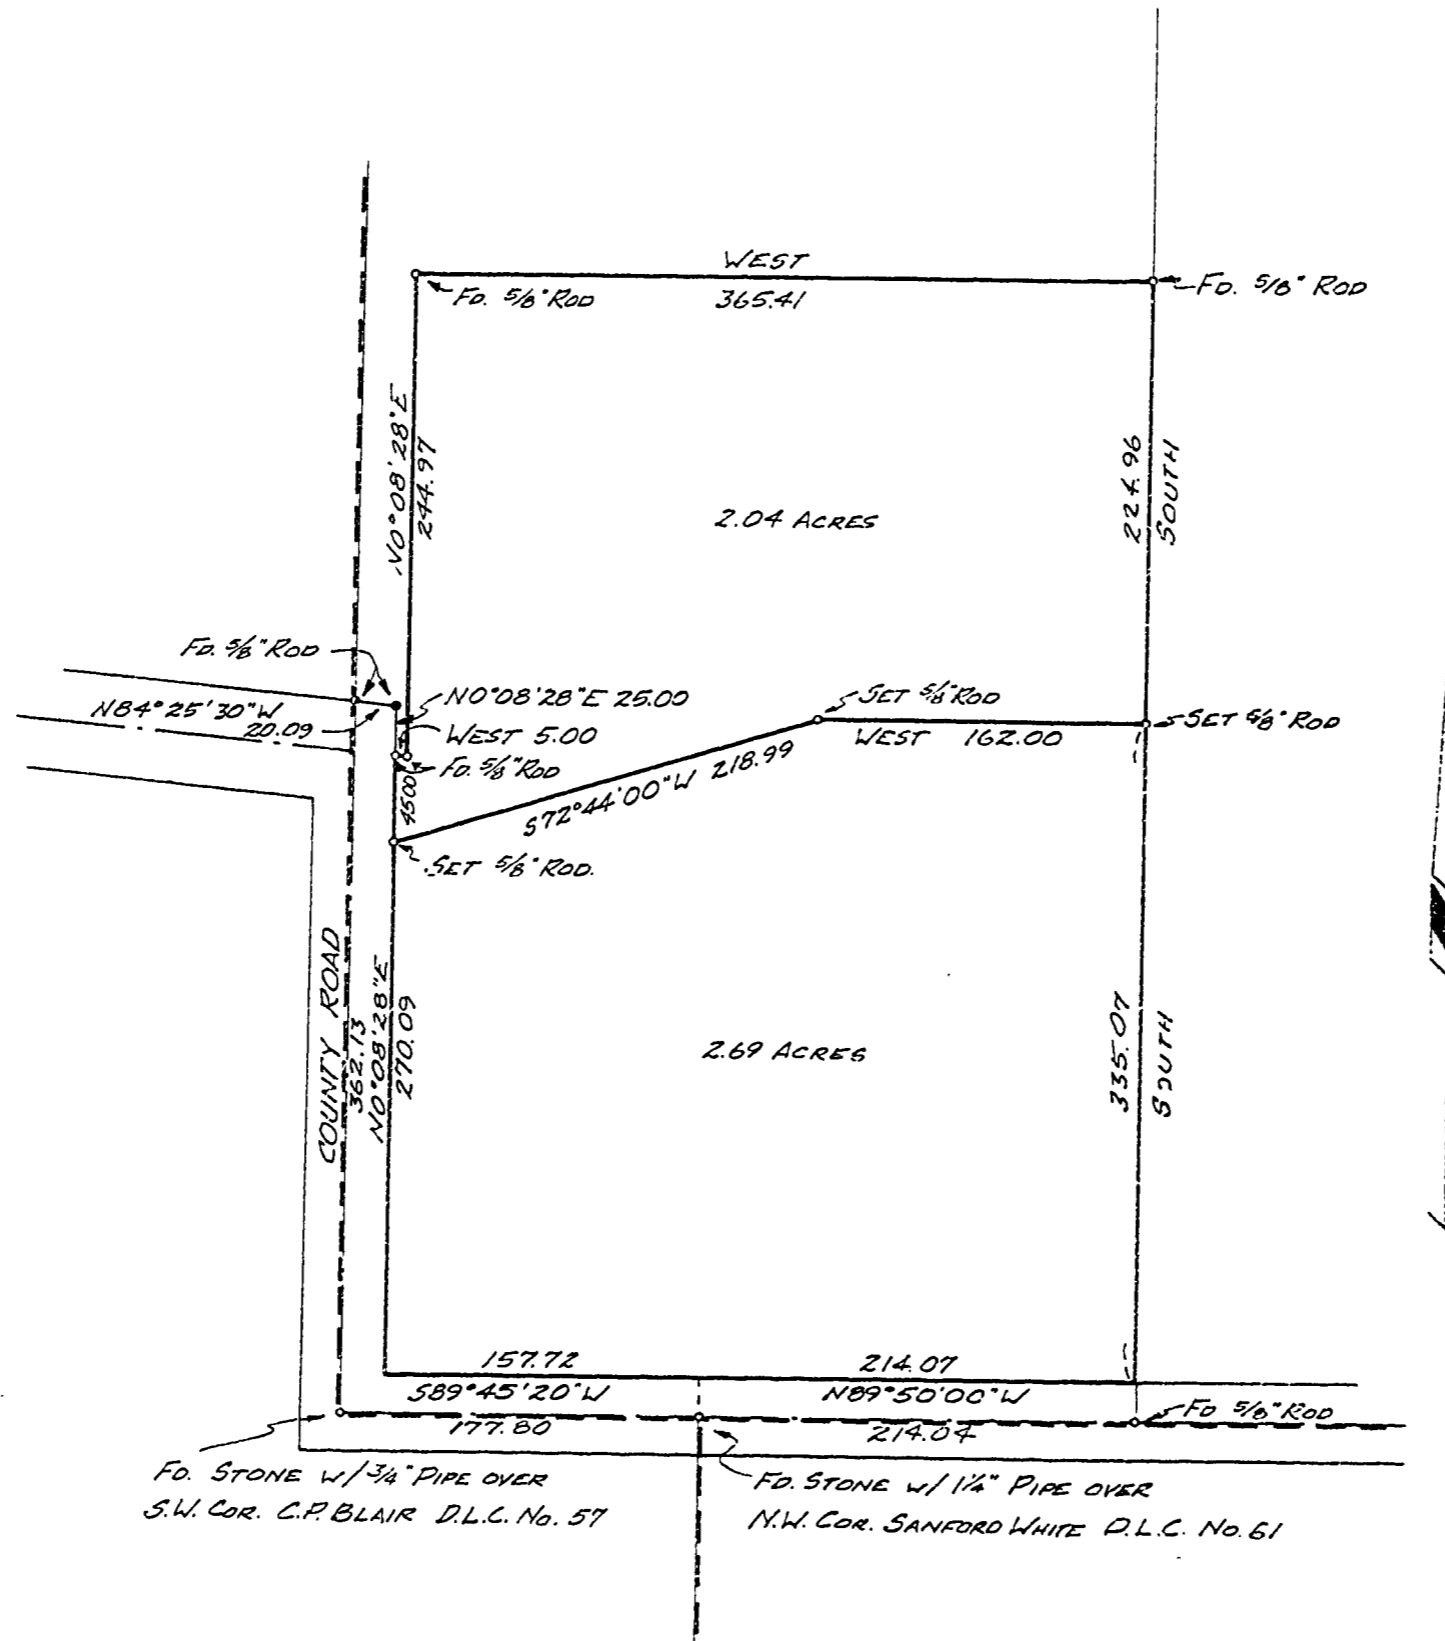

REGISTERED
PROFESSIONAL
LAND SURVEYOR

Nick A. Yinger

OREGON
JULY 12, 1908
NICK A. YINGER
876