


Survey For 05957
 Herb Weisgerber
 700 N.W. Cornell Street
 Corvallis Oregon 97330

SE. Corner
 S.M. Stout
 D.L.C. # 48
 T11S, R5W
 of W.M.
 Benton County,
 Oregon

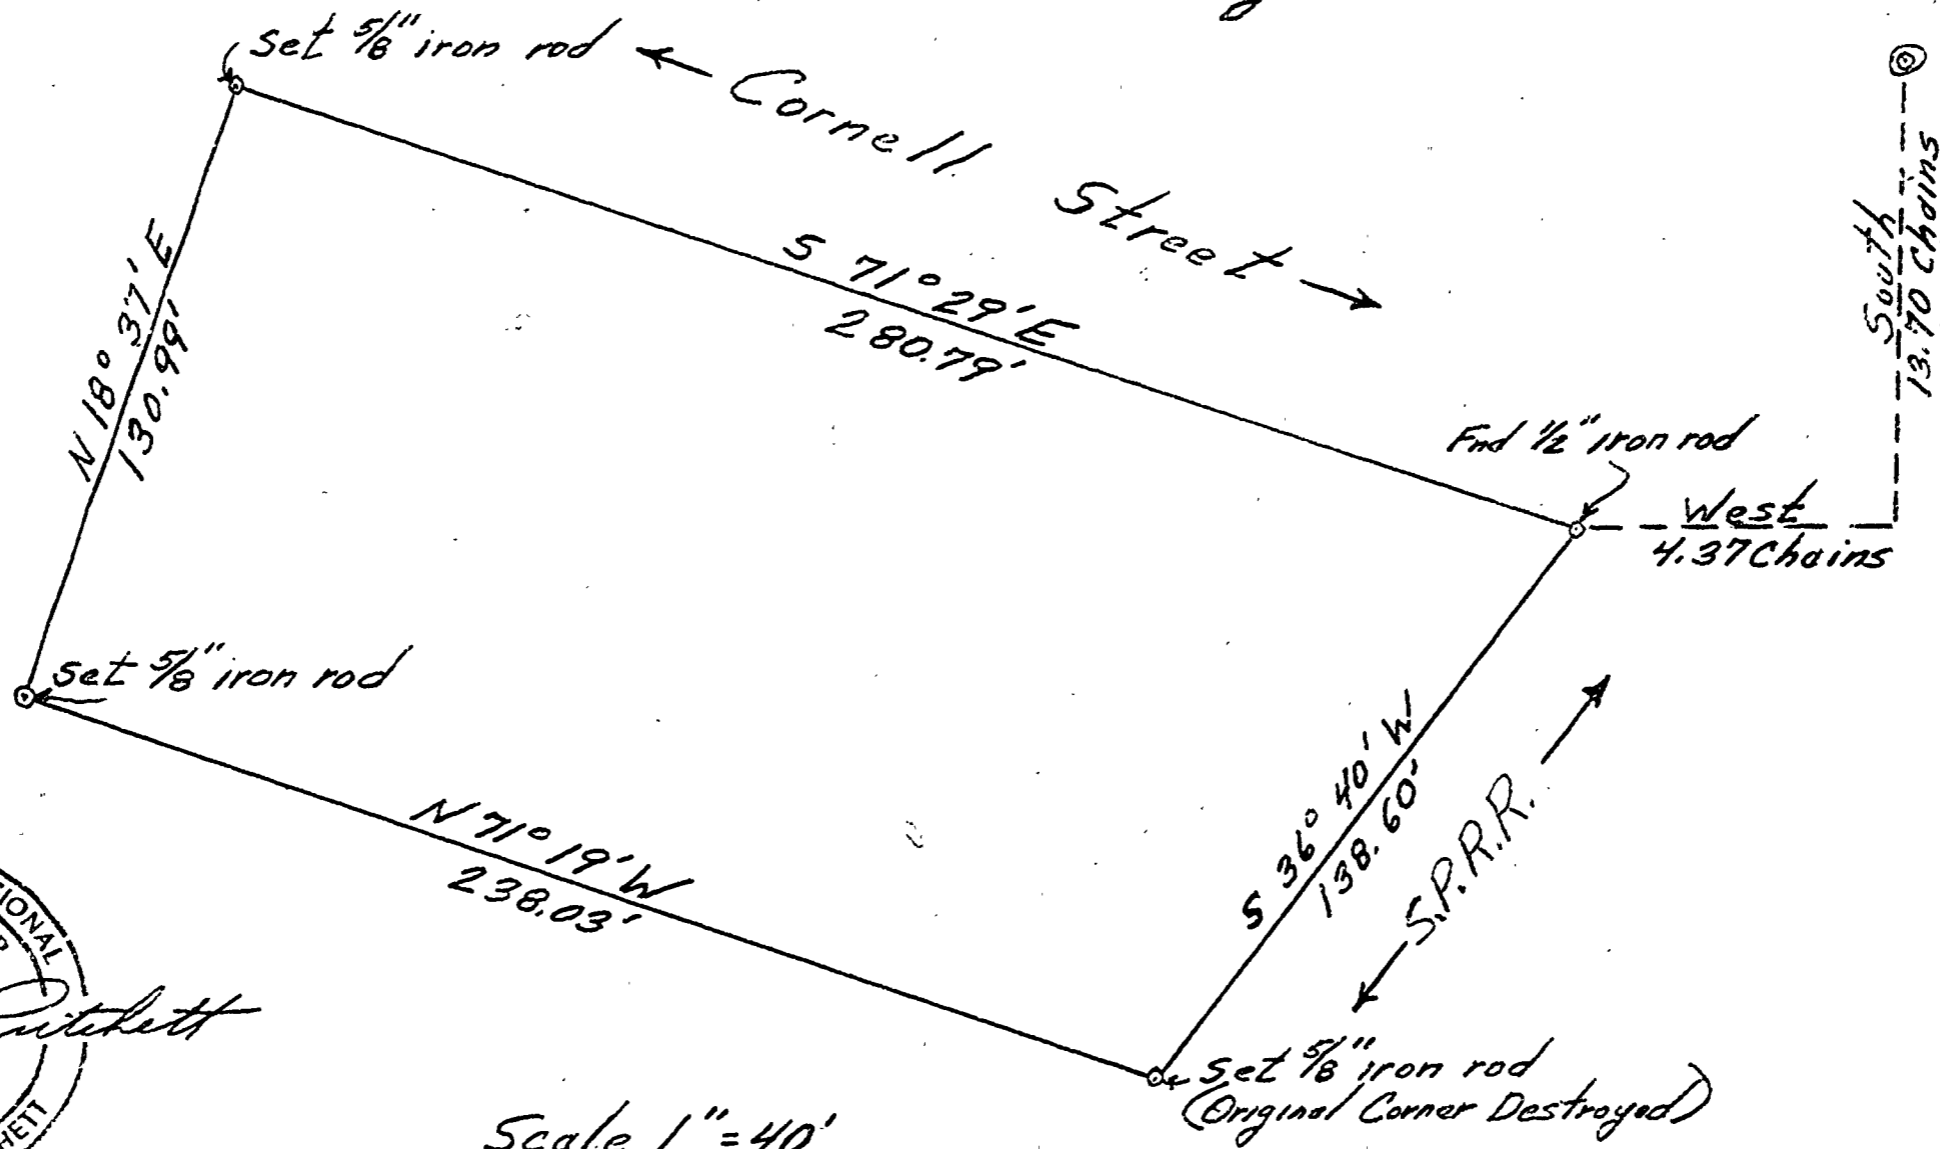

Harold D. Pritchett

Scale 1" = 40'
 9-21-75