

05969

RECORD OF SURVEY


FOR STEVE SCHUDEL

IN The COLBERT P. BLAIR D.L.C. No. 57

NE 1/4 Sec. 35, T. 12 S., R. 6 W., W.M.

Benton County, Oregon Oct. 29, 1975

Scale: 1" = 100'

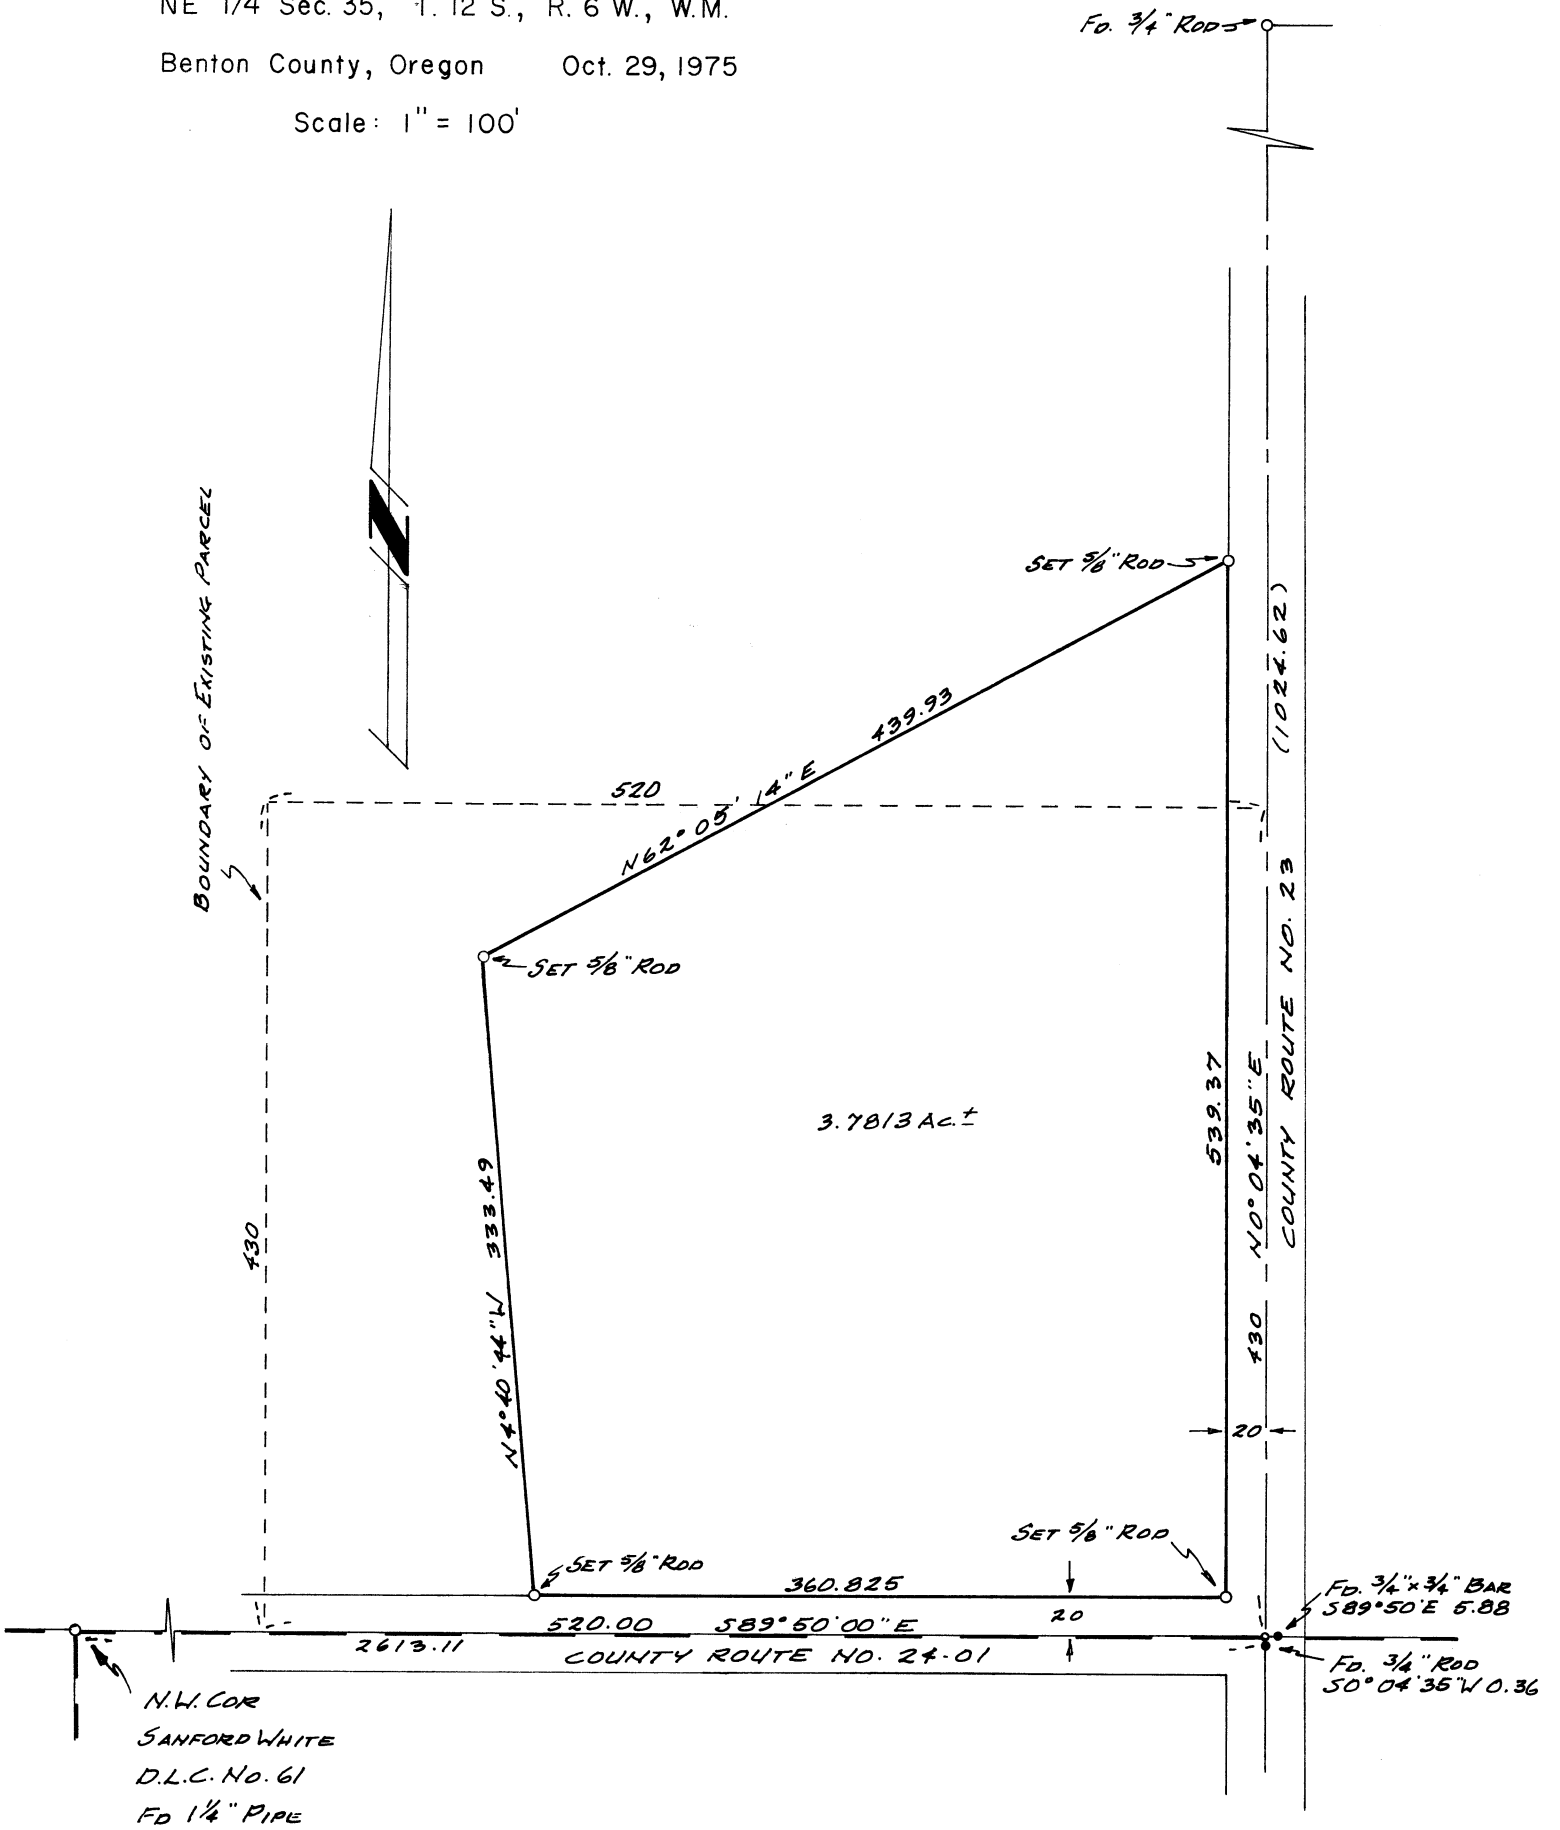

N.W. COR
SANFORD WHITE
D.L.C. No. 61
FD 1 1/4" PIPE

REGISTERED
PROFESSIONAL
LAND SURVEYOR

Nick A. Yinger

OREGON
JULY 12, 1926
NICK A. YINGER
876