


5975

5975

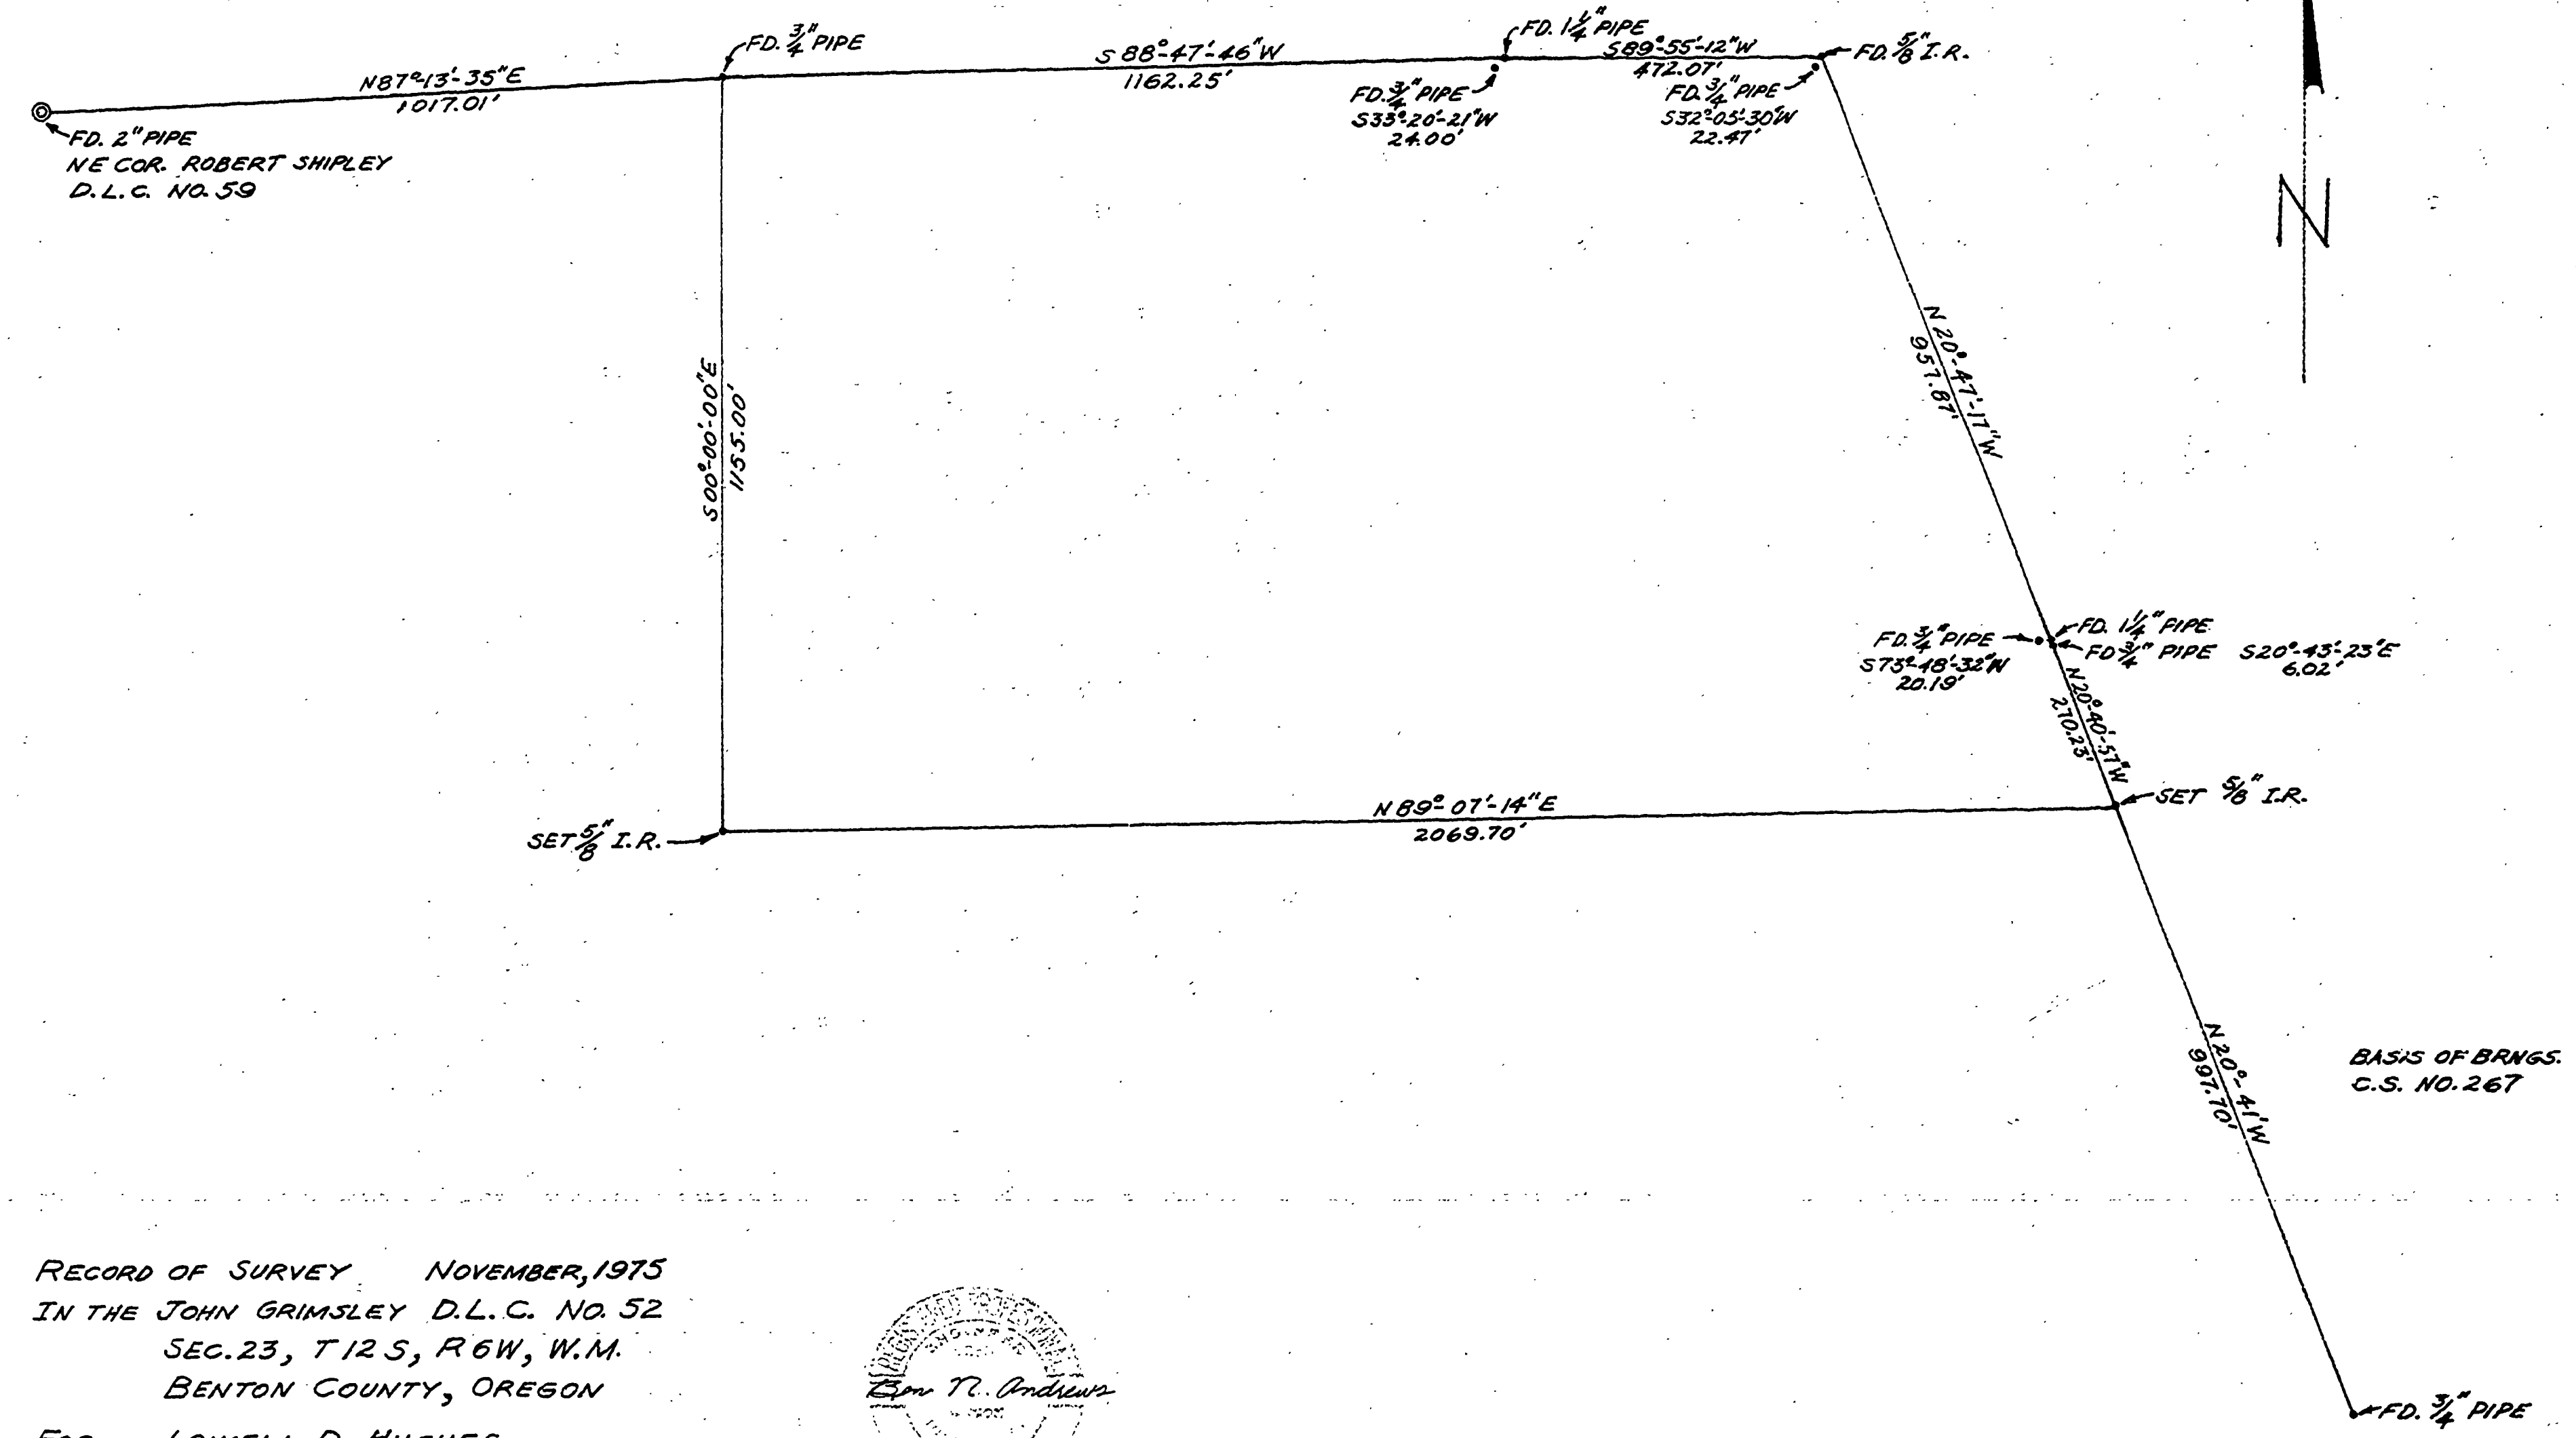

RECORD OF SURVEY NOVEMBER, 1975
 IN THE JOHN GRIMSLEY D.L.C. NO. 52
 SEC. 23, T12S, R6W, W.M.
 BENTON COUNTY, OREGON
 FOR LOWELL D. HUGHES
 SCALE 1"=200'



CS 05975