
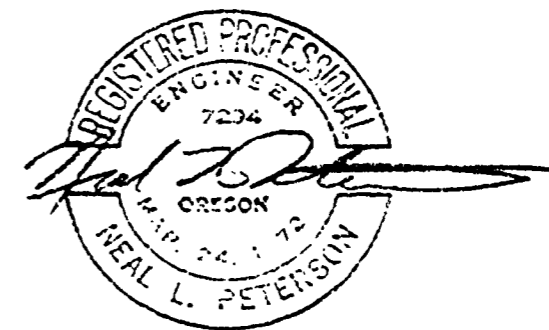


06136

Record of Survey for *VINEYARD MT. CORP.*

SE QUARTER SECTION 3, TOWNSHIP II SOUTH,
RANGE 5 WEST OF WILLAMETTE MERIDIAN

13 AUGUST 1976

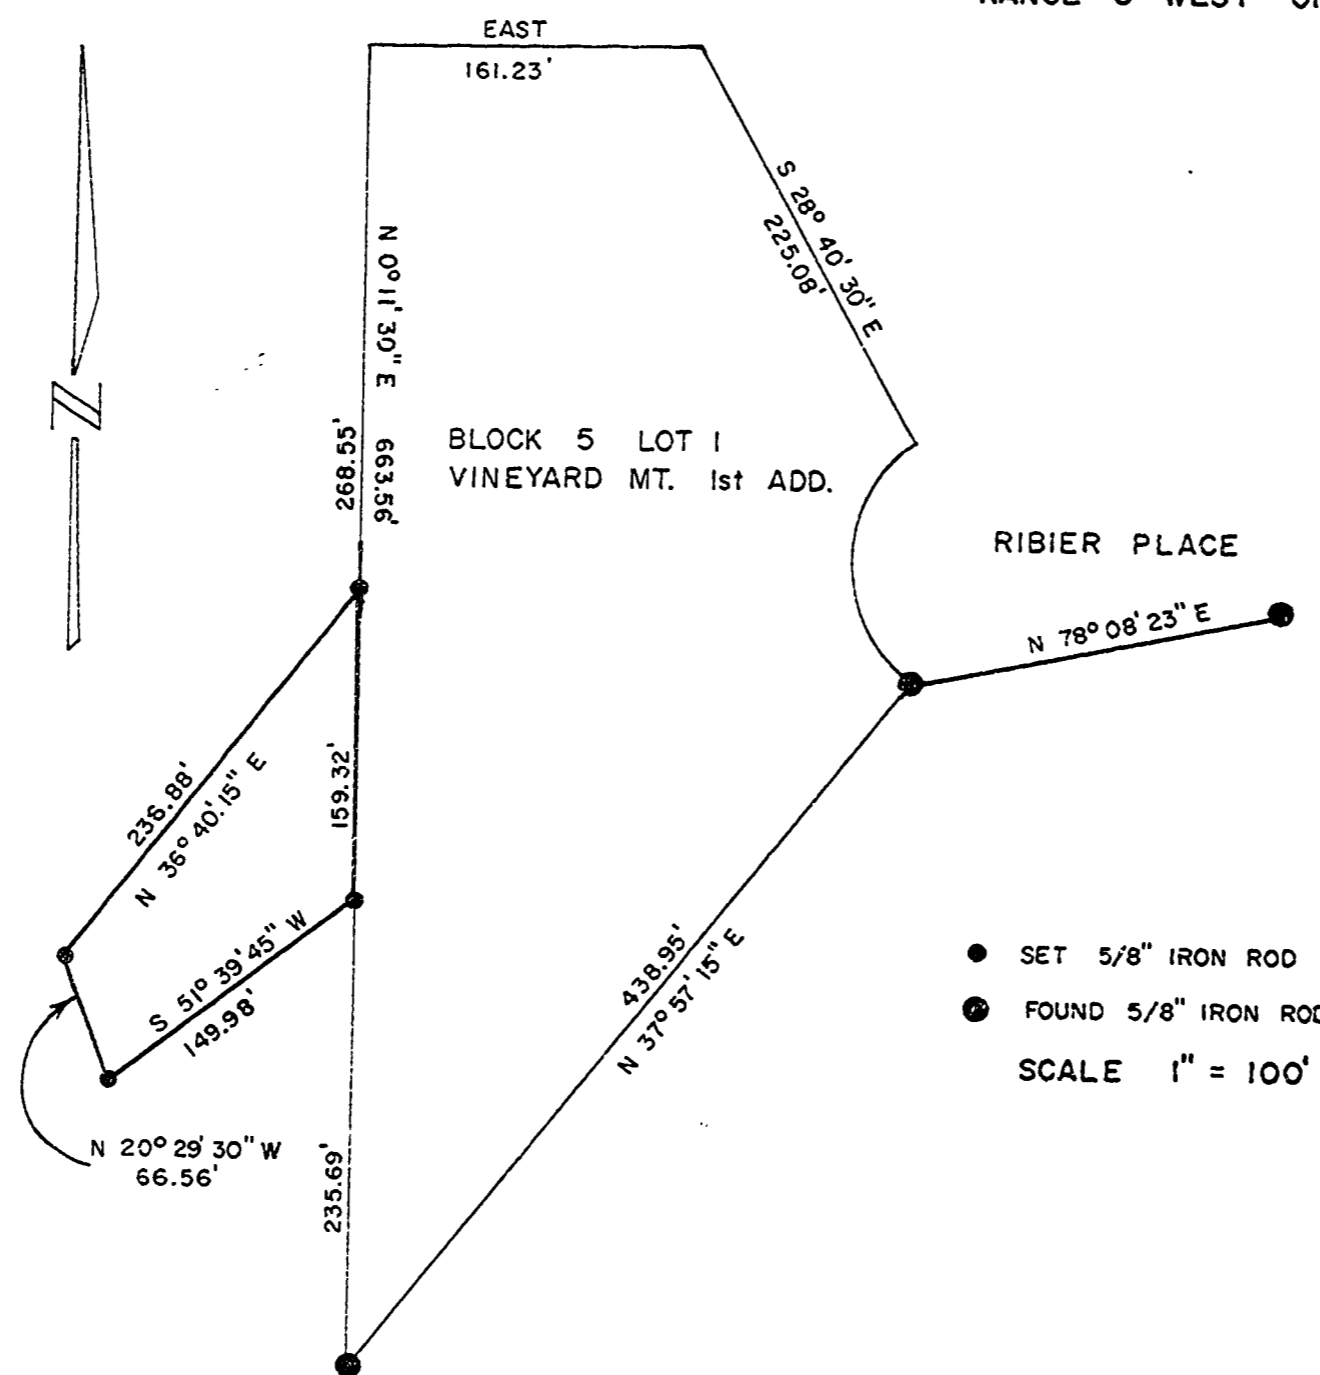

- SET 5/8" IRON ROD
 - FOUND 5/8" IRON ROD
- SCALE 1" = 100'