

BLOCK NO. 4.


622

College Hill Addition
to
Corvallis

scale 1" = 60'

1027.97
648.9
378.97
1.166
1.55
1.134

89.32
= 122.96
212.28
245.75
83.47

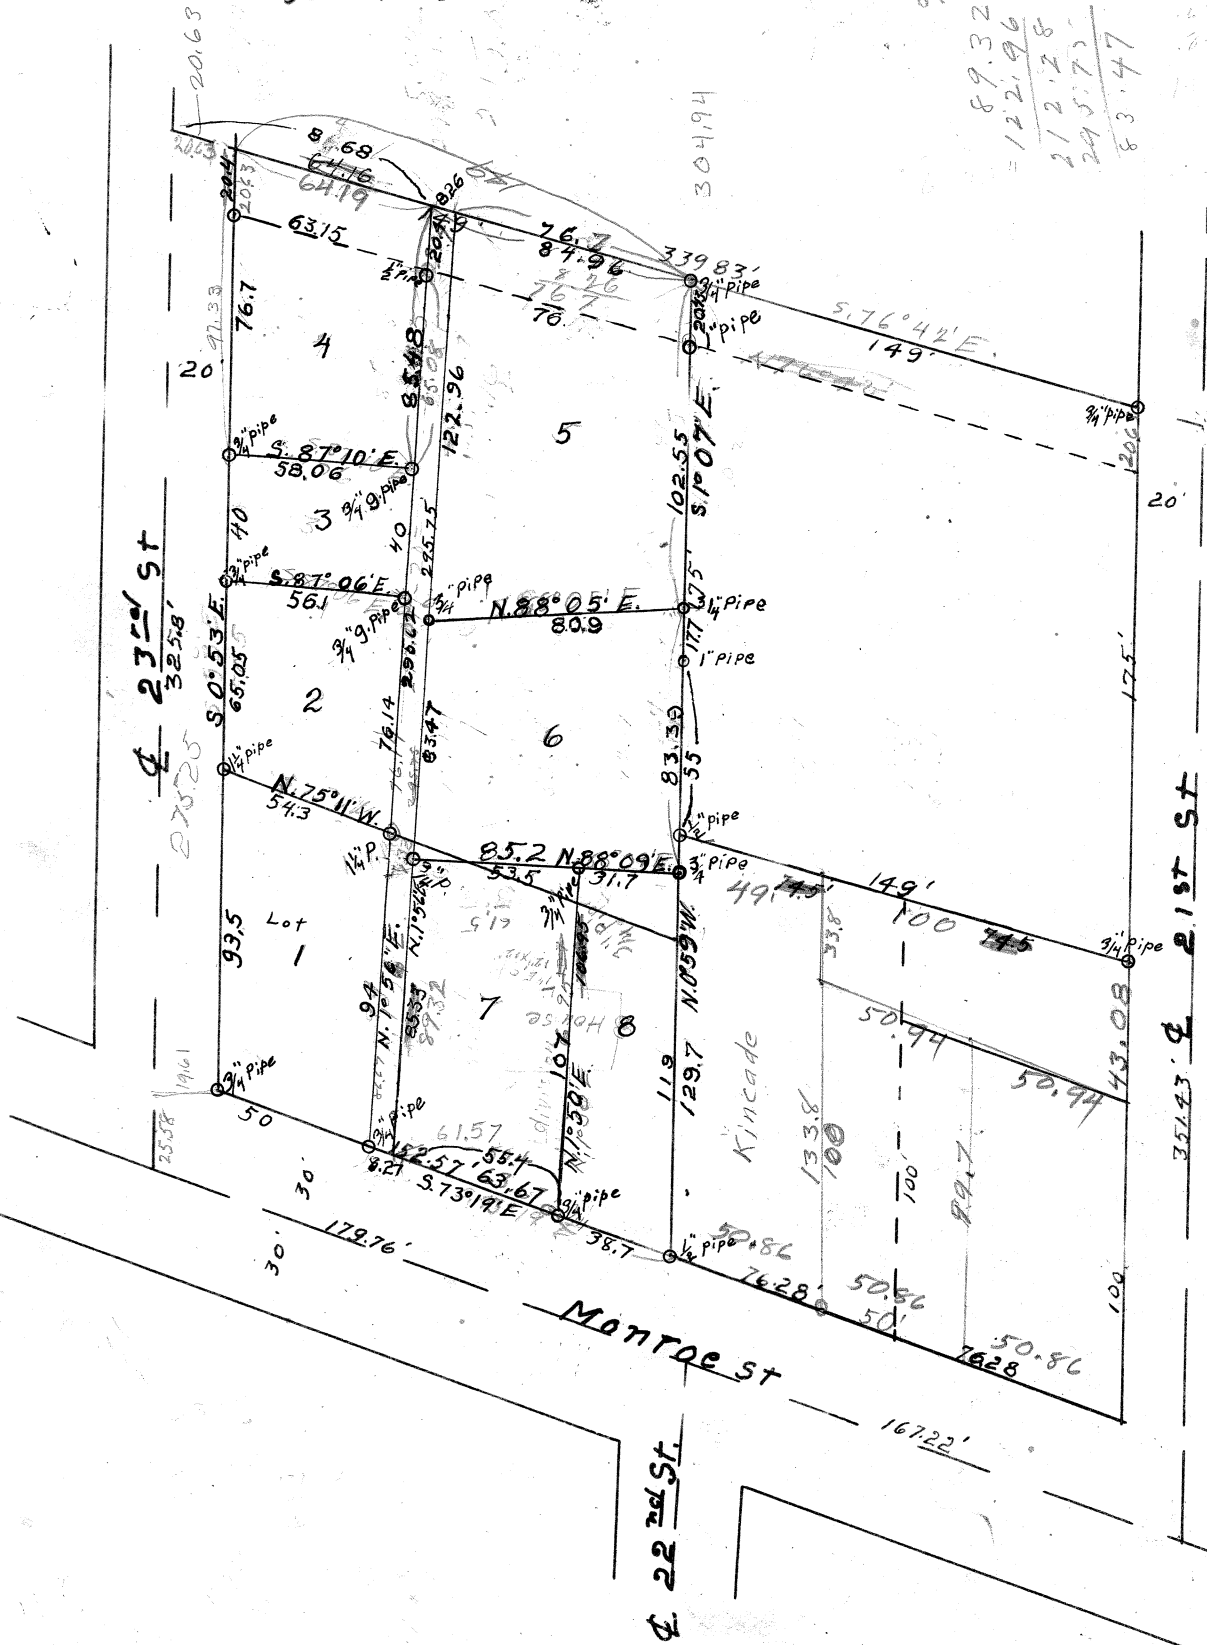

57