

RECORD OF SURVEY

FOR *OLIN MARINE*


IN The S.M. Stouts D.L.C. No. 48

Township II South, Range 5 West, W.M.

Benton County, Oregon June, 1977

Scale : 1" = 50'

PLAT	_____
FILE NO.	_____
FILE DATE	_____
FILE SITE	_____

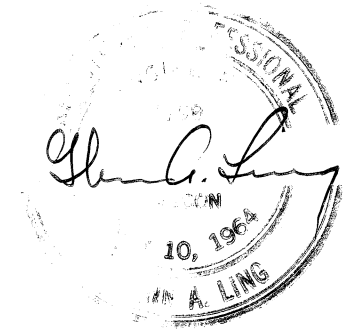

6383

