

C.S. # 643

Hardcopy 11-5 # 20

also see notes in file

F. B. 26-36

FB #26 PAGE. 36

C. S. #129 Continued

#643

021
33025
0012
33037


66-612

66-645
66
3870
327
425700

| | |
|--------|--------|
| 2,273 | 2,273 |
| 66-150 | 66 |
| 132 | 13638 |
| 180 | 13638 |
| 132 | 150018 |
| 480 | |
| 162 | |
| 180 | |

1,415
66
10270
10270
113,170

For L. G. Freeman Oct. 25, 1918.

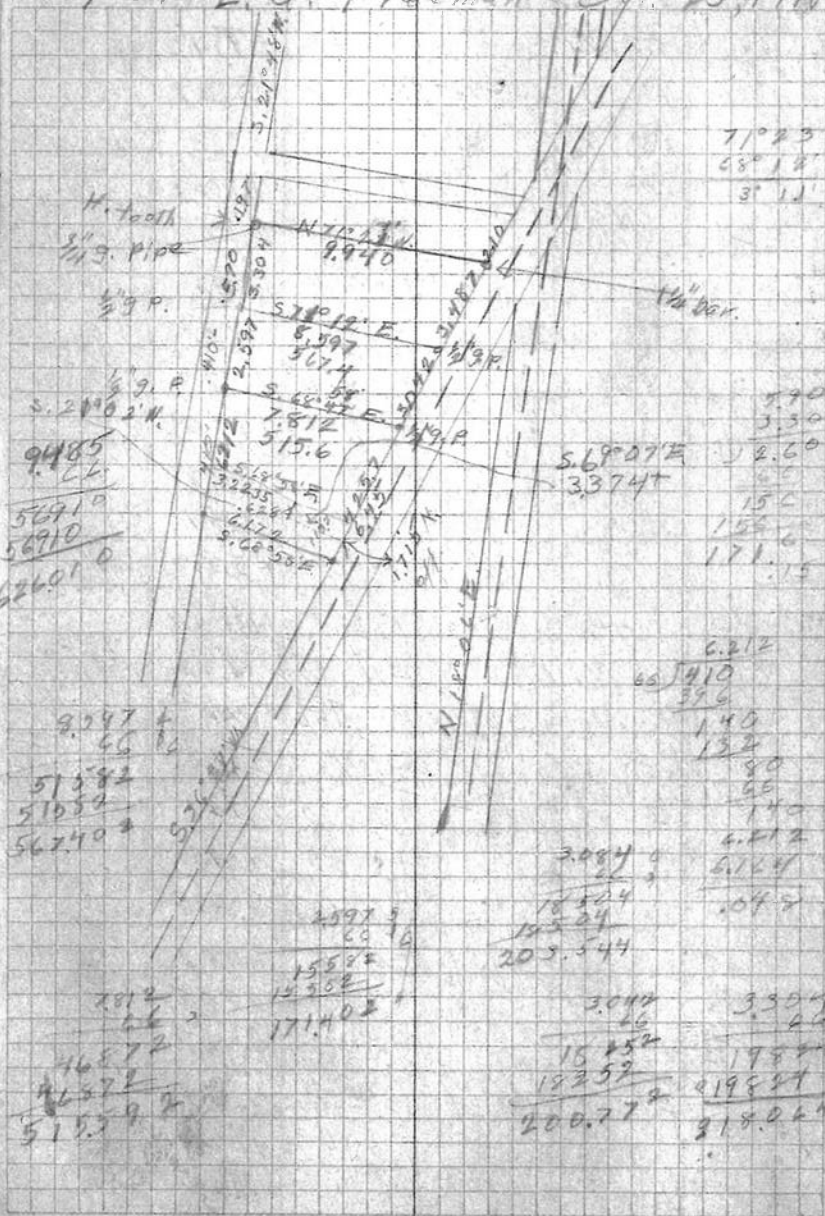

9047
66
51582
51552
56240

2597
66
15582
15702
171402

2012
66
46572
42572
51572

3084
18504
19224
205544
3044
16
18452
18252
200.77
3304
66
1984
01984
318.064

6212
66-1410
396
140
132
80
66
140
6412
6164
1042

71023
68187
3711
990
330
2.60
150
156.6
171.15