


RECORD OF SURVEY

for MONTGOMERY BROS CONSTRUCTION INC  
in THE JOSEPH C. ALEXANDER DLC No. 46  
NE 1/4 Sec. 11, T.12S., R. 5W., W. M.  
BENTON COUNTY, OREGON  
January 1978

05546  
DATE 1-27-78  
SHEET 8 1/2 x 14

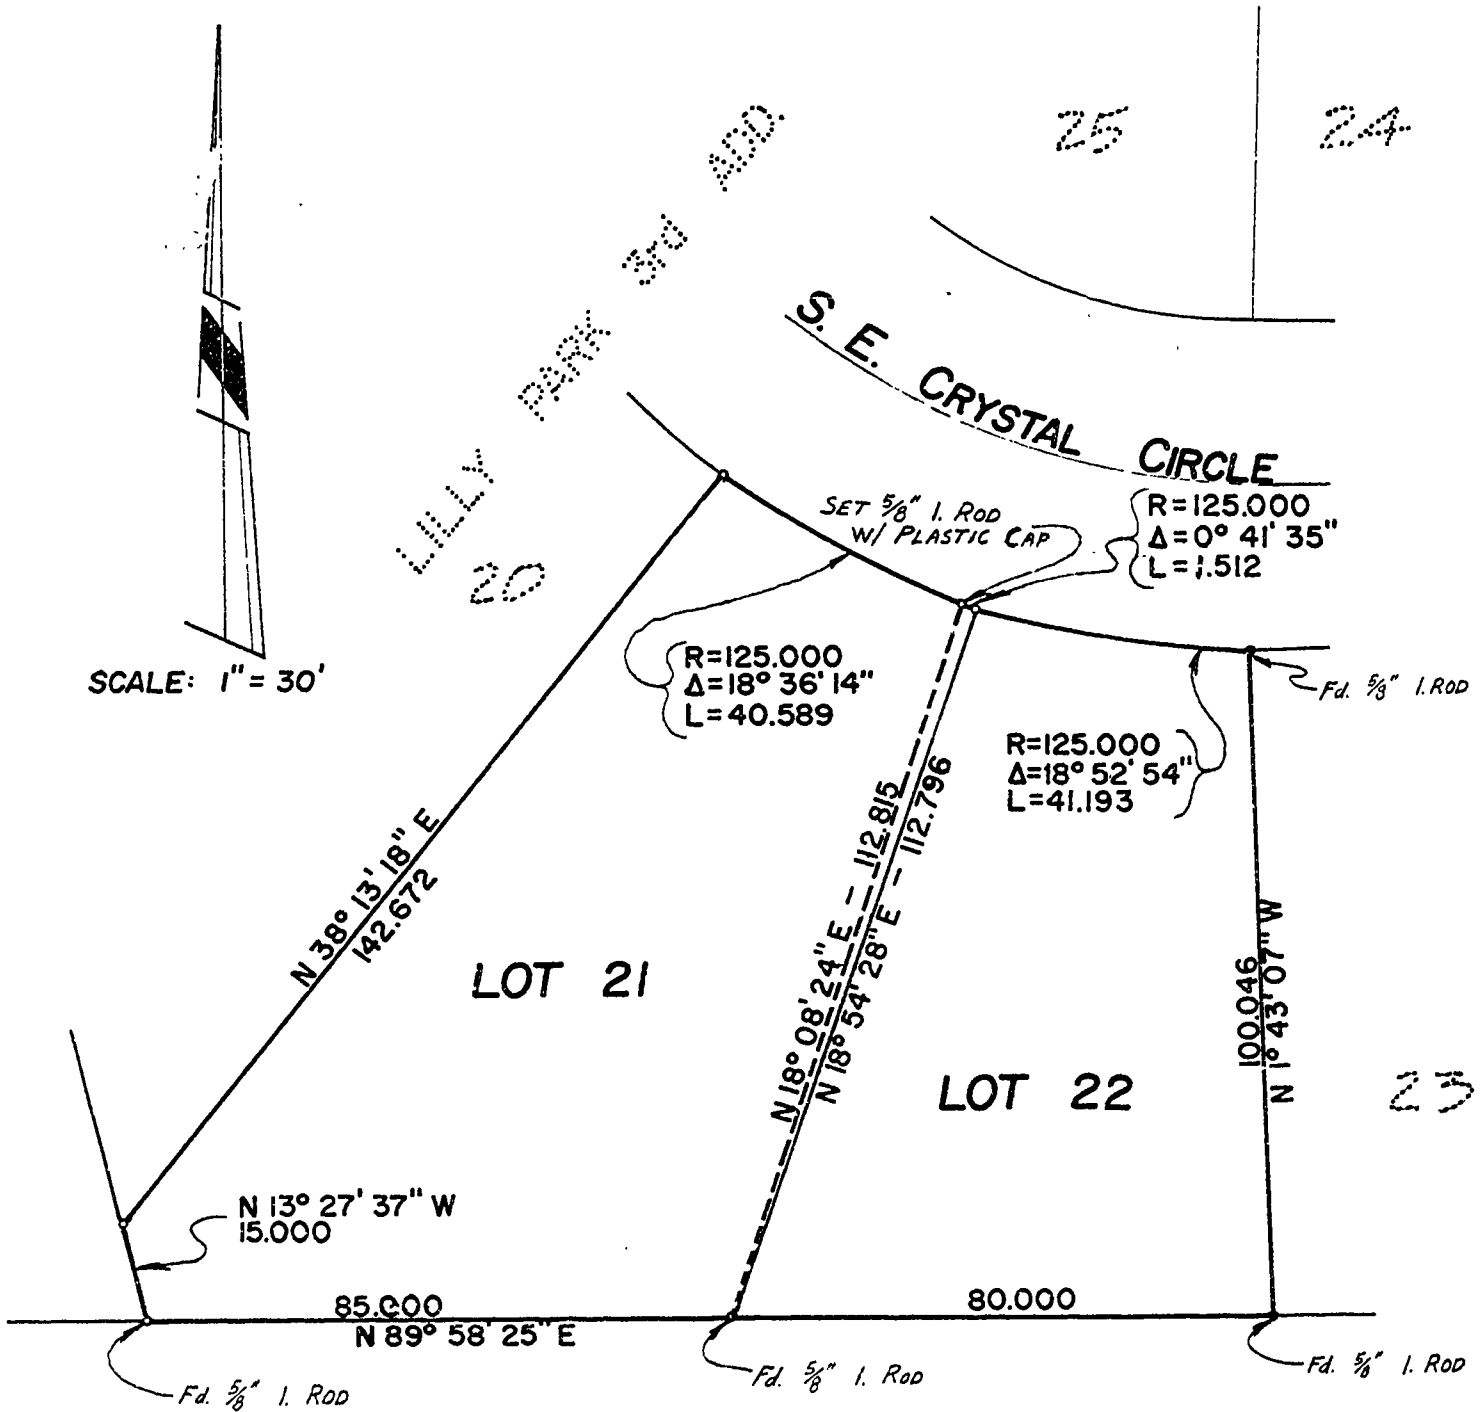

REGISTERED  
PROFESSIONAL  
LAND SURVEYOR

Glenn A. Ling  
OREGON  
SEPT 30, 1977  
GLENN A. LING  
1433