

Benton Co. Surveyors Office  
 C. S. FILE NO. 06619  
 FILING DATE 5-17-78  
 FILE SIZE 18-30x36  
KIT



Map of Survey For:

# FRED PLYMPTON

In the Southwest 1/4 of Section 1  
 Township 11 South, Range 5 West of the W.M.  
 Benton County, Oregon

Scale: 1" = 60'  
 Job No.: 77-343  
 Drawn by: V.M.V.  
 December 19, 1977

2 CURVE DATA:  
 R = 754.93'  
 Δ = 15° 48' 00"

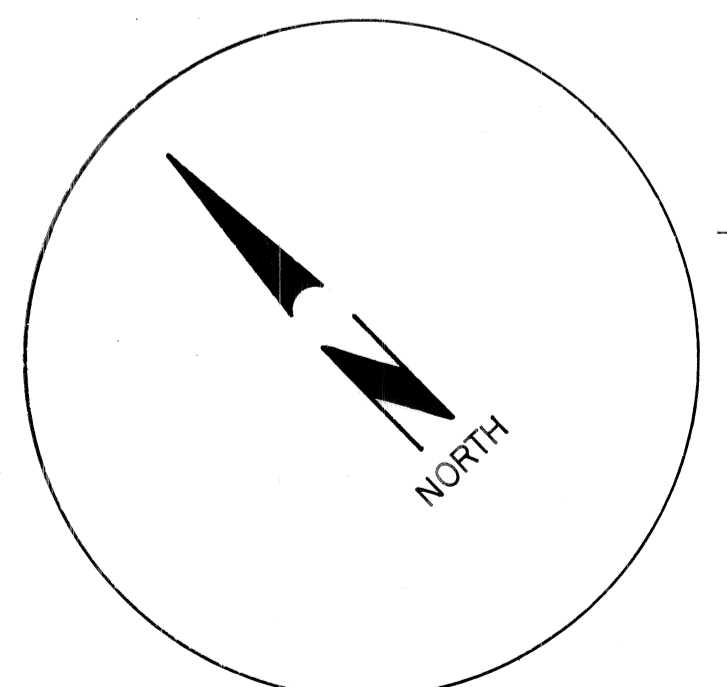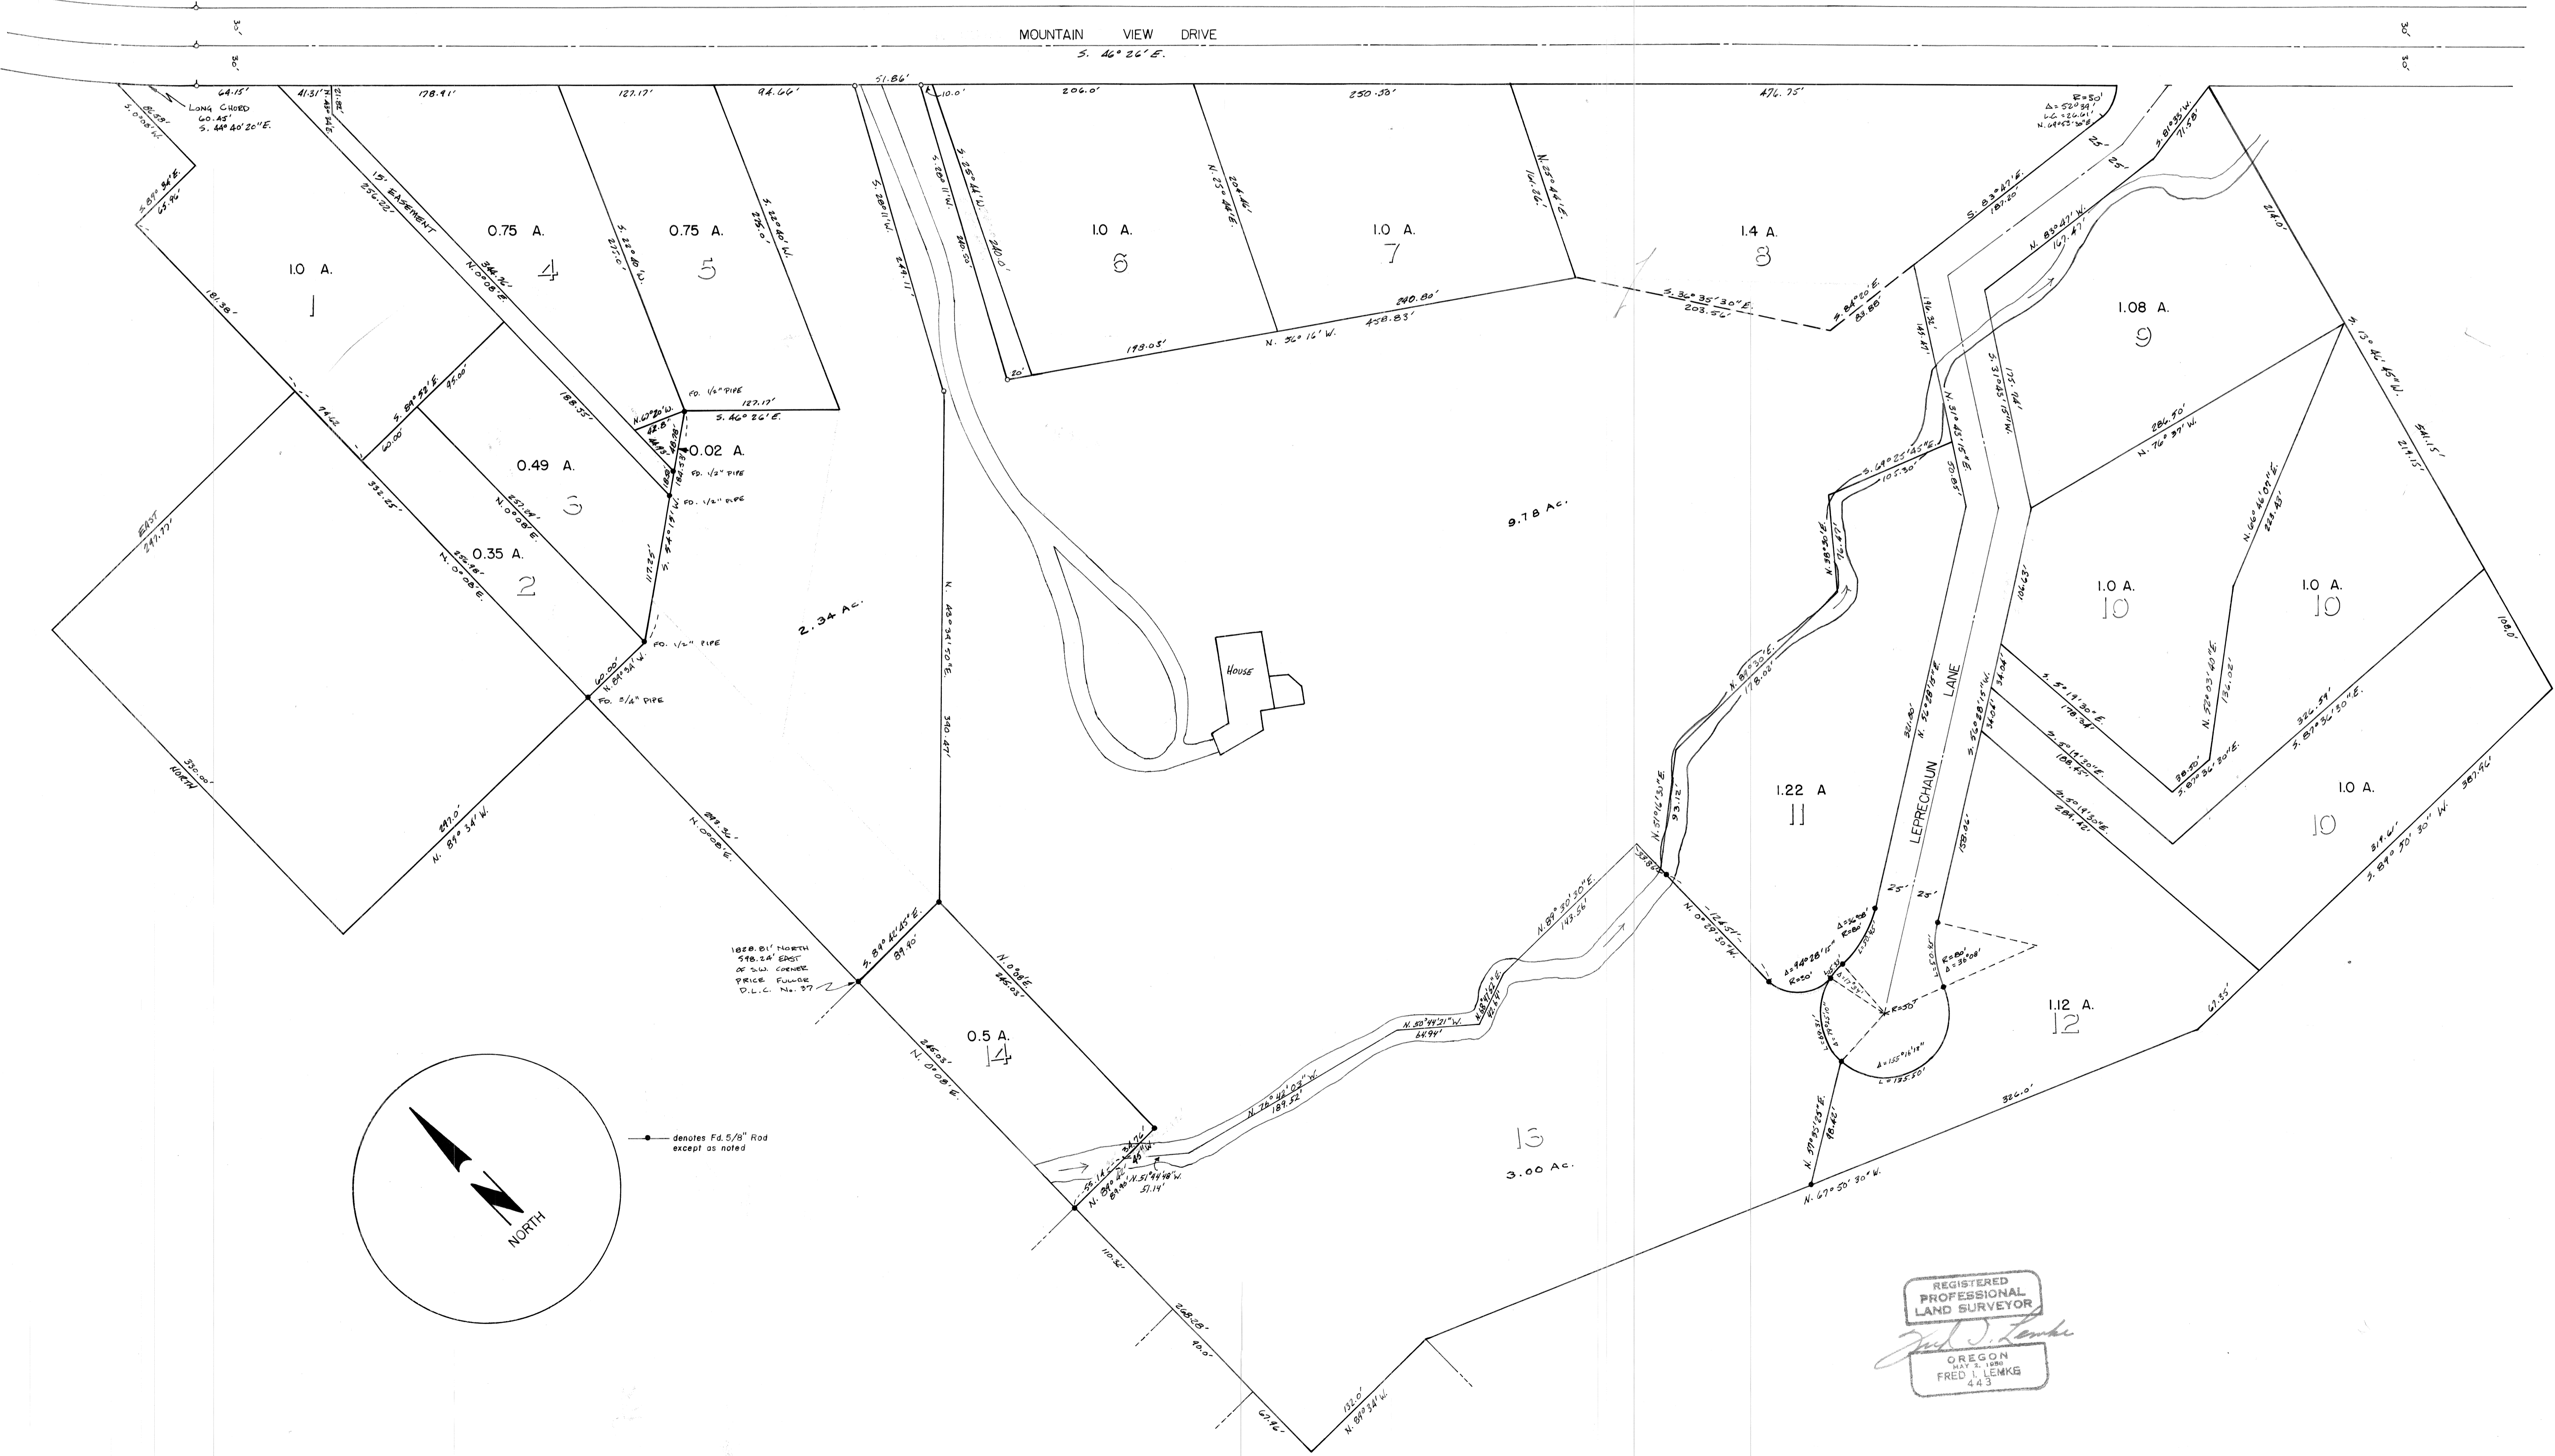

• denotes 5/8" Rod  
 except as noted

REGISTERED  
 PROFESSIONAL  
 LAND SURVEYOR  
 FRED L. LENKSB  
 OREGON  
 443

FRED PLYMPTON  
 12-19-77  
 77-343