


RECORD OF SURVEY

for GARY ENSCHEDE  
in LOT 8, FOREST SPRINGS ESTATES  
NW 1/4 Sec. 4, T. 11S., R. 5W., W.M.  
BENTON COUNTY, OREGON  
April 1978

00534  
5-17-78  
SHE 114

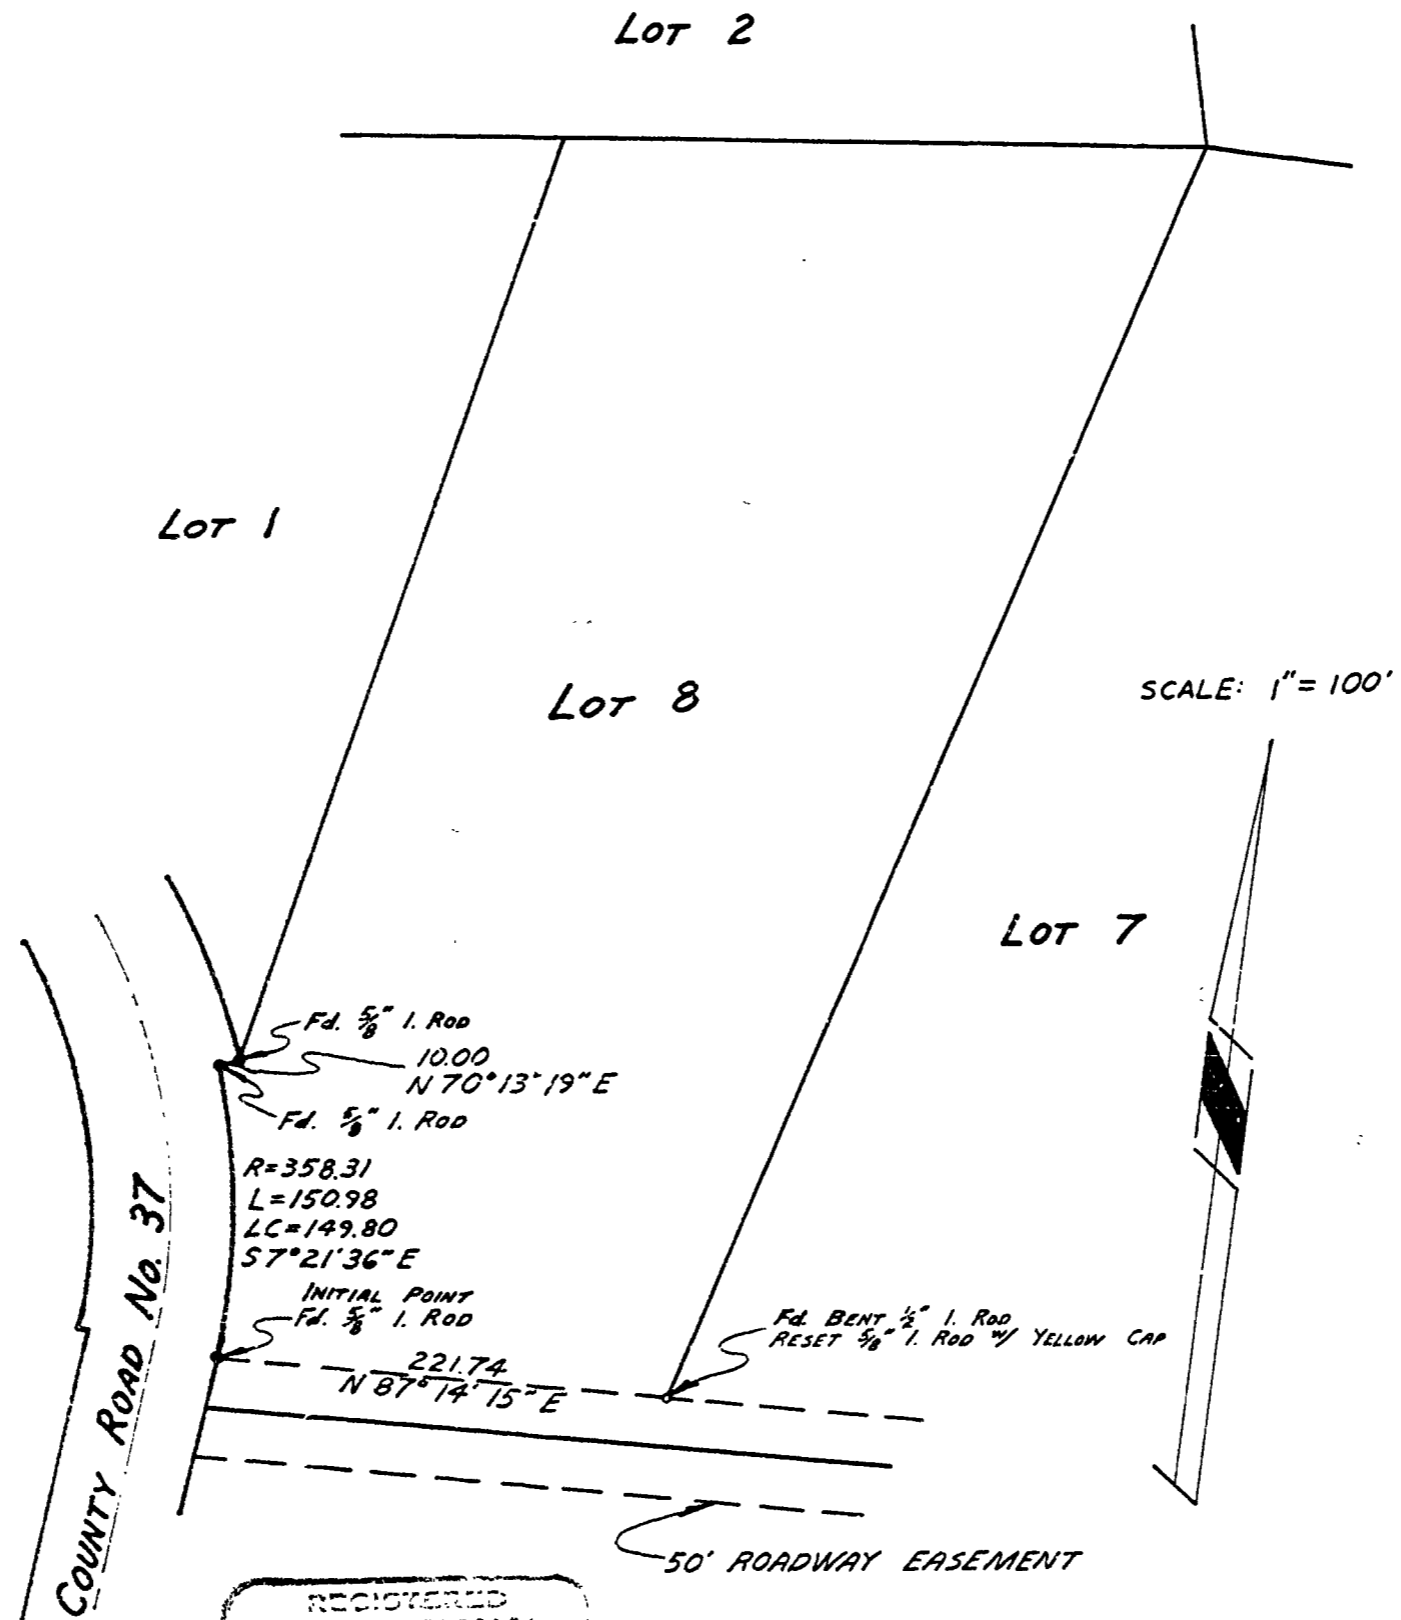

REGISTERED  
PROFESSIONAL  
LAND SURVEYOR

*Paul J. Green*

PAUL E. GREEN  
1981