


6739

RECORD OF SURVEY
 for **SANTANA PROPERTIES**
 in **CHARLES JOHNSON D.L.C. No. 40 &**
JAMES A. BENNETT D.L.C. No. 45
N.E. 1/4 SEC. 3, T. 12S., R. 5W., W. M.
BENTON COUNTY, OREGON
 SEPTEMBER 1978
 SCALE: 1"=50'

Benton Co. Surveyors Office
 C. S. FILE NO. **6739**
 FILING DATE **10-10-78**
 FILE SIZE **18"**

REGISTERED PROFESSIONAL LAND SURVEYOR
Jack R. Burrell
OREGON
 JACK R. BURRELL
 1630

LEGEND
 • FOUND MONUMENT, AS NOTED
 ○ SET 3/8" IRON ROD (EXCEPT AS NOTED) WITH PLASTIC CAP
 () RECORD DATA

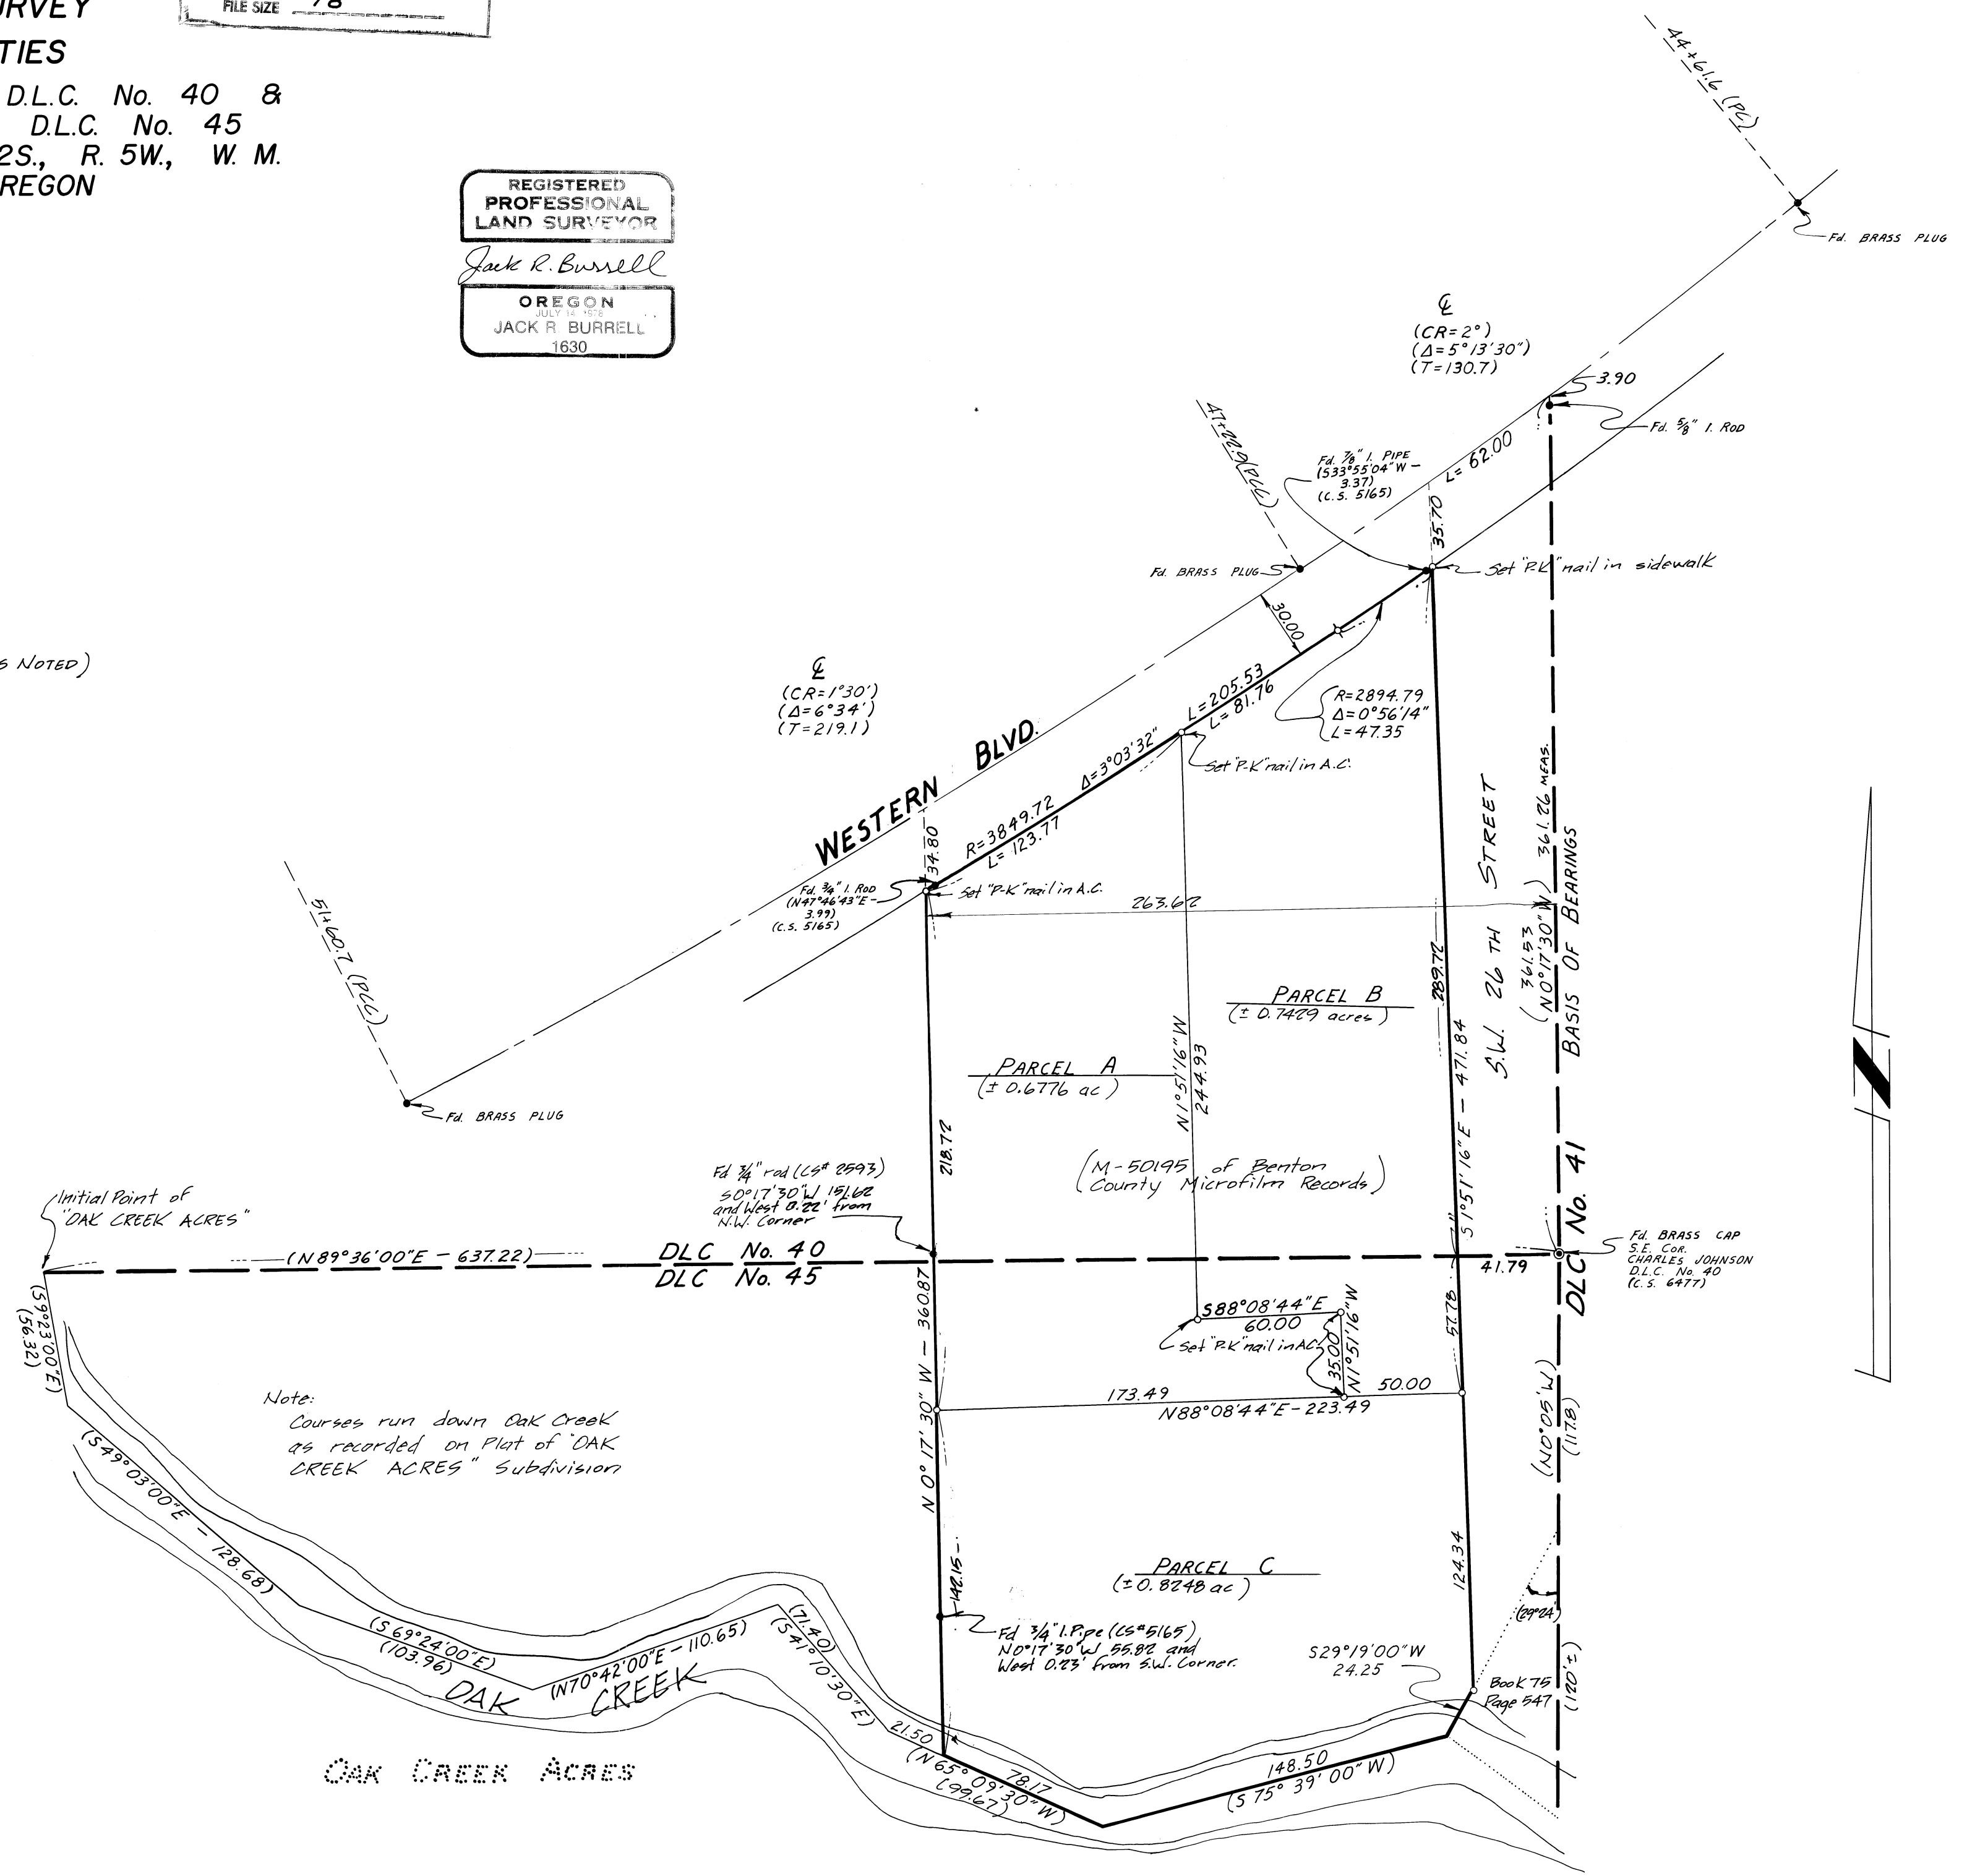

6739

6739