


RECORD OF SURVEY
for
BOB JORDAN
in

Benton Co. Surveyors Office

C. S. FILE NO. 6831
FIELDING DATE 1-22-79
FILE SIZE 8 1/2 x 14

5
N.E. 1/4, Sec. 18, T.11 S., R.4 W., W.M.
Benton County Oregon
Scale; 1" = 100' Jan. 20, 1979

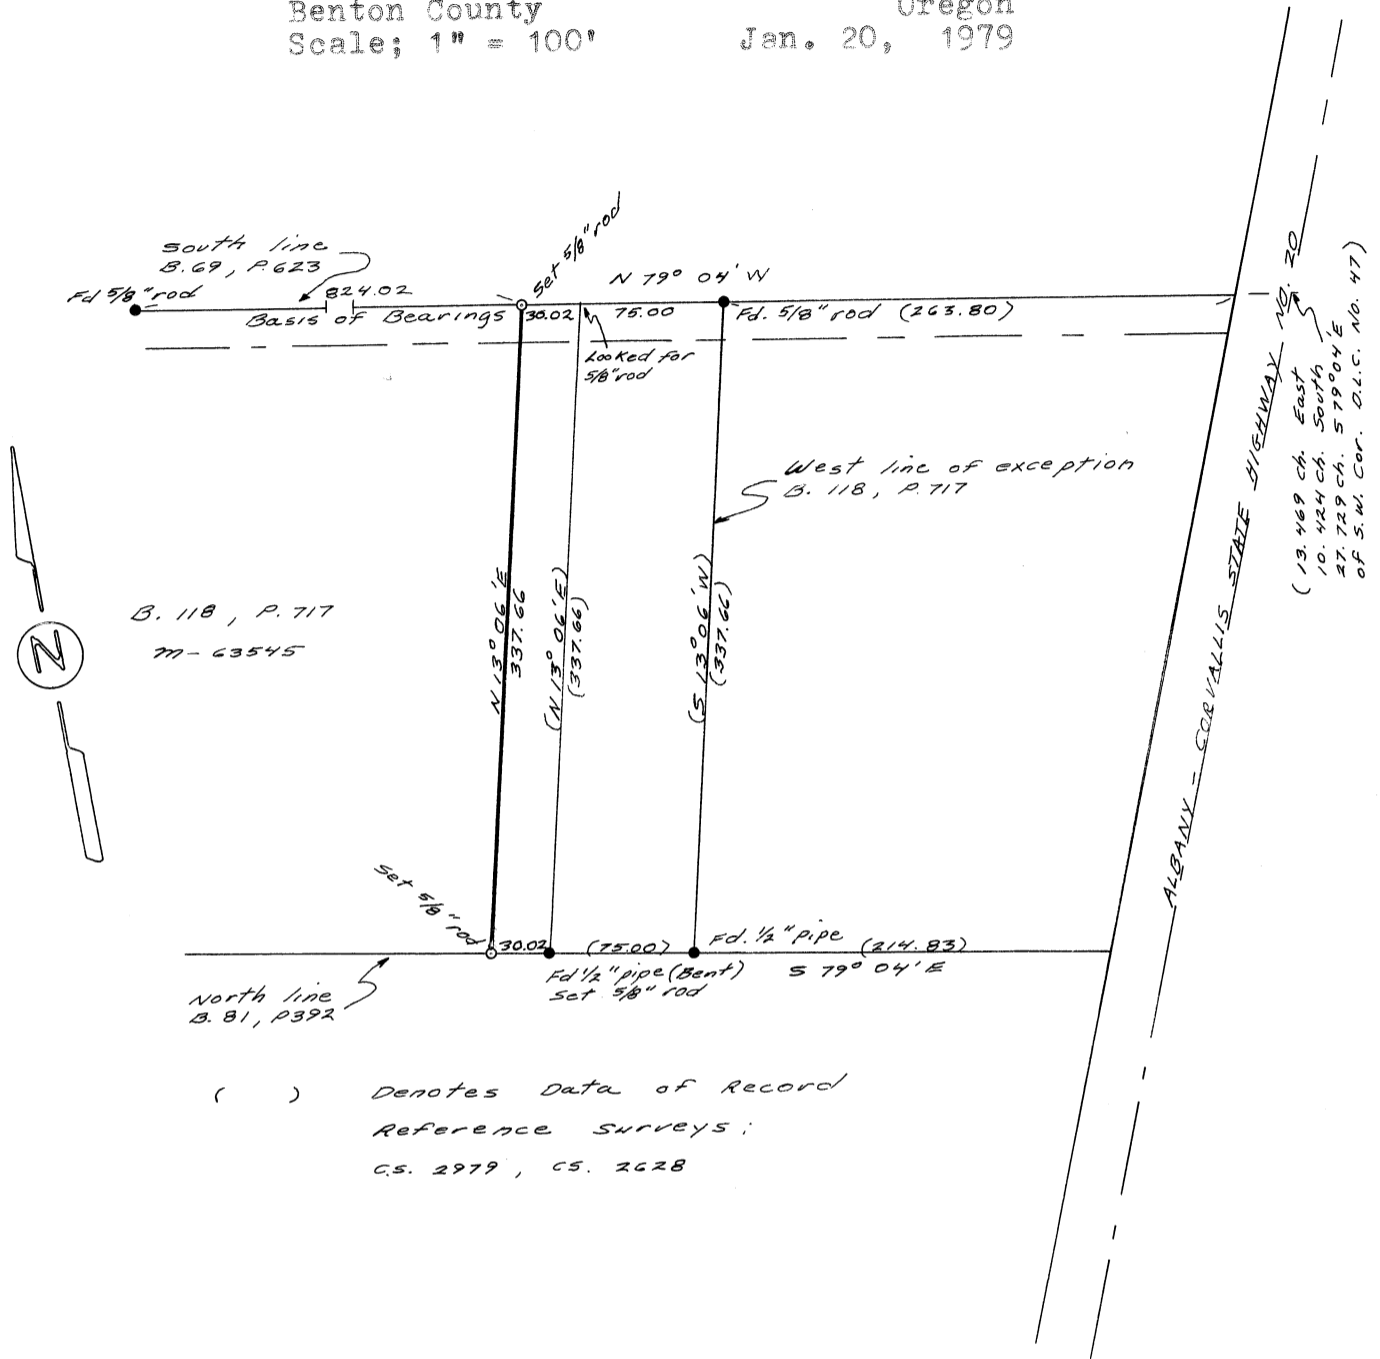

REGISTERED
PROFESSIONAL
LAND SURVEYOR

Darryl W. Harms

OREGON
JULY 30, 1976
DARRYL W. HARMS
1079