

DRAWING NUMBER  
**7292**

PLAN HOLD CORPORATION • IRVINE, CALIFORNIA  
REORDER BY NUMBER 075AR  
POSITION EDGE OF PRINT ON THIS LINE

DRAWING NUMBER  
**7292**


PLAN HOLD CORPORATION • IRVINE, CALIFORNIA  
REORDER BY NUMBER 075AR  
POSITION EDGE OF PRINT ON THIS LINE

DRAWING NUMBER  
**7292**

PLAN HOLD CORPORATION • IRVINE, CALIFORNIA  
REORDER BY NUMBER 075AR  
POSITION EDGE OF PRINT ON THIS LINE

DRAWING NUMBER  
**7292**


PLAN HOLD CORPORATION • IRVINE, CALIFORNIA  
REORDER BY NUMBER 075AR  
POSITION EDGE OF PRINT ON THIS LINE

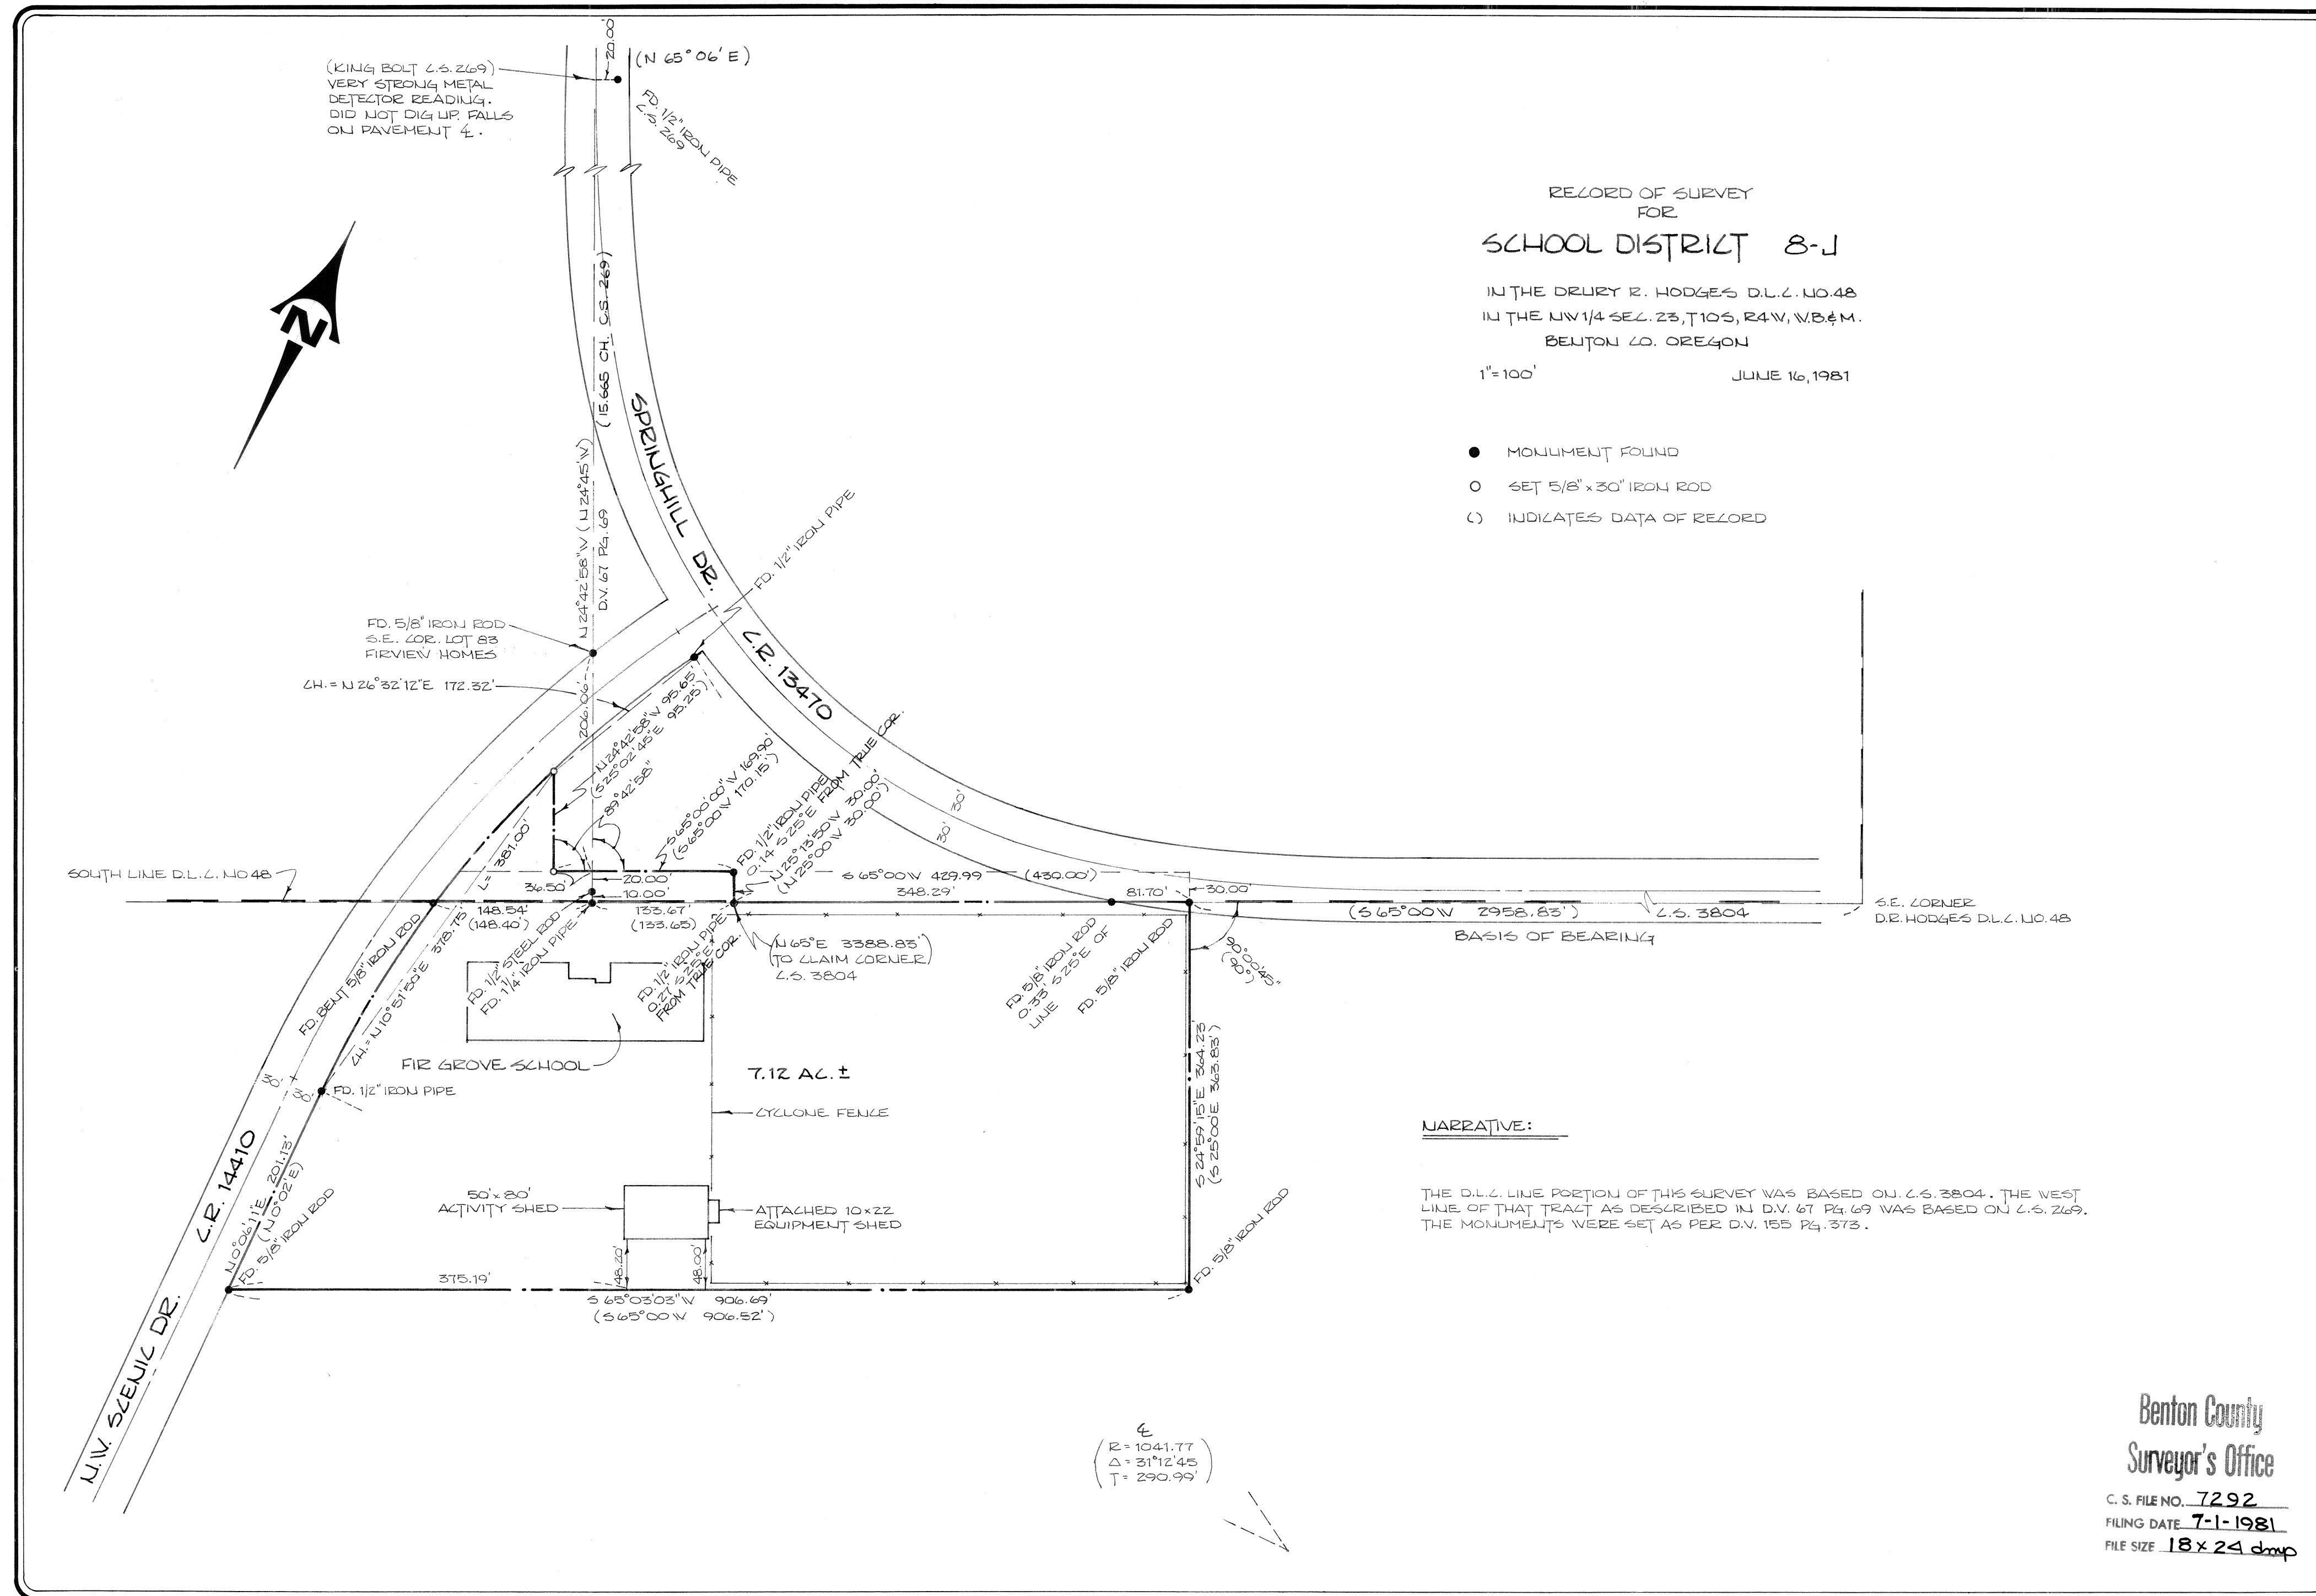

**KRAUS & DALKE CONSULTING ENGINEERS**  
276 N.W. HICKORY STREET — ALBANY, OREGON  
P.O. BOX 725 — 503-928-2583

STRUCTURAL — ENVIRONMENTAL  
LAND PLANNING — SURVEYING

GREATER ALBANY PUBLIC SCHOOLS  
FIR GROVE SCHOOL

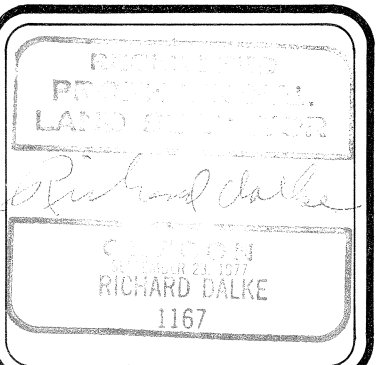

DSGN. BY:  
DWG. BY: L.M.L.  
CHK. BY:  
SCALE: 1" = 100'  
DATE: JUNE 16, 1981  
PROJECT NO.: 21-71

SHEET:  
ONE  
OF:  
ONE