


RECORD OF SURVEY
 FOR BILL GERWICK
 IN BLOCK 2, OAK HURST ADDITION
 SE 1/4 Section 28, Joseph Friedley D.L.C. No. 62
 T.11 S., R.5 W., W.M., Benton County, Oregon
 March 8, 1988
 SCALE 1" = 30'

Benton County
 Surveyor's Office
 C.S. FILE NO. 8108
 FILING DATE 3-10-1988
 SHEET 572 OF 14

LEGEND

- FOUND 5/8" IRON ROD
- SET 5/8" X 30" IRON ROD WITH YELLOW PLASTIC CAP MARKED L51102
- () DATA OF RECORD FROM PLAT OF "OAK HURST ADDITION"

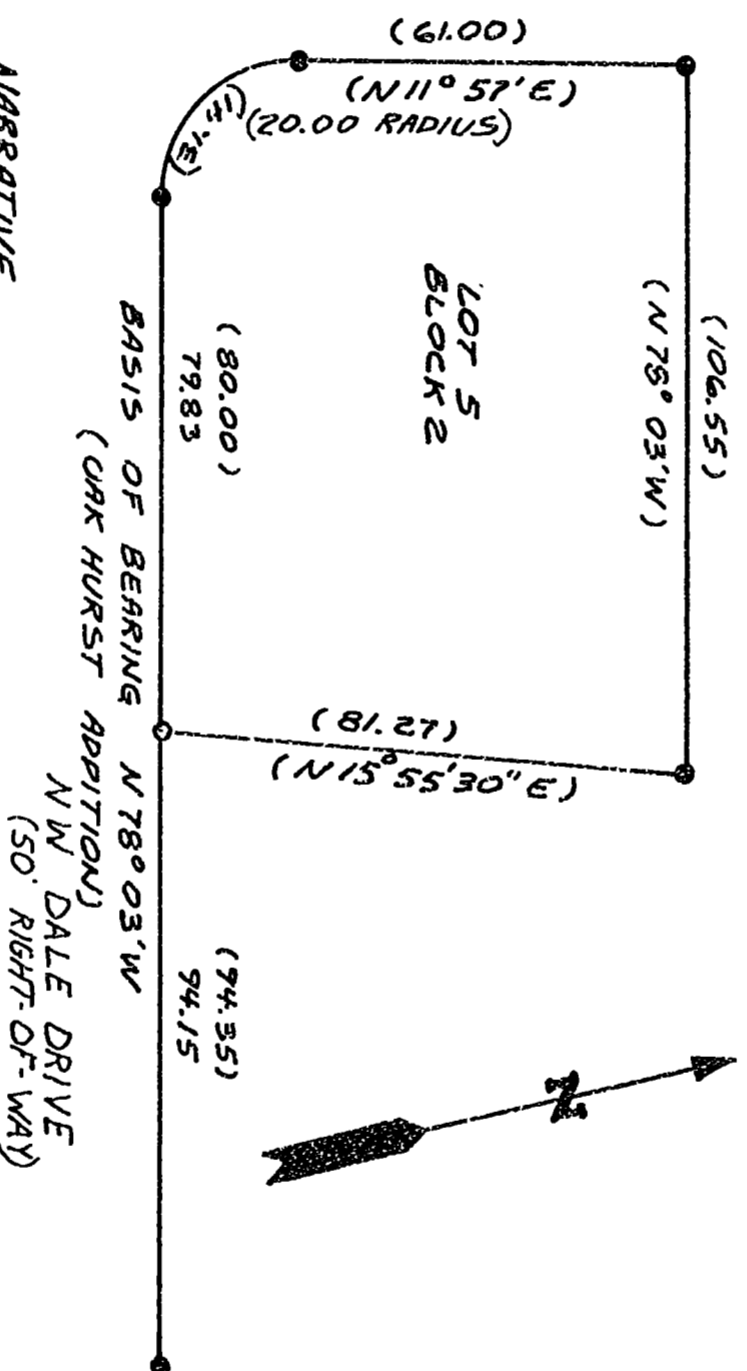

NARRATIVE

THIS SURVEY WAS DONE TO REMOUMENT THE SOUTHEAST CORNER OF LOT 5, BLOCK 2, "OAK HURST ADDITION". THE MONUMENT SET WAS PROPORTIONED BETWEEN FOUND MONUMENTS ALONG THE NORTHERLY LINE OF NW DALE DRIVE.

SPRINGER SURVEYING
 37056 MOSS ROCK DRIVE
 CORVALLIS, OREGON 97330
 PHONE: 745-5798

REGISTERED
 PROFESSIONAL
 LAND SURVEYOR
 Norman D. Springer
 OREGON
 NORMAN D. SPRINGER
 1102