

DRAWING NUMBER
8404


PLAN HOLD CORPORATION • IRVINE, CALIFORNIA
 REORDER BY NUMBER 075AR
 POSITION EDGE OF PRINT ON THIS LINE

DRAWING NUMBER
8404

PLAN HOLD CORPORATION • IRVINE, CALIFORNIA
 REORDER BY NUMBER 075AR
 POSITION EDGE OF PRINT ON THIS LINE

Benton County
 Surveyor's Office
 C.S. FILE NO. **8404**
 FILING DATE **5-10-90**
 FILE SIZE **11x17**

N.W. VALLEY VIEW DRIVE
 COUNTY RD 04441

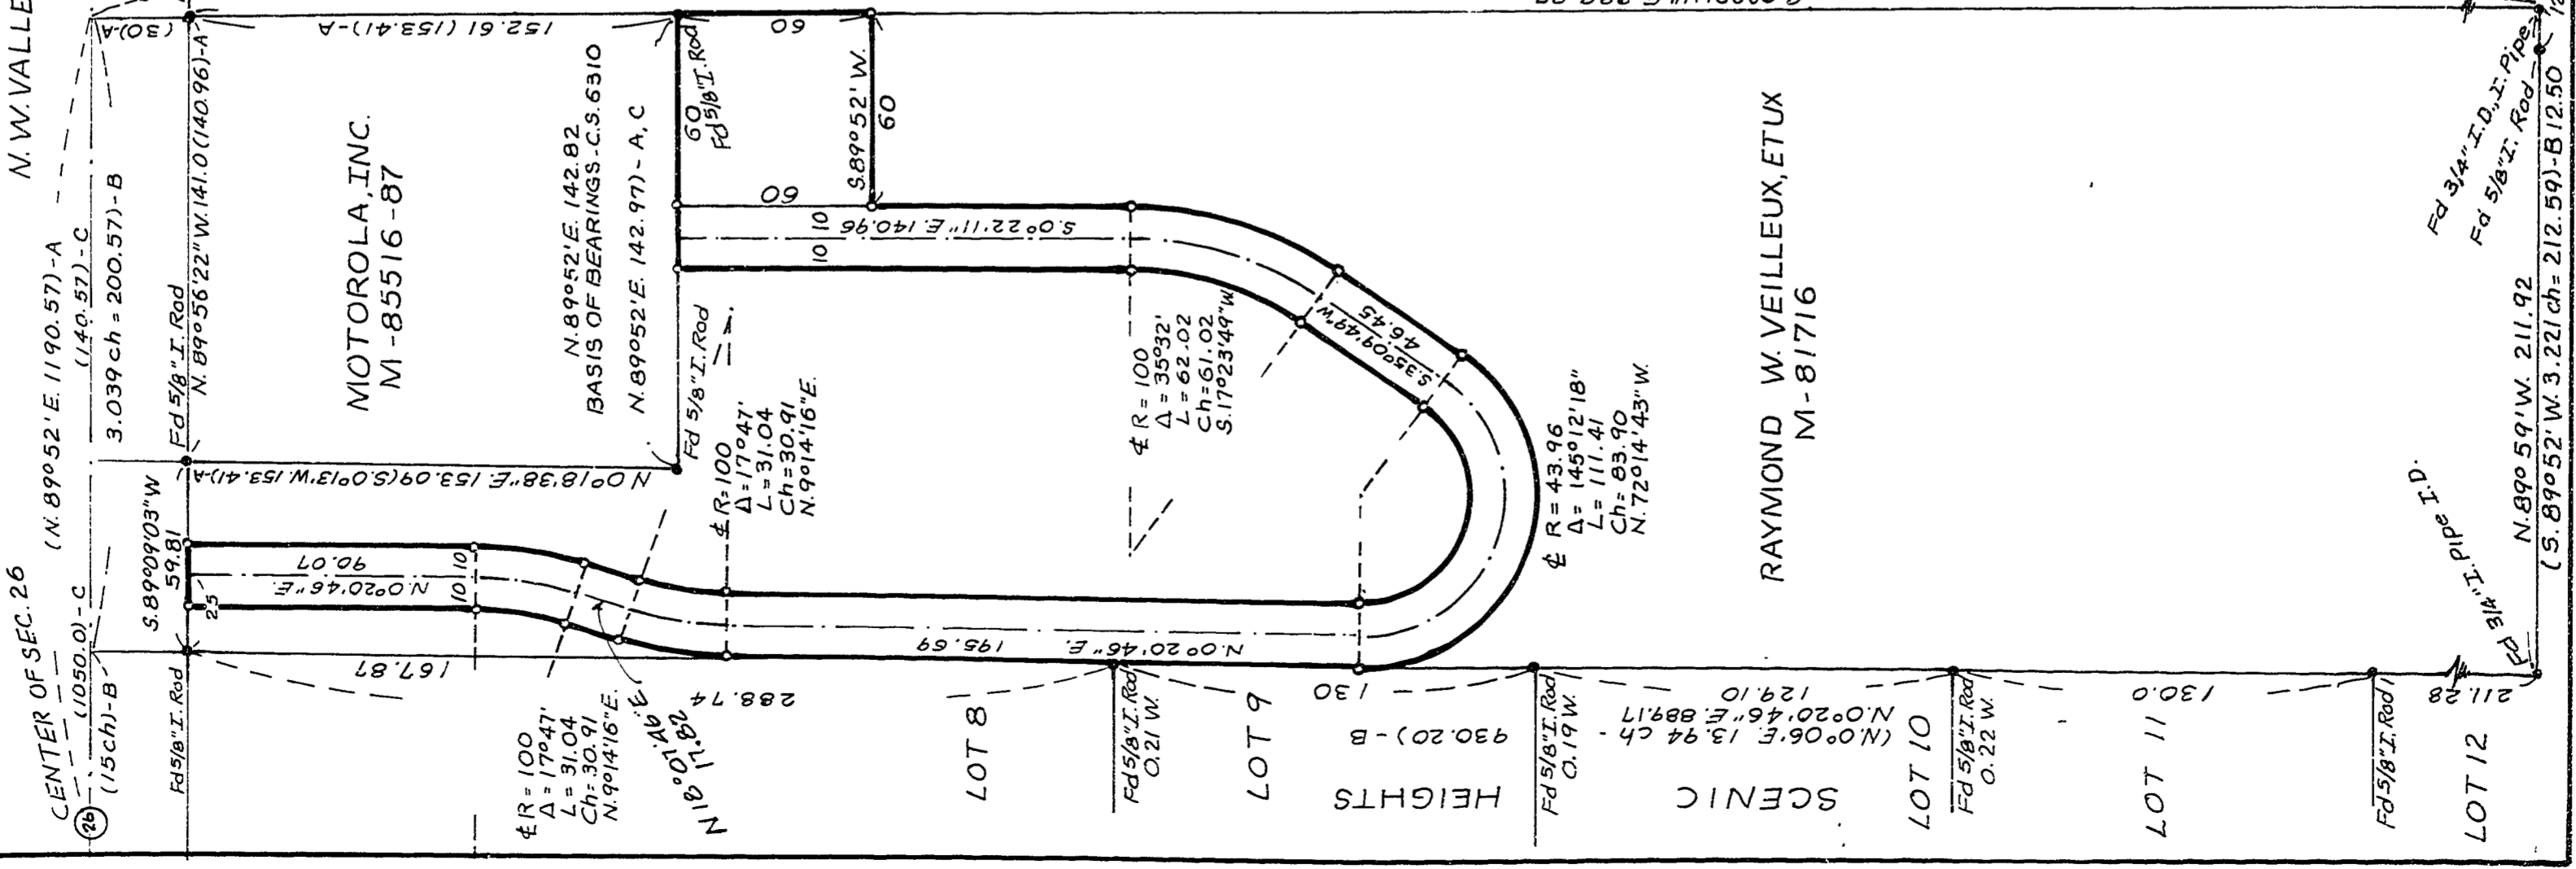

24 14

