


Block 15 S49
ORIGINAL TOWN OF MARYSVILLE ADDITION
CITY OF CORVALLIS

Survey Made for:-
Riley & Meier
By: W.C. Galloway Jr.
Willard Simpson ck.
Sept. 1922

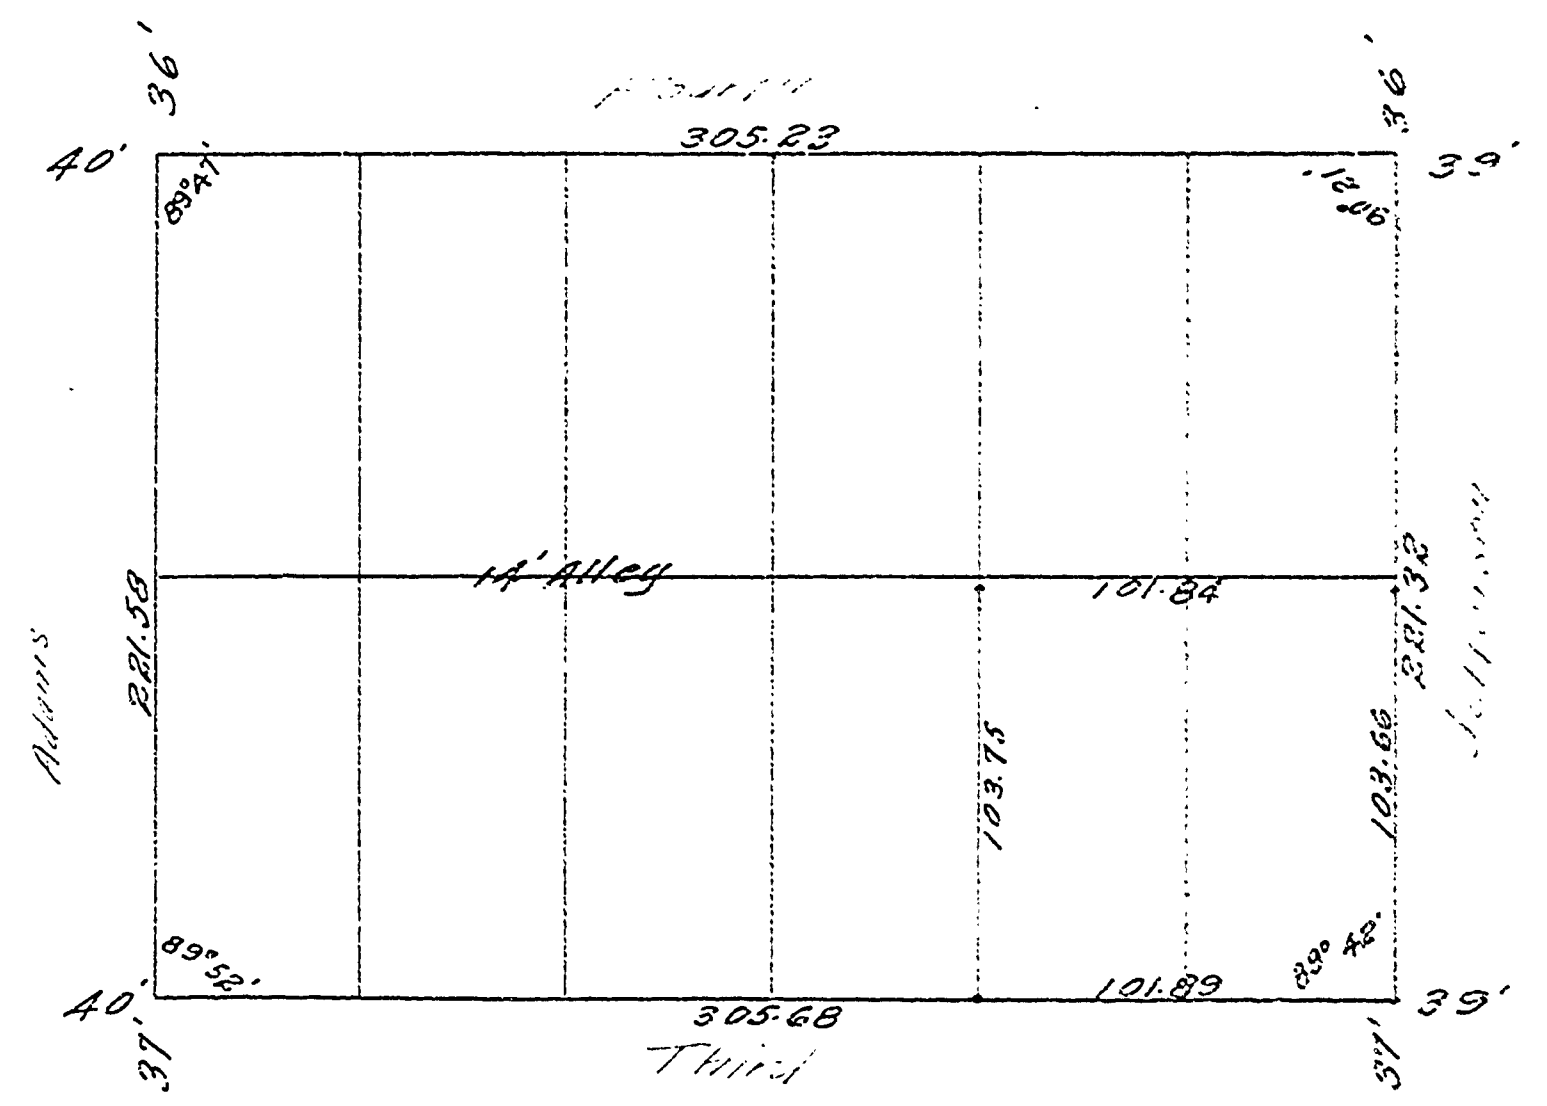

BLOCK 15

849

ORIGINAL TOWN OF NARISVILLE ADDITION

CITY OF CORVALLIS

Survey Made for:-

Riley & Meier

By: W.C. Galloway &

Willard Simpson et al.

Sept. 1922

