

107340100

CORNER FILE TRACKING

S:\Survey Corners\CORNERS\Templates\Filetrac2.doc
10/04/2010

CORNER NUMBER
107340100

STEP	HISTORY	RESTORATION
Form Prepared, DB	2/10/17	3/13/17
Field Inspection, DB	3/10/17	3/10/17
Finish index (count unit)	2/10/17	3/13/17
Counter Index		
GIS Index Form	3/13/17	3/13/17
Checked, DB	3/14/17	3/14/17
Form Edited, DB	3/14/17	3/14/17
Form Signed, DB	3/14/17	3/14/17
Authorize Payment, DB	—	—
Archive Digital Files	3/14/17	3/14/17
Collect Documents	3/14/17	3/14/17
PDF File	3/14/17	3/14/17
Copy For Filming	3/14/17	3/14/17
Scanned (pdf to laserfiche)	3/14/17	3/14/17
Filmed (Archived), DB		
Filed, DB		

(DB) = Entry needed in database (Access).

COMMENTS:

BENTON COUNTY CORNER HISTORY FORM, PAGE 1 OF 1, 107340100H

DATE 02/09/2017

TOWNSHIP 10 SOUTH, RANGE 7 WEST, WILLAMETTE MERIDIAN; SECTION 33 CORNER SOUTH 1/4
DONATION LAND CLAIM N/A CORNER N/A

COMMON CORNER(S):

POINT ON NORTH LINE OF SECTION 4, TOWNSHIP 11 SOUTH, RANGE 7 WEST


RECORDS (INFORMATION IN BOLD ITALICS IS COUNTY STAFFS' INTERPRETATION OF THE RECORD)

BASED ON EXTENSIVE RESEARCH AND RECOVERY OF EVIDENCE, THIS OFFICE HAS DETERMINED THAT MOST GENERAL LAND OFFICE SURVEYORS IN BENTON COUNTY MEASURED TO THE FACE OF BEARING TREES.

- [01] GENERAL LAND OFFICE (GLO) NOTES BY DENNIS HATHORN, D.S., DATED DECEMBER 5, 1856. SET POST FROM WHICH A BURNT FIR 18" DIA BEARS ***N58°W, 29 LINKS (19.14 FEET)***; BURNT FIR 30" DIA BEARS ***S61°E, 46 LINKS (30.36 FEET)***.
- [02] BENTON COUNTY SURVEY NO. 535 (OLD NO. 247) FIELD NOTES (FIELD BOOK 20, PAGE 58) BY W. C. GALLOWAY, C.S., DATED DECEMBER 14, 1915. SET CEDAR POST 5" X 7" X 36". FIR 20" DIA BEARS ***N30°30'E, 0.095 CHAINS (6.27 FEET)***; BURNT FIR 30" DIA (GLO BT) BEARS ***S61°E, 0.46 CHAINS (30.36 FEET) STANDING; FIR 24" DIA BEARS S16°E, 0.137 CHAINS (9.04 FEET)***.
- [03] BENTON COUNTY CORNER RESTORATION BOOK NO. 1, PAGE 101, BY W. C. GALLOWAY, C.S., DATED DECEMBER 16, 1915. SET CEDAR POST 5" X 7" X 36". FIR 20" DIA BEARS ***N30°30'E, 0.095 CHAINS (6.27 FEET)***; FIR 30" DIA (GLO BT) BEARS ***S61°E, 0.46 CHAINS (30.36 FEET) STANDING BURNT; FIR 24" DIA BEARS S16°E, 0.137 CHAINS (9.04 FEET)***.
- [04] BENTON COUNTY CORNER RESTORATION NO. 589. TRANSCRIBED FROM RECORD [03] AND MAY CONTAIN ERRORS AND/OR OMISSIONS.
- [05] BENTON COUNTY MAP NO. 10-7-00018 BY W. C. GALLOWAY, C.S., DATED DECEMBER 20, 1915. CEDAR POST 5" X 7" X 36". FIR 20" DIA BEARS ***N30°30'E, 0.095 CHAINS (6.27 FEET)***; BURNT FIR 30" DIA (GLO BT) BEARS ***S61°E, 0.46 CHAINS (30.36 FEET) STANDING; FIR 24" DIA BEARS S16°E, 0.137 CHAINS (9.04 FEET)***.
- [06] BENTON COUNTY SURVEY NO. 8855 BY MARK E. STEELE, P.L.S., DATED JUNE 28, 1994. SEARCHED FOR AND DID NOT FIND THE SOUTH 1/4 OF SECTION 33.

COMMENTS FROM 03/10/2017:

W. C. GALLOWAY, C.S., RESTORED THIS SOUTH 1/4 CORNER FROM AN ORIGINAL BEARING TREE IN 1915 WHILE SURVEYING THE NORTH-SOUTH CENTER LINE OF SECTION 33. MARK E. STEELE, P.L.S., SEARCHED FOR THIS SOUTH 1/4 CORNER WHILE SURVEYING THE NORTH LINE OF SECTION 4 IN 1994, BUT FOUND NO EVIDENCE OF THE CORNER. BY COMPARING THE ORIGINAL GENERAL LAND OFFICE (GLO) MEASUREMENTS TO THE SURVEY WORK PERFORMED BY THE COUNTY SURVEYOR'S OFFICE AND MARK STEELE, I WAS ABLE TO CALCULATE A SEARCH POSITION MEASURING FROM THE W1/16 CORNER SET BY MARK STEELE ON THE NORTH LINE OF SECTION 4. I WAS NOT ABLE TO LOCATE ANY EVIDENCE OF THE SOUTH 1/4 CORNER. THERE ARE NO FIR TREES AND VERY FEW FIR TREE REMAINS IN THE IMMEDIATE SEARCH AREA. THIS CORNER HAS BEEN DETERMINED TO BE LOST UNLESS MORE DEFINITIVE EVIDENCE CAN BE LOCATED.

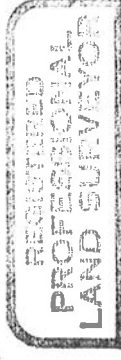

03/14/17 *David L. Malone*



REVIEW DATE 12/21/2018

FIRM/AGENCY: BENTON COUNTY SURVEYOR'S OFFICE
ADDRESS: 360 S.W. AVERY AVE., CORVALLIS, OR 97333; PH. 541-766-6821
RESEARCH BY: DAVID L. MALONE, P.L.S.
DATA ENTRY BY: SAME

CORNER RESTORATION BOOK NO. 1

County Survey #446

S.E. cor. of James Wood C1.# 66 T. 11 S. R. 6 W.
Set 1 1/2" x 1 1/8" iron pin with glass orig. cor. orig. trees are now stumps.
W. Fir 7" in dia. bears N. 20° E. 0 58 cks.
R. " 28" " " S. 25° 30' E. 275 "
W. " 12" " " N. 55° 40' W. 446 "
Witnesses A.J. Price, W.R. Read, R.E. Nelson & B.M. LaBoer Dec. 7 1915.

Corner to 16, 17, 20 & 21 T. 11 S. R. 6 W.
Set Qt. bottle 14" under surface S.E. oak gone.
Oak 50" in dia. bears N. 72° 30' E. 476 cks. std.
" 16" " " S. 47° W. 246 "
Witnesses as above Dec. 3, 1915.

1/4 sec. corner between secs. 15 & 16 T. 11 S. R. 6 W.
Set 7/8" x 1 1/2" x 35" iron bar N.W. tree down
Orig. Oak 18" in dia. bears N. 17° E. 3.02 cks. std.
Fir 5" " " N. 59° 30' E. 210 "
Witnesses A.J. Price W.R. Read & B.M. LaBoer Dec. 4 1915.

Corner to secs. 15, 16, 21 & 22 T. 11 S. R. 6 W.
Set 7/8" x 1 1/2" x 30" iron bar with glass
Stone mound stone scattered a little
Witnesses as last corner Dec. 4, 1915.

1/4 sec. cor. between secs. 16 & 21 T. 11 S. R. 6 W.
Set 7/8" x 2" x 32" iron bar
Orig. Oak 18" in dia. bears N. 22° E. 48 cks. std.
" 18" " " S. 52° W. 217 "
Witnesses A.J. Price & W.R. Read Dec. 6, 1915.

CS #446 is copy
issued on page 106
9152
CS # 247
W.E. Gallinger CS.

1/4 sec. cor. between secs. 33 & 34 T. 10 S. R. 7 W. ^{golf field, holes do not fit at all.}
Set Qt. bottle in place of old stake with letters on
orig. Maple 10" in dia. bears S. 66° E. 515 cks. to face.
orig. Fir 12" " " S. 46° W. 542 "
Witnesses James Stenback, A.B. Wetherford & Hiram Parker. ^{Dec. 14 1915}

1/4 sec. cor. between secs. 32 & 33 T. 10 S. R. 7 W.
Set ^{dig for cor. orig. witness trees dead.}
Fir 22" in dia. bears S. 81° 30' W. 362 cks.
" 15" " " N. 13° W. 413 "
Witnesses as above Dec. 15, 1915.

1/4 sec. corner on the south of sec. 33, 2nd stn. parallel T. 10 S. R. 7 W.
Set a cedar post 5" x 7" x 36"
Fir 20" in dia. bears N. 30° 30' E. 095 cks.
orig. " 30" " " S. 61° E. 46 "
" 24" " " S. 16° E. 137 "
Witnesses as above Dec. 16, 1915.



1/4-Section corner on the south of Section 33, 2nd std. parallel, Twp. 10-7

Reestablishment by W. C. Galloway

December 16, 1915

Set a Cedar post 5" x 7" x 36"

Fir 20" in diam bears N 30° 30' E

Fir 30" in diam bears S 61° E

Fir 24" in diam bears S 16° E

.095 chains

.46 chains(std. burnt)

.137 chains

Witnesses James Stenback, A. B. Whatherford, Hiram Parker, and Henry Oleman