


PLAT
OF
SURVEY NUMBER 189

T.10SR4W. Will. Mer.

scale 1"=8chs

W.C. Galloway, C.S.

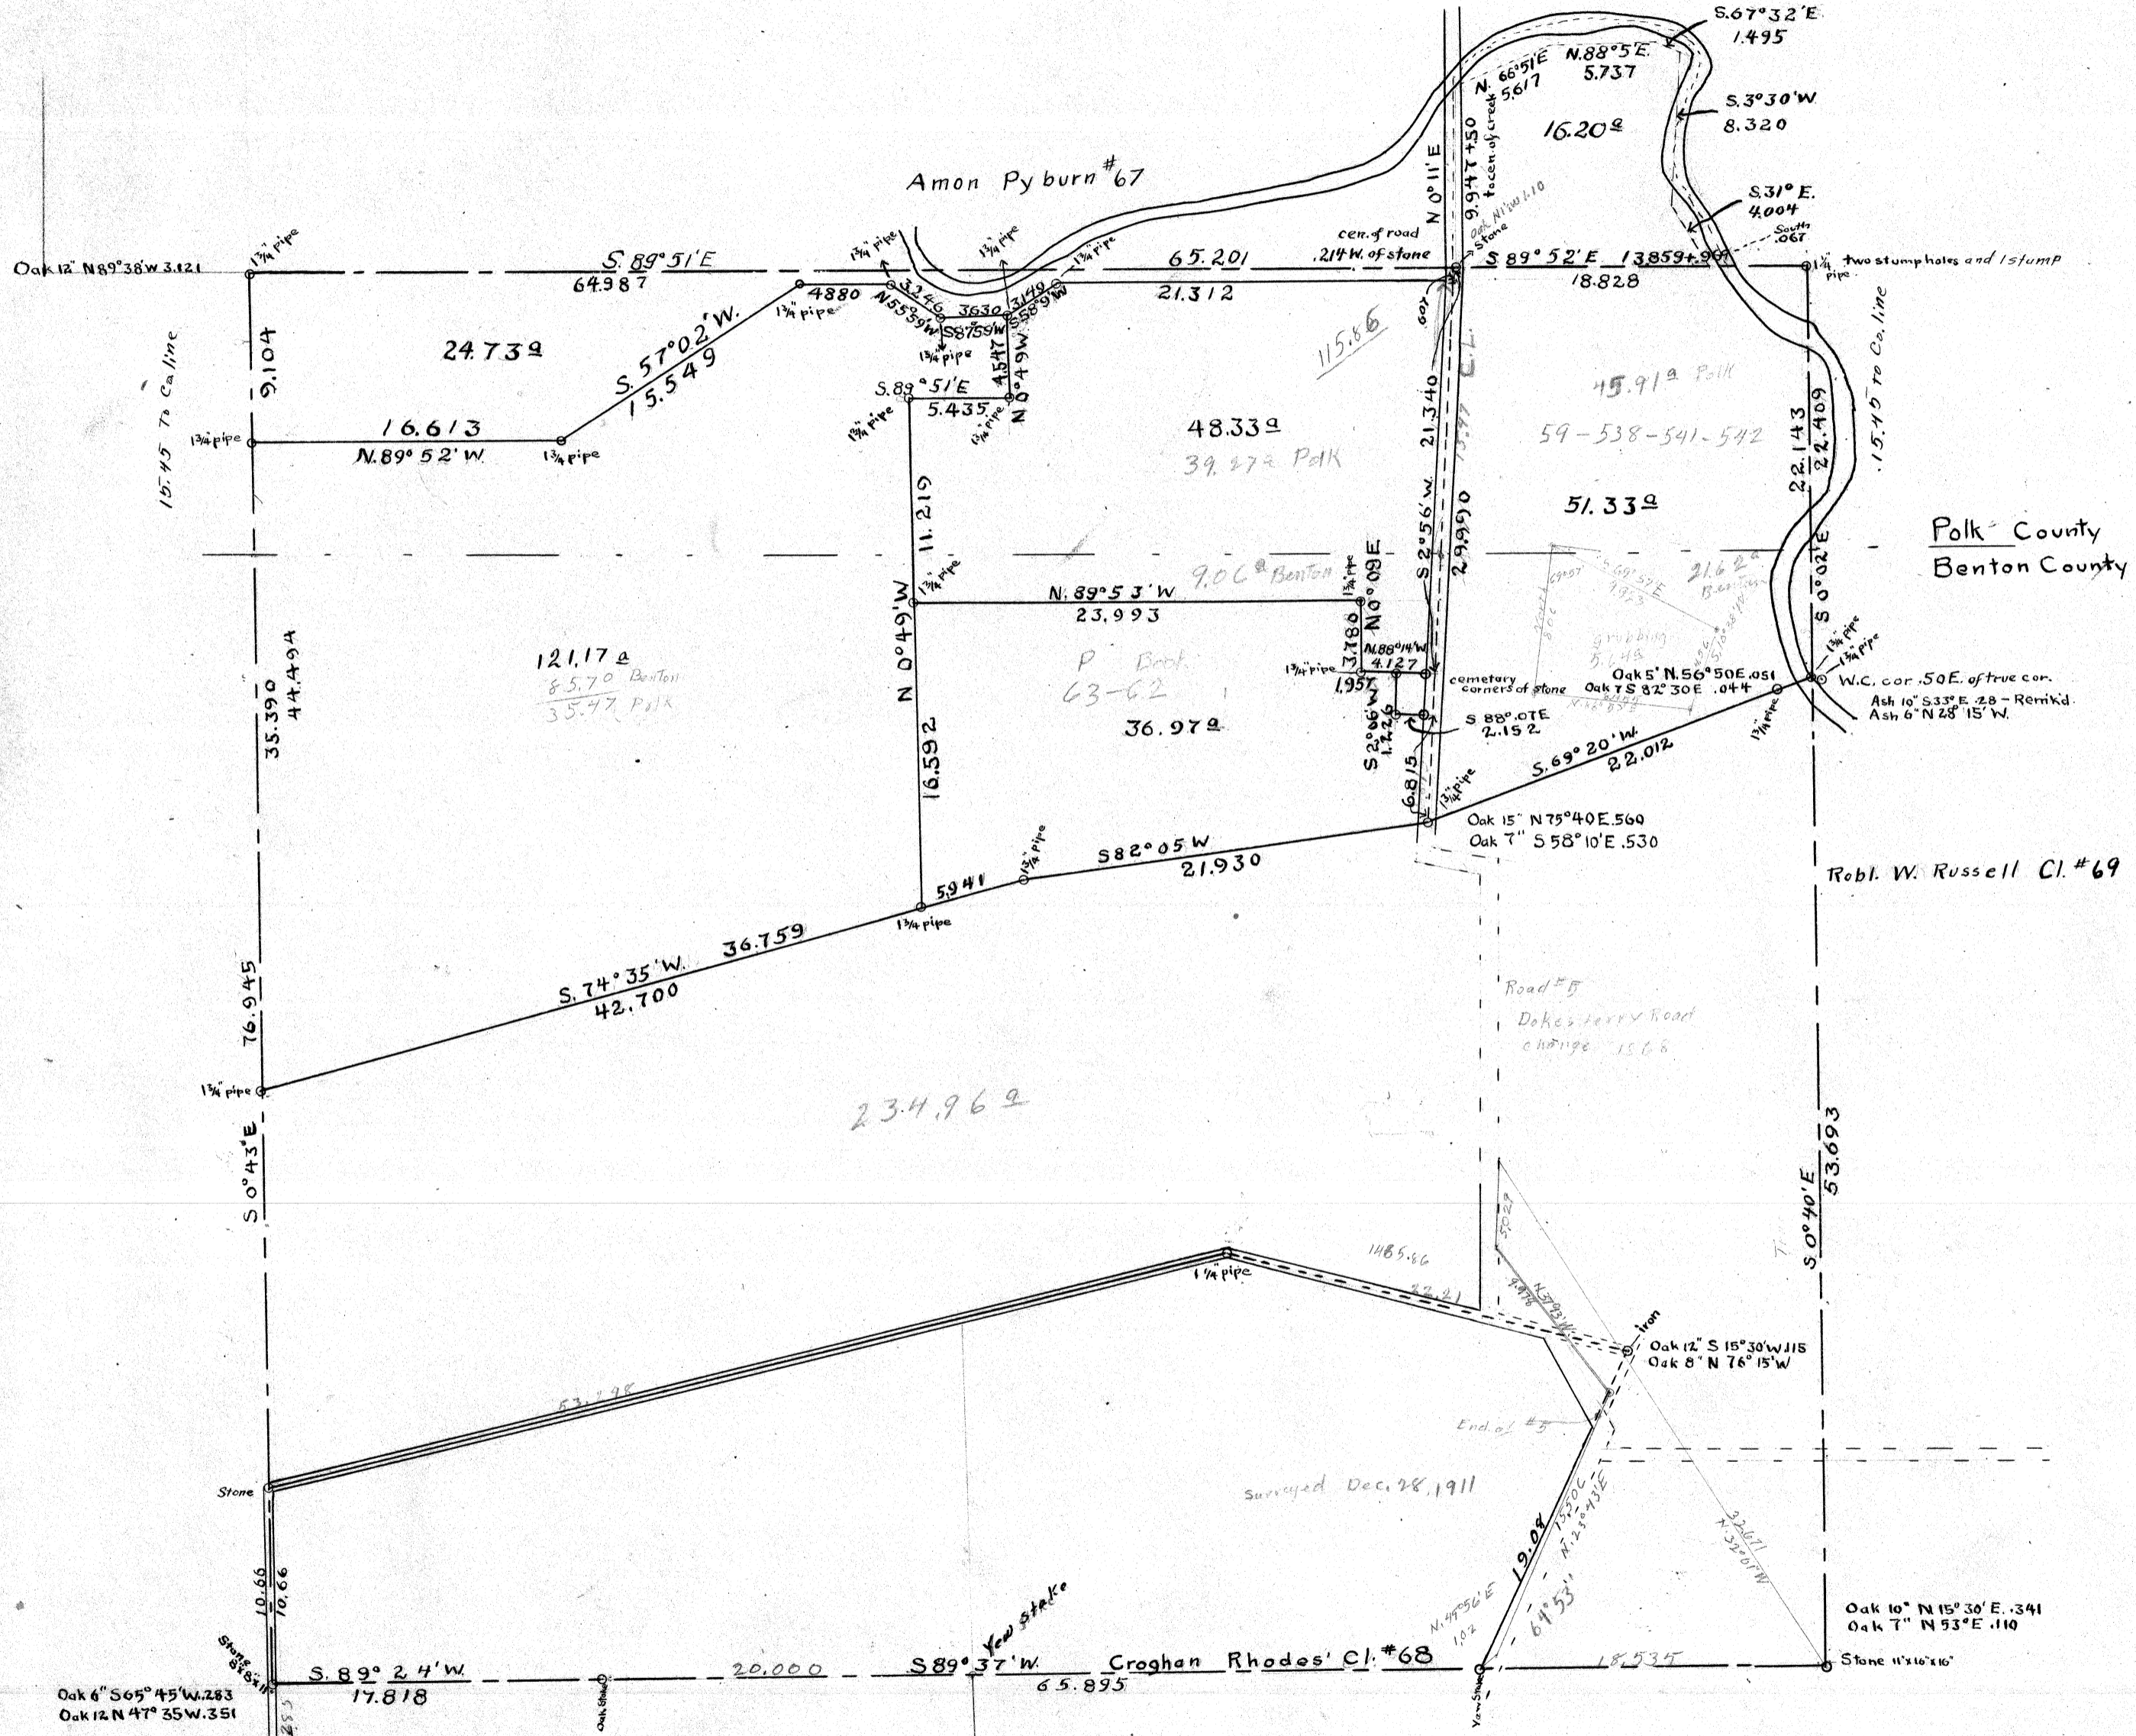

C.S. 189

10-A
4, 5, 8, 9