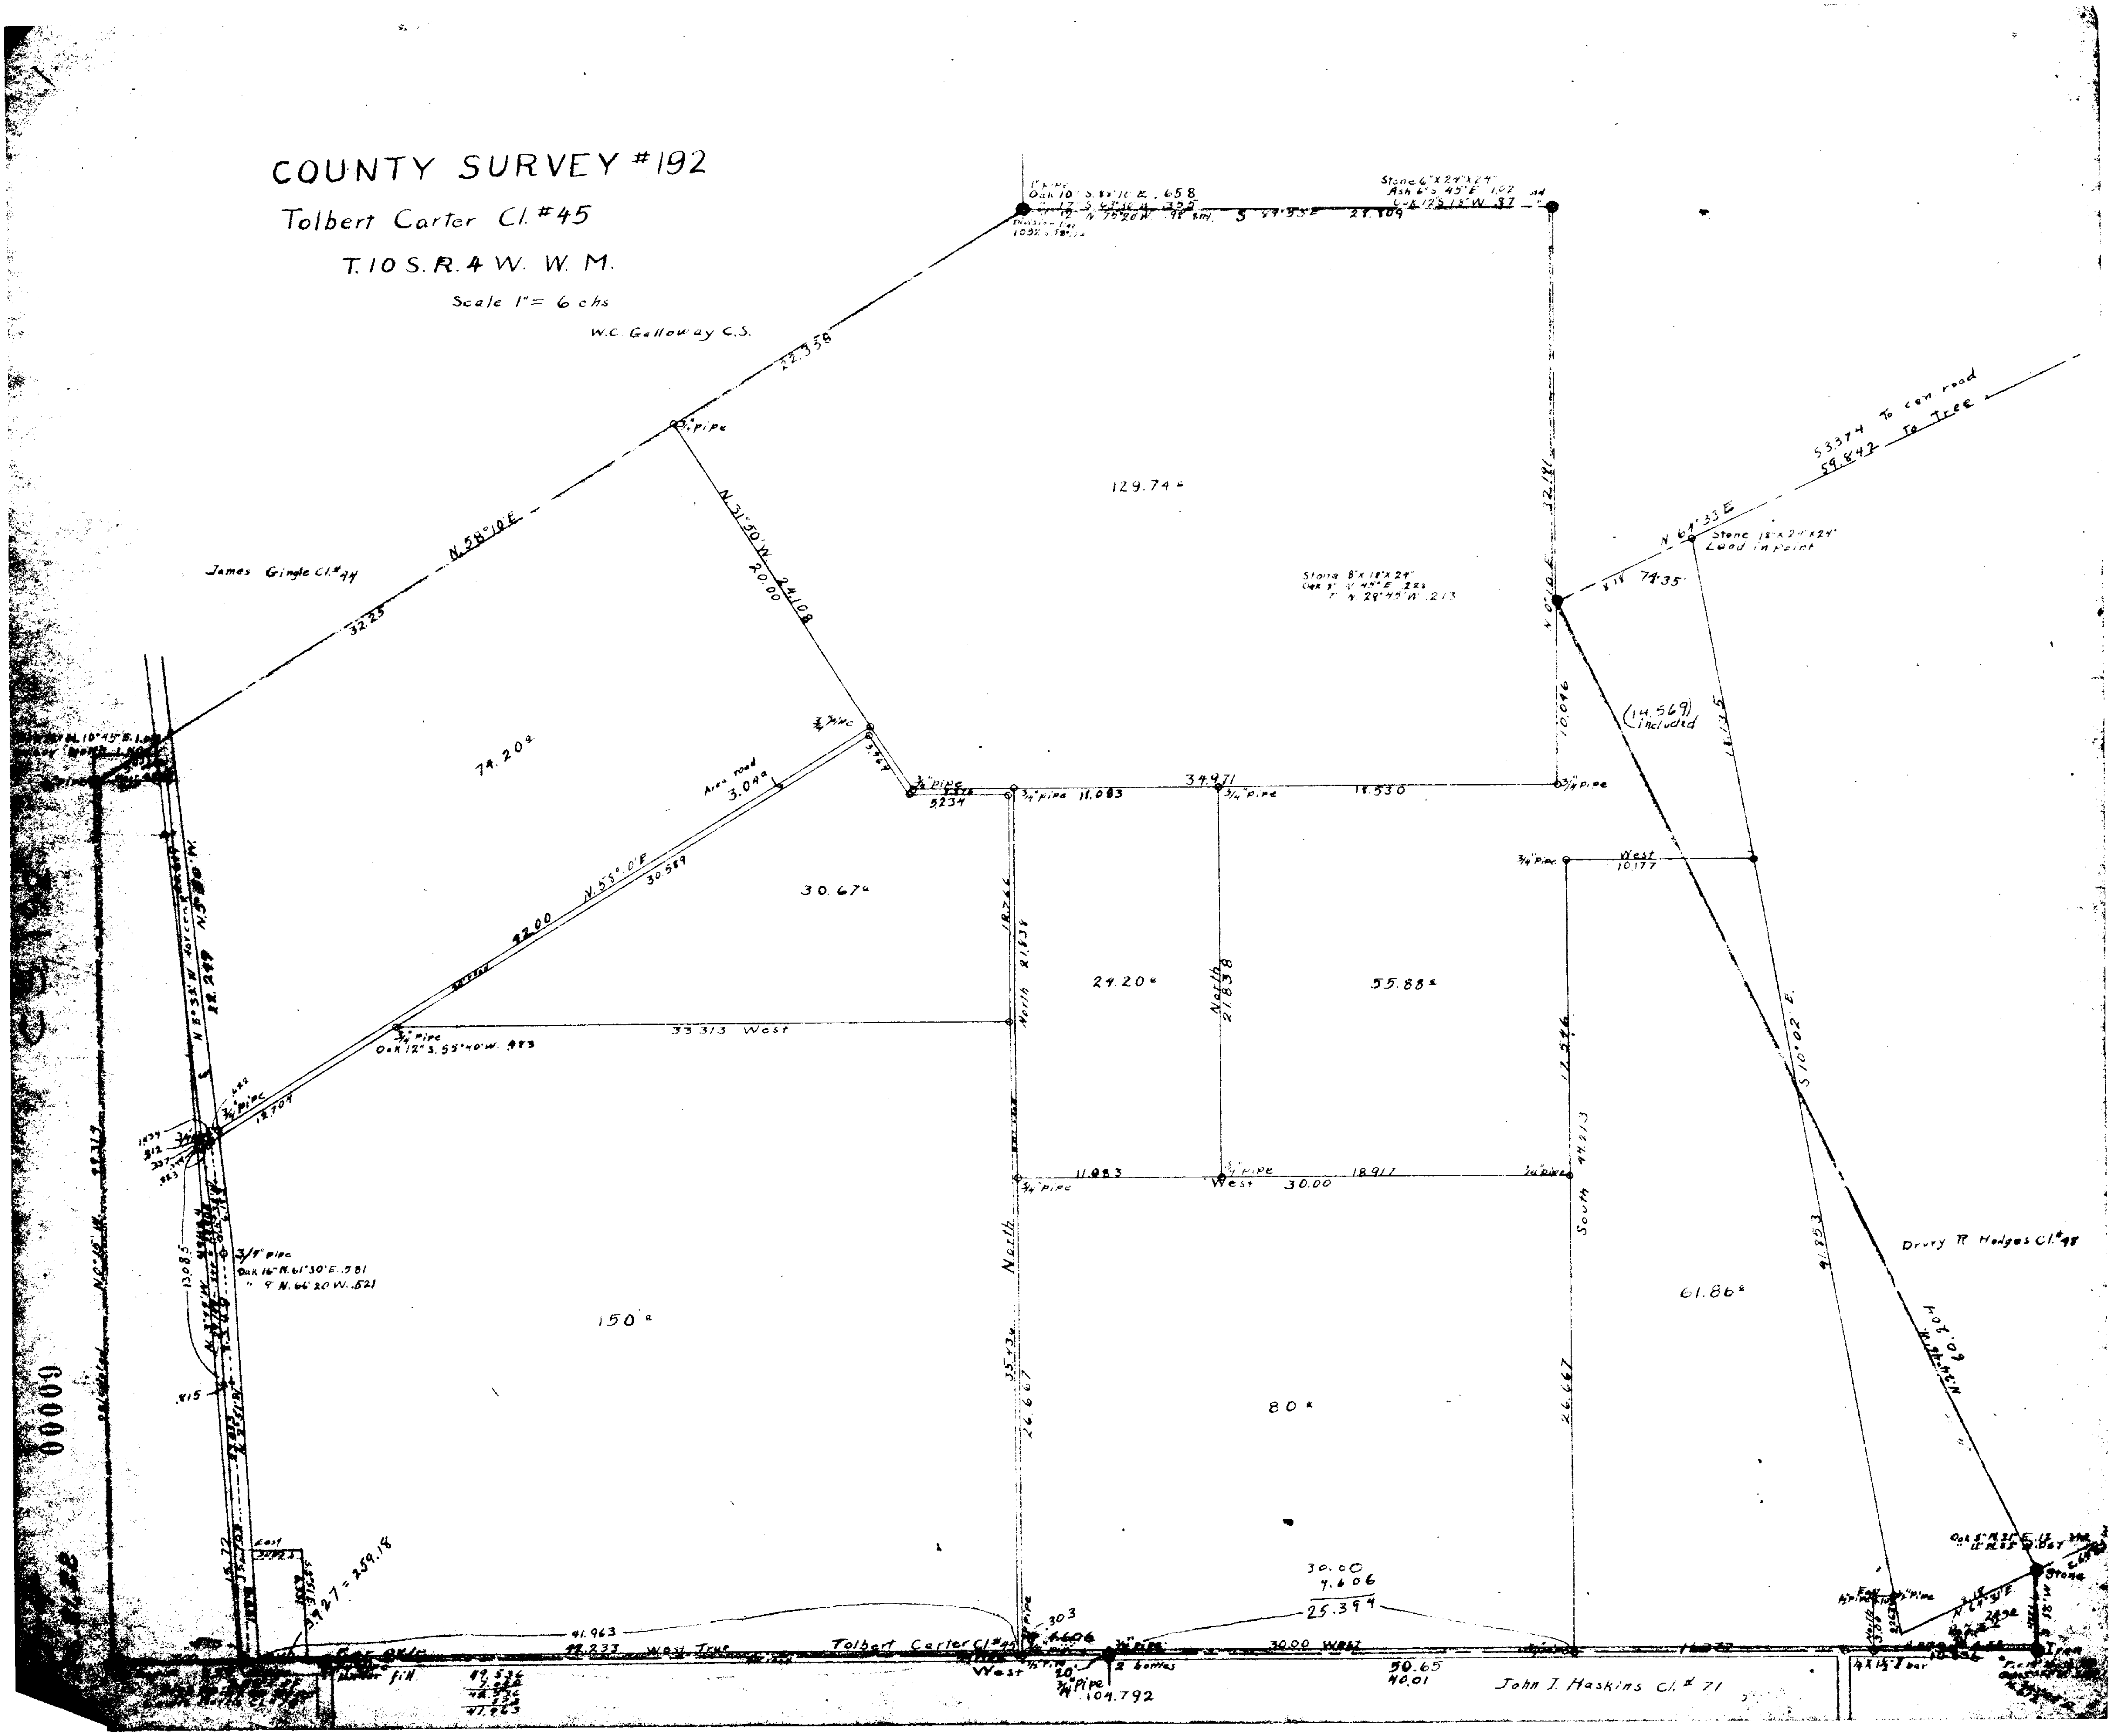
COUNTY SURVEY #192
Tolbert Carter Cl. #45
T. 10 S. R. 4 W. W. M.
Scale 1" = 6 chs
W.C. Galloway C.S.
00009
James Gingle Cl. #44
John J. Haskins Cl. #71
Drury R. Hodges Cl. #48
Tolbert Carter Cl. #45
150 a
74.20 a
30.67 a
129.74 a
24.20 a
55.88 a
80 a
61.86 a
(14.569) included
N. 58°10' E.
32.23
22.358
N. 31°50' W. 20.00
24.108
N. 55°0' E. 30.589
42.00
Area road 3.04 a
33.313 West
N. 5°32' W.
22.249
13.085
3/4" pipe
Oak 16" N. 61°30' E. .981
" 9 N. 66°20' W. .521
Oak 12" S. 55°40' W. .983
S 10°02' E.
41.853
N. 64°33' E.
74.35
Stone 18" x 24" x 24" Lead in point
53.374 To cen road
59.842 To Tree
Stone 6" x 24" x 24"
Ash 6" S. 45° E. 1.02
Oak 12" S. 18° W. .87
N. 0°10' E.
12.191
10.046
18.530
34.971
11.083
5234
North 21.838
North
21.838
18.766
11.083
West 30.00
18.917
South 44.213
17.546
26.667
West 10.177
35.434
26.667
North
41.963
42.233
West True
30.00
7.606
25.394
30.00 West
50.65
40.01
104.792
3/4" Pipe
2 bottles
.303
3.927 = 259.18
calculated N. 0°15' W. 49.319
60.204