10-4
35
10-4-00024
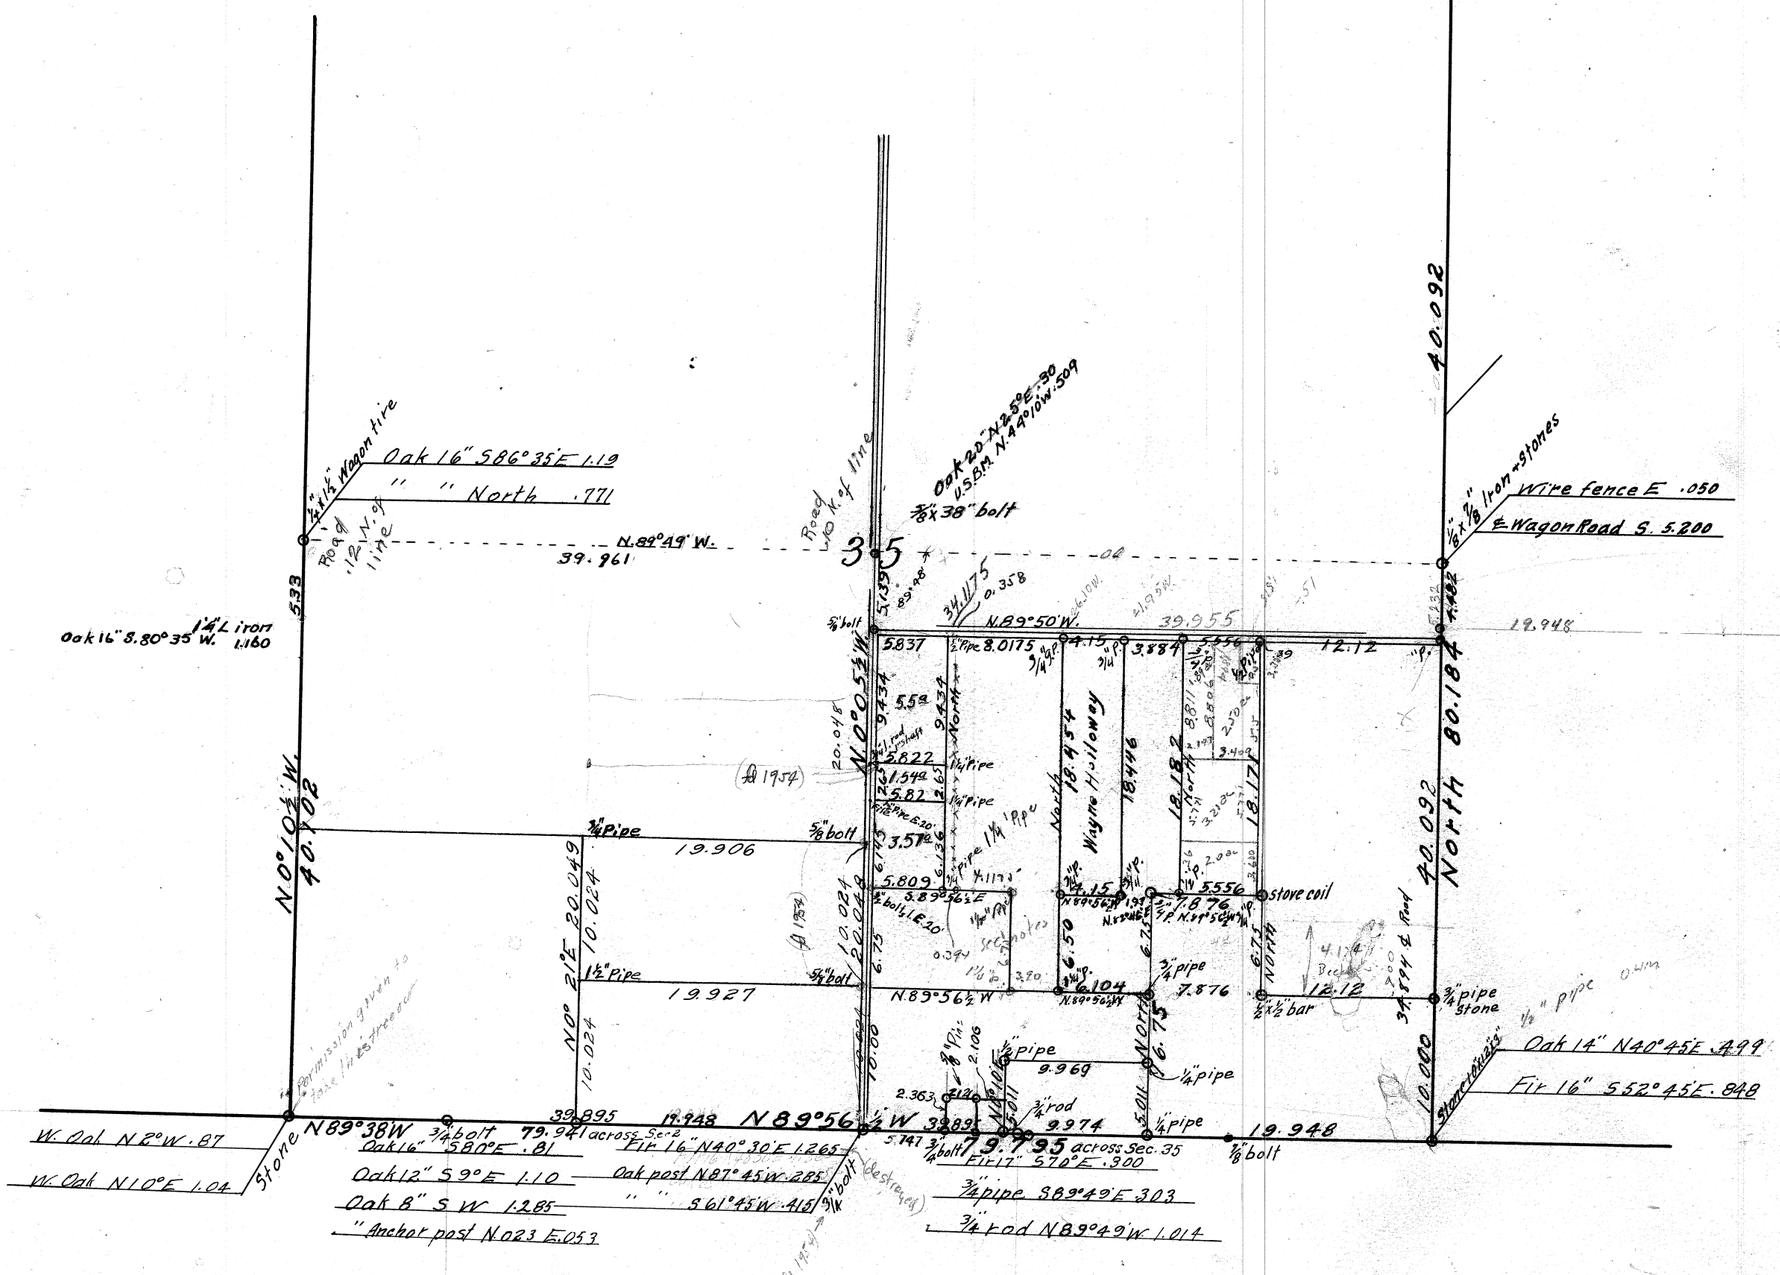
C. S. 225
Sec. 35 T10S, R4W. W.M.
Scale:-1 in. = 10 chs.