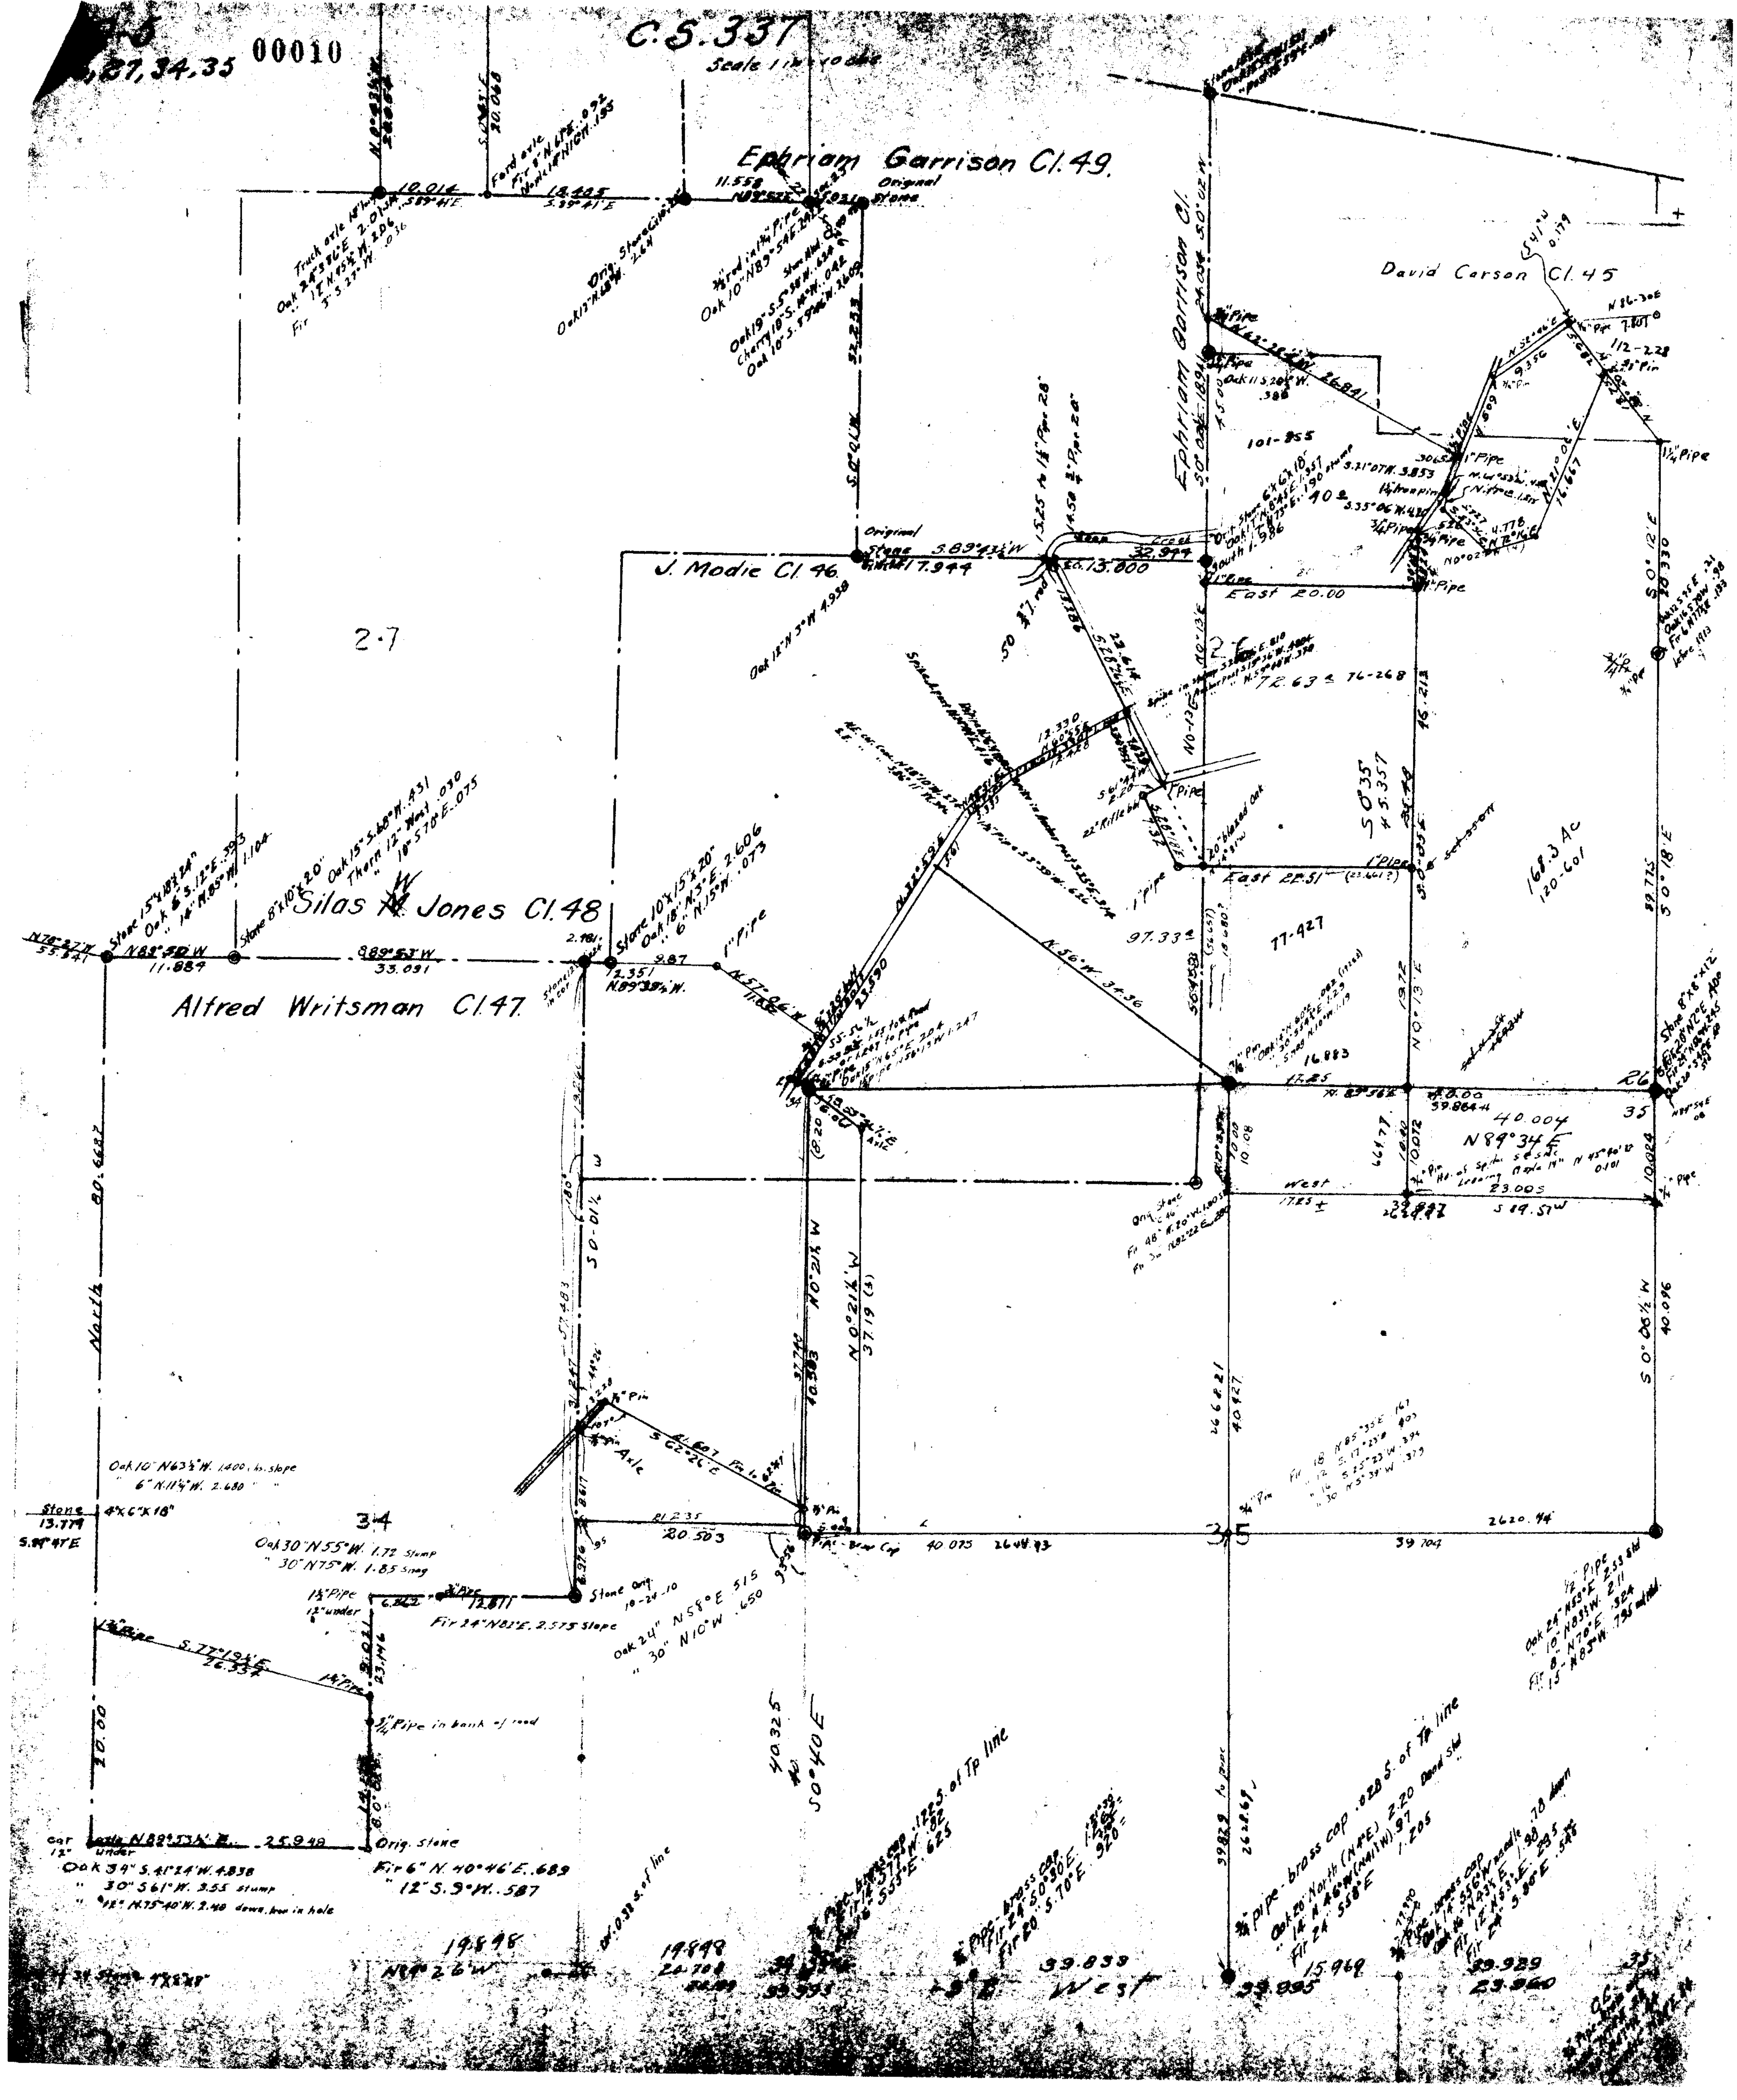
27, 34, 35
00010
C.S. 337
Scale 1 in = 10 chs
Ephriam Garrison Cl. 49
Ephriam Garrison Cl.
David Carson Cl. 45
J. Modie Cl. 46
Silas W. Jones Cl. 48
Alfred Writsman Cl. 47
27
26
34
35
168.3 Ac
120-601
77-427
101-855
72.63 ± 76-268
97.33 ±
40 ±
North
80.6687
S 0-01½
N 0°21¼ W
N 0°21¼ W
37.19 (3)
S 0° 12' E
S 0° 18' E
S 0° 06½ W
40.096
N 89°34' E
40.004
East 20.00
East 22.51
West
S 89.57 W
23.005
N 56° W 34.36
S 62°26' E
S. 77°19¼' E
26.537
N 89°53½' E
25.949
S 0°40' E
40.325
2620.44
40.075
2644.93
39.704
Original Stone
Orig. Stone
Stone Orig. 10-24-10
Oak 10" N 63½° W. 1.400
6" N 11¼° W. 2.680
Stone 4"x6"x18"
Oak 30" N 55° W. 1.72 Stump
30" N 75° W. 1.85 Snag
Fir 24" N 82° E. 2.575 Slope
Oak 24" N 58° E .515
30" N 10° W .650
¾" Pipe in bank of road
Oak 34" S. 41°24' W. 4.838
30" S 61° W. 3.55 stump
Fir 6" N. 40°46' E. .689
12" S. 9° W. .587
19.848
N 89° 26' W
39.839
West
39.895
15.969
39.929
23.960
¾" pipe - brass cap
Oak 20" North (N 4° E) 2.20 Dead Std
14" N 46° W (N 41 W) .97
Fir 24" S 58° E 1.205
Oak 24" N 53° E 2.53 Std
10" N 83½ W. 2.11
Fir 8" N 70° E .324
15" N 85° W. .735
Fir 18 N 85°35' E .167
12 S. 17°23' E .403
16 S 25°23' W .394
30 N 5°39' W .379