10-5 00013

36

SURVEY 299

Secs. 30 & 31; 25 & 36 T 10 S R. 48 S W

Scale 1" = 10 chs.
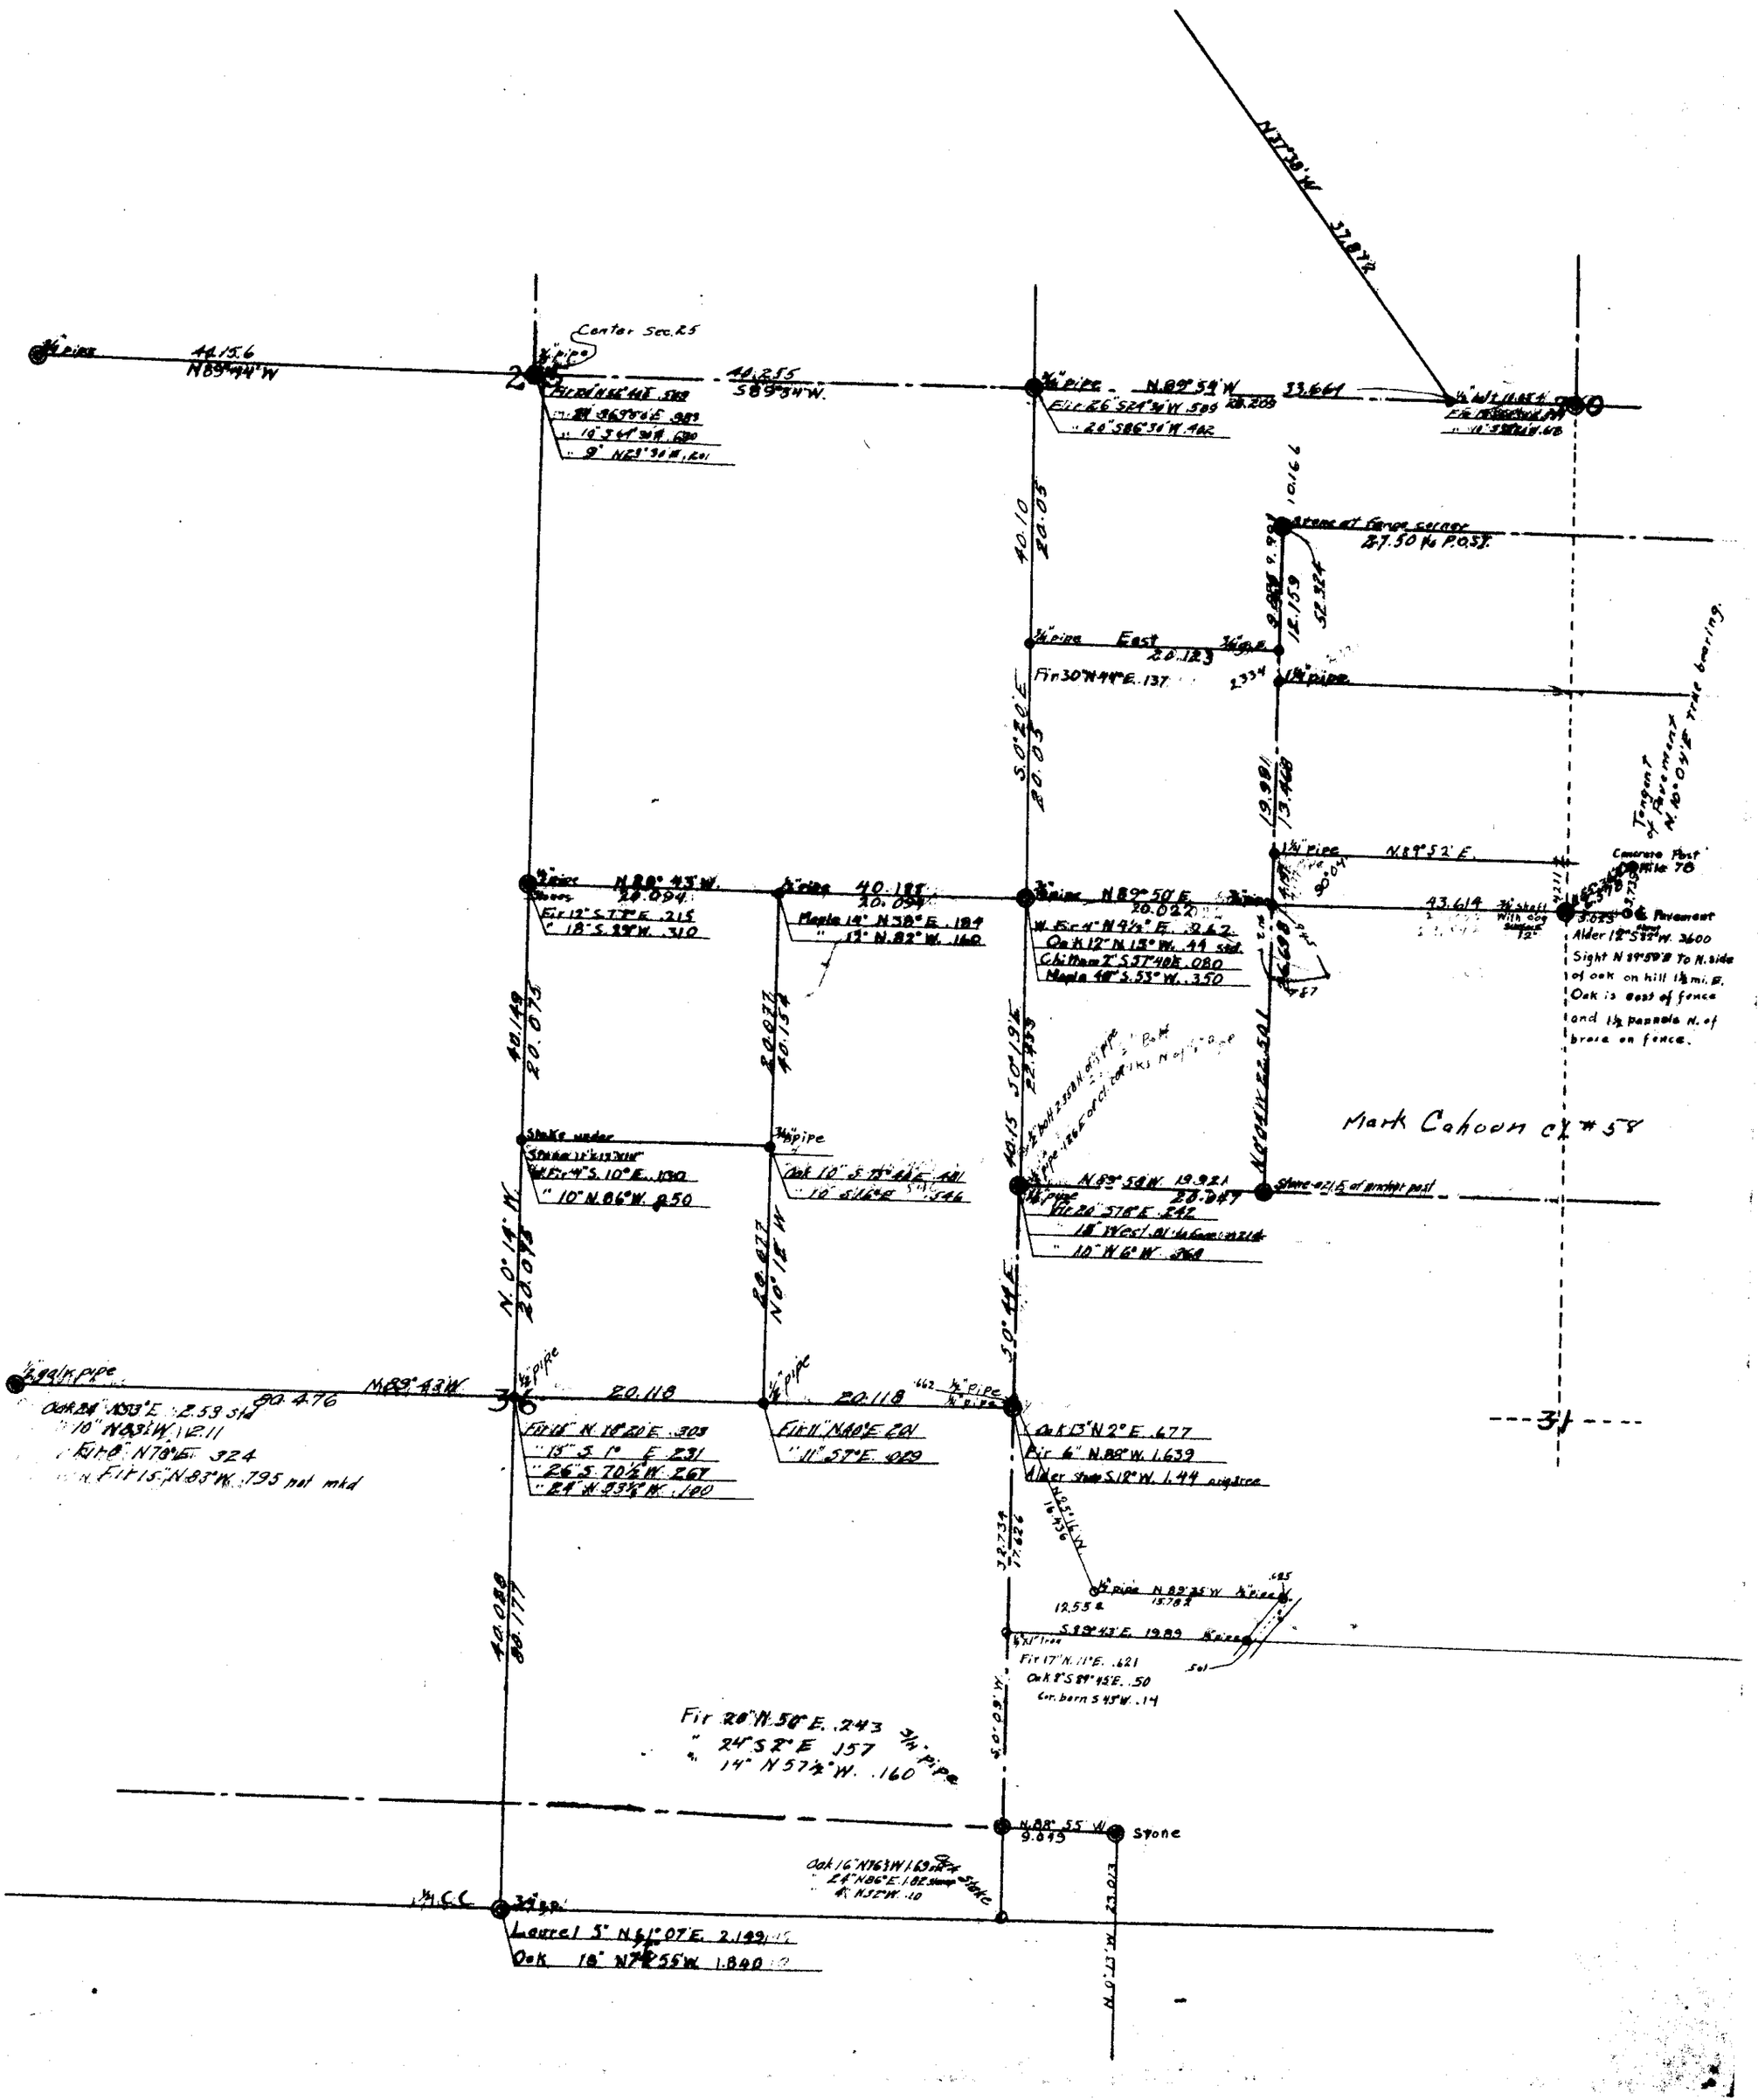
W. C. Galloway C.S.
March & Dec 1925.