10-6
14, 15, 22, 23

00004

COUNTY SURVEY #253

James Greer Claim #50

T. 10 S. R. 6 W. W. M.

Scale 1" = 10 chs.

W.C. Galloway C.S.

Sept. 27, 1916.
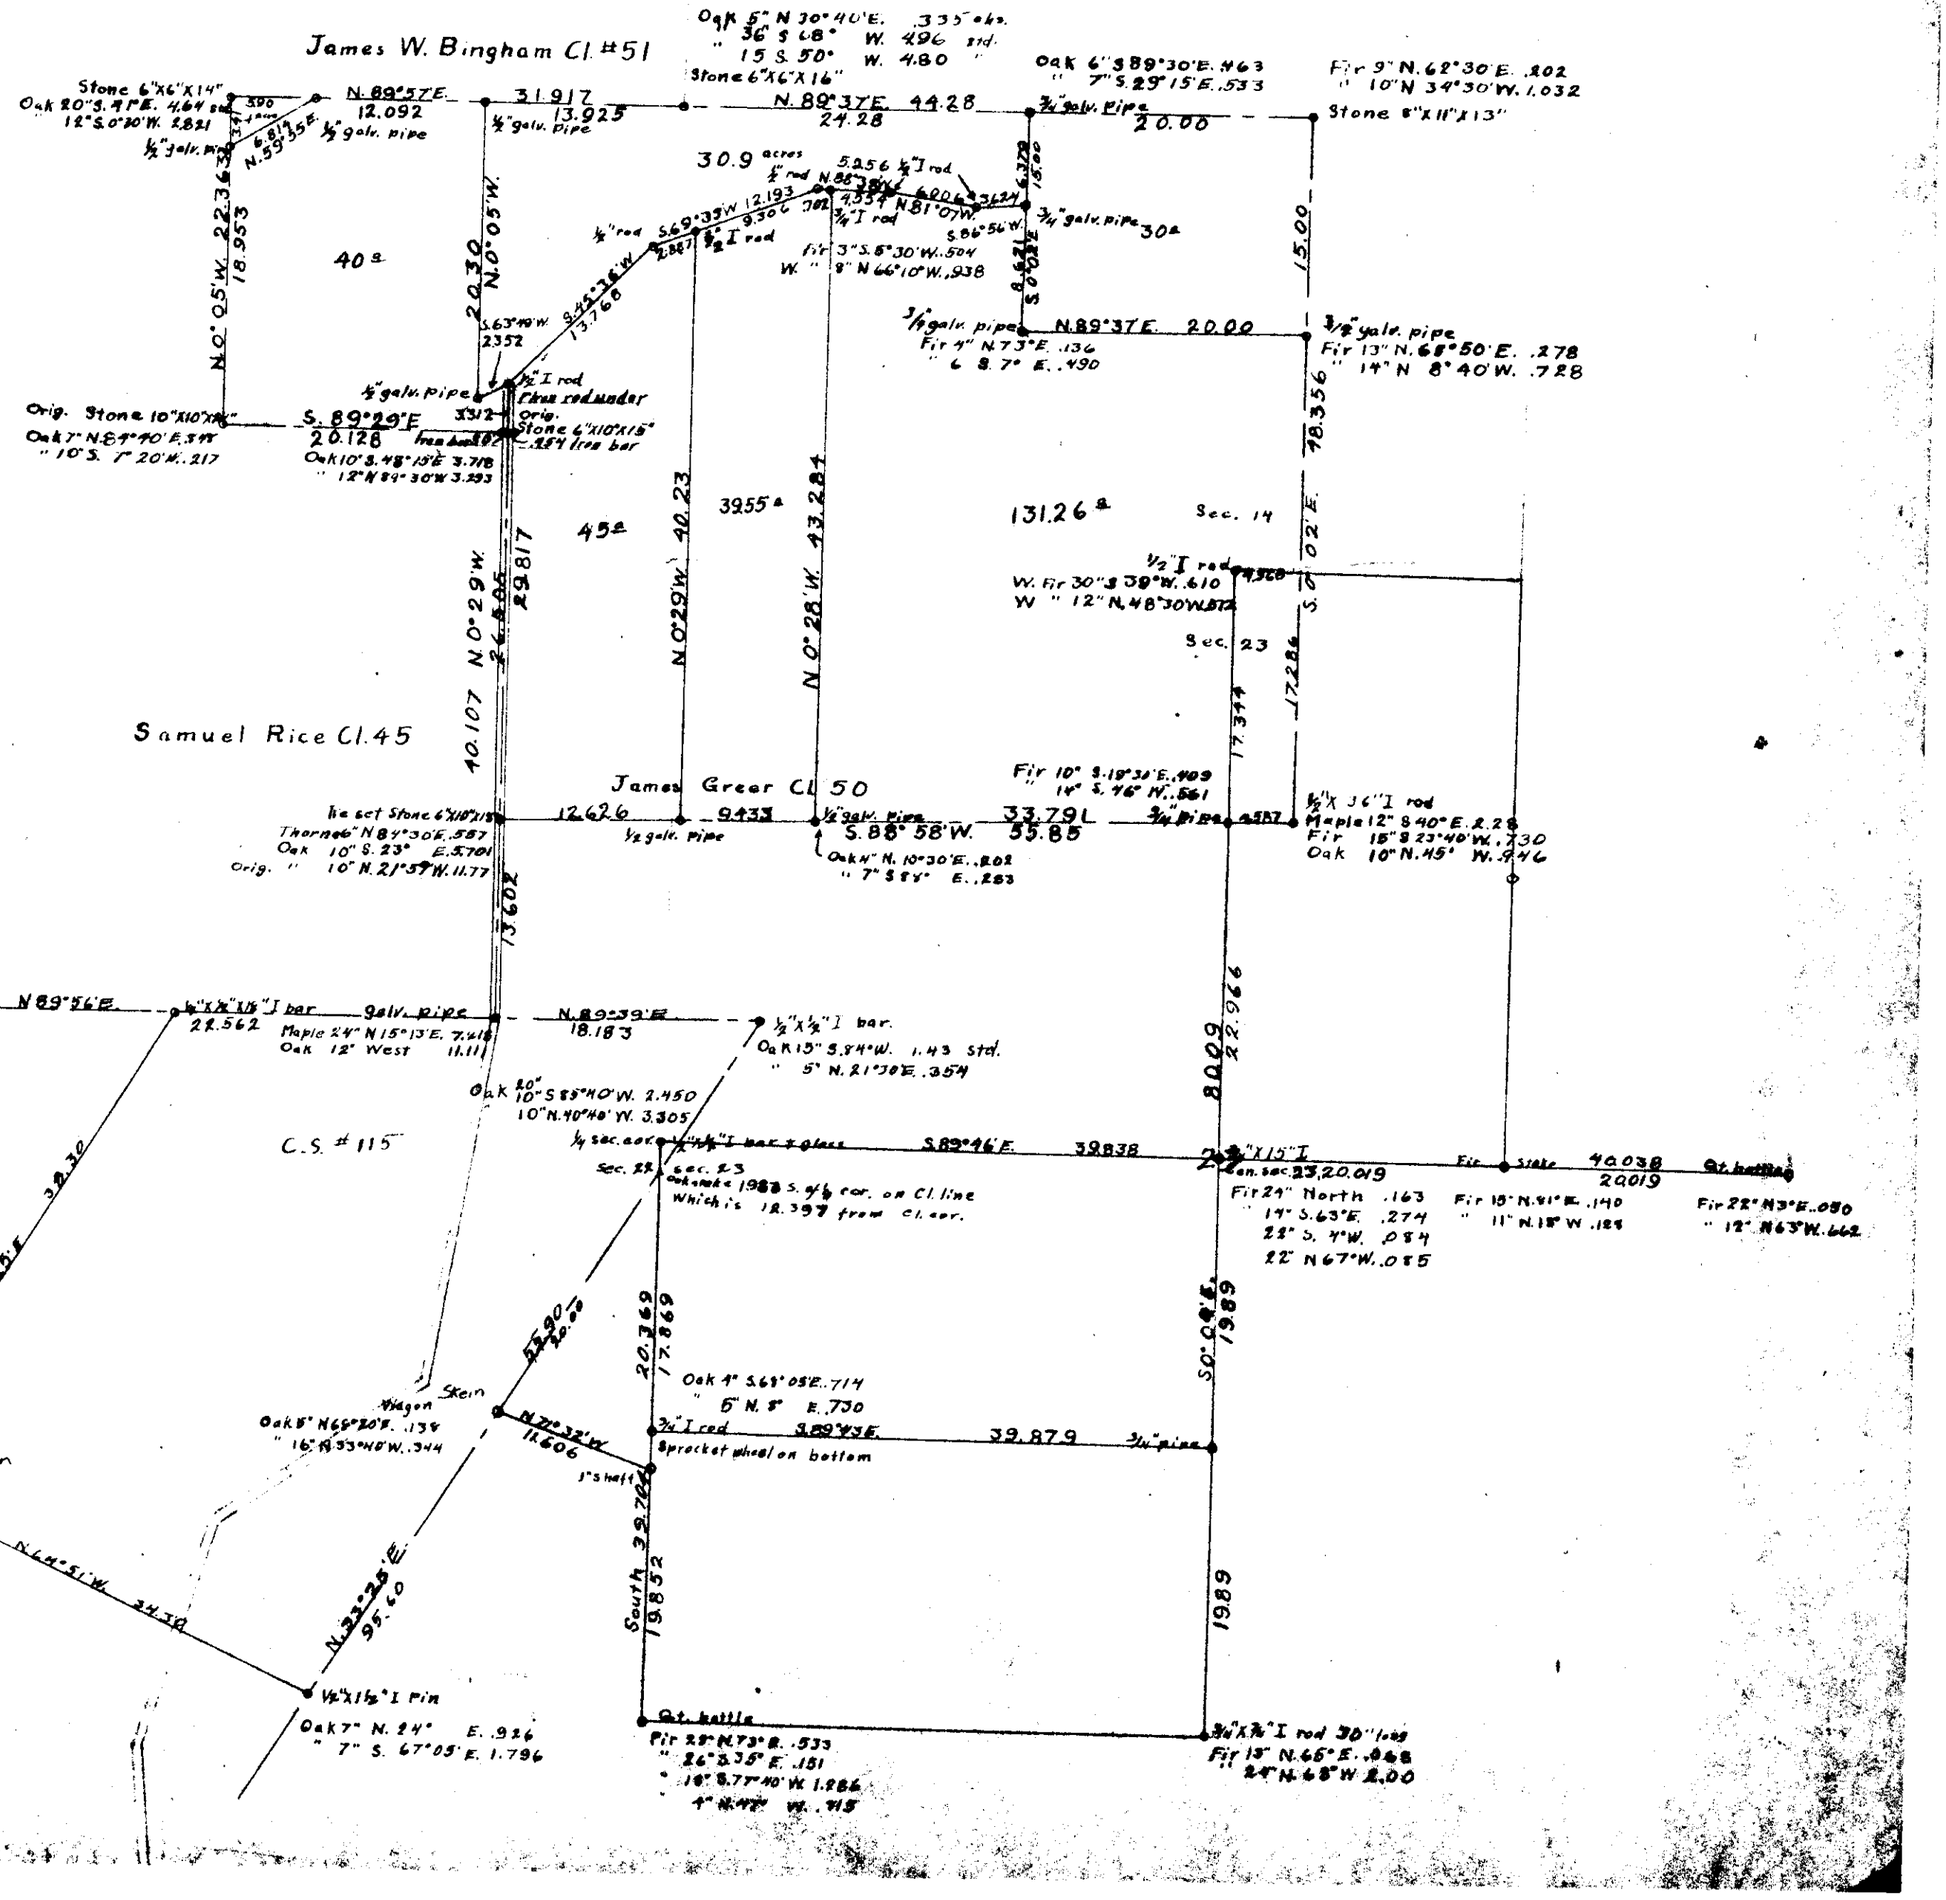
For Whom
H.T. Maxfield
Walter Maxfield
Elmer Maxfield
Florence Maxfield Wilkes
Frank Miller