10-6 00012

25 & 36 & 35

COUNTY SURVEY NO. 354
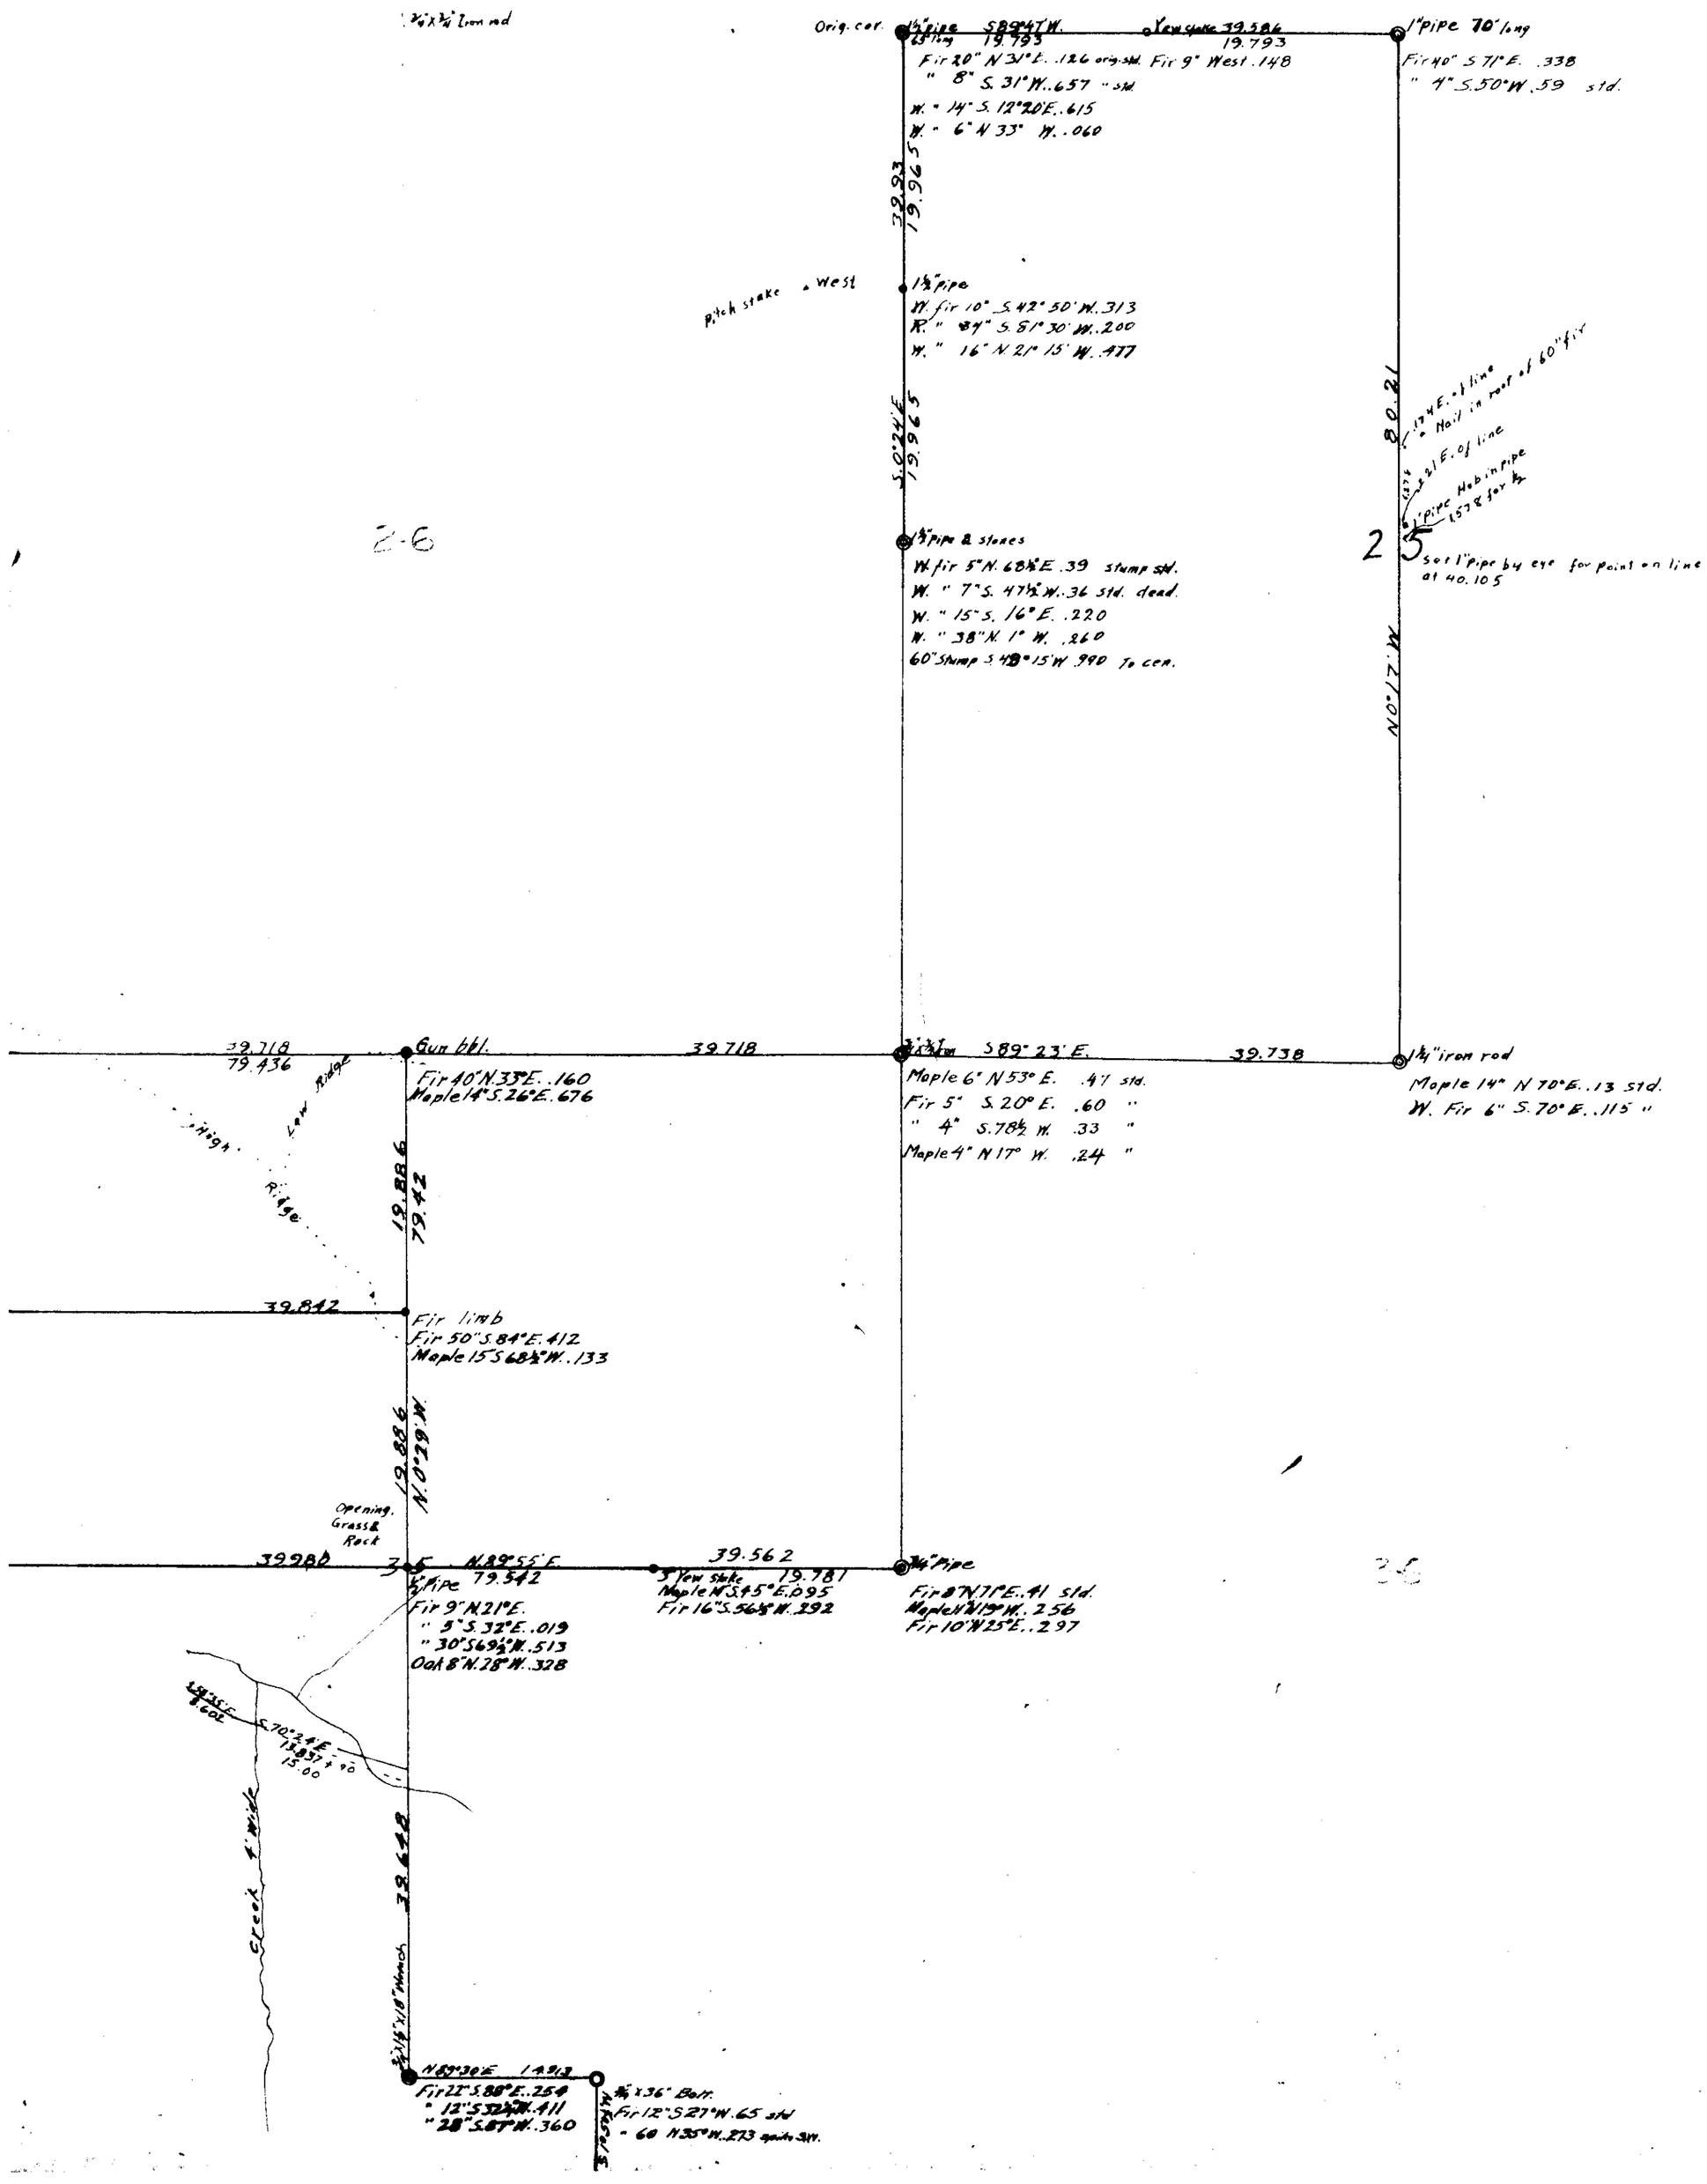
1" = 10^c