10-7
10

00003

C.S. NO. 310

SEC. 10 T. 10 S.R. 7 W. WILL. MER.
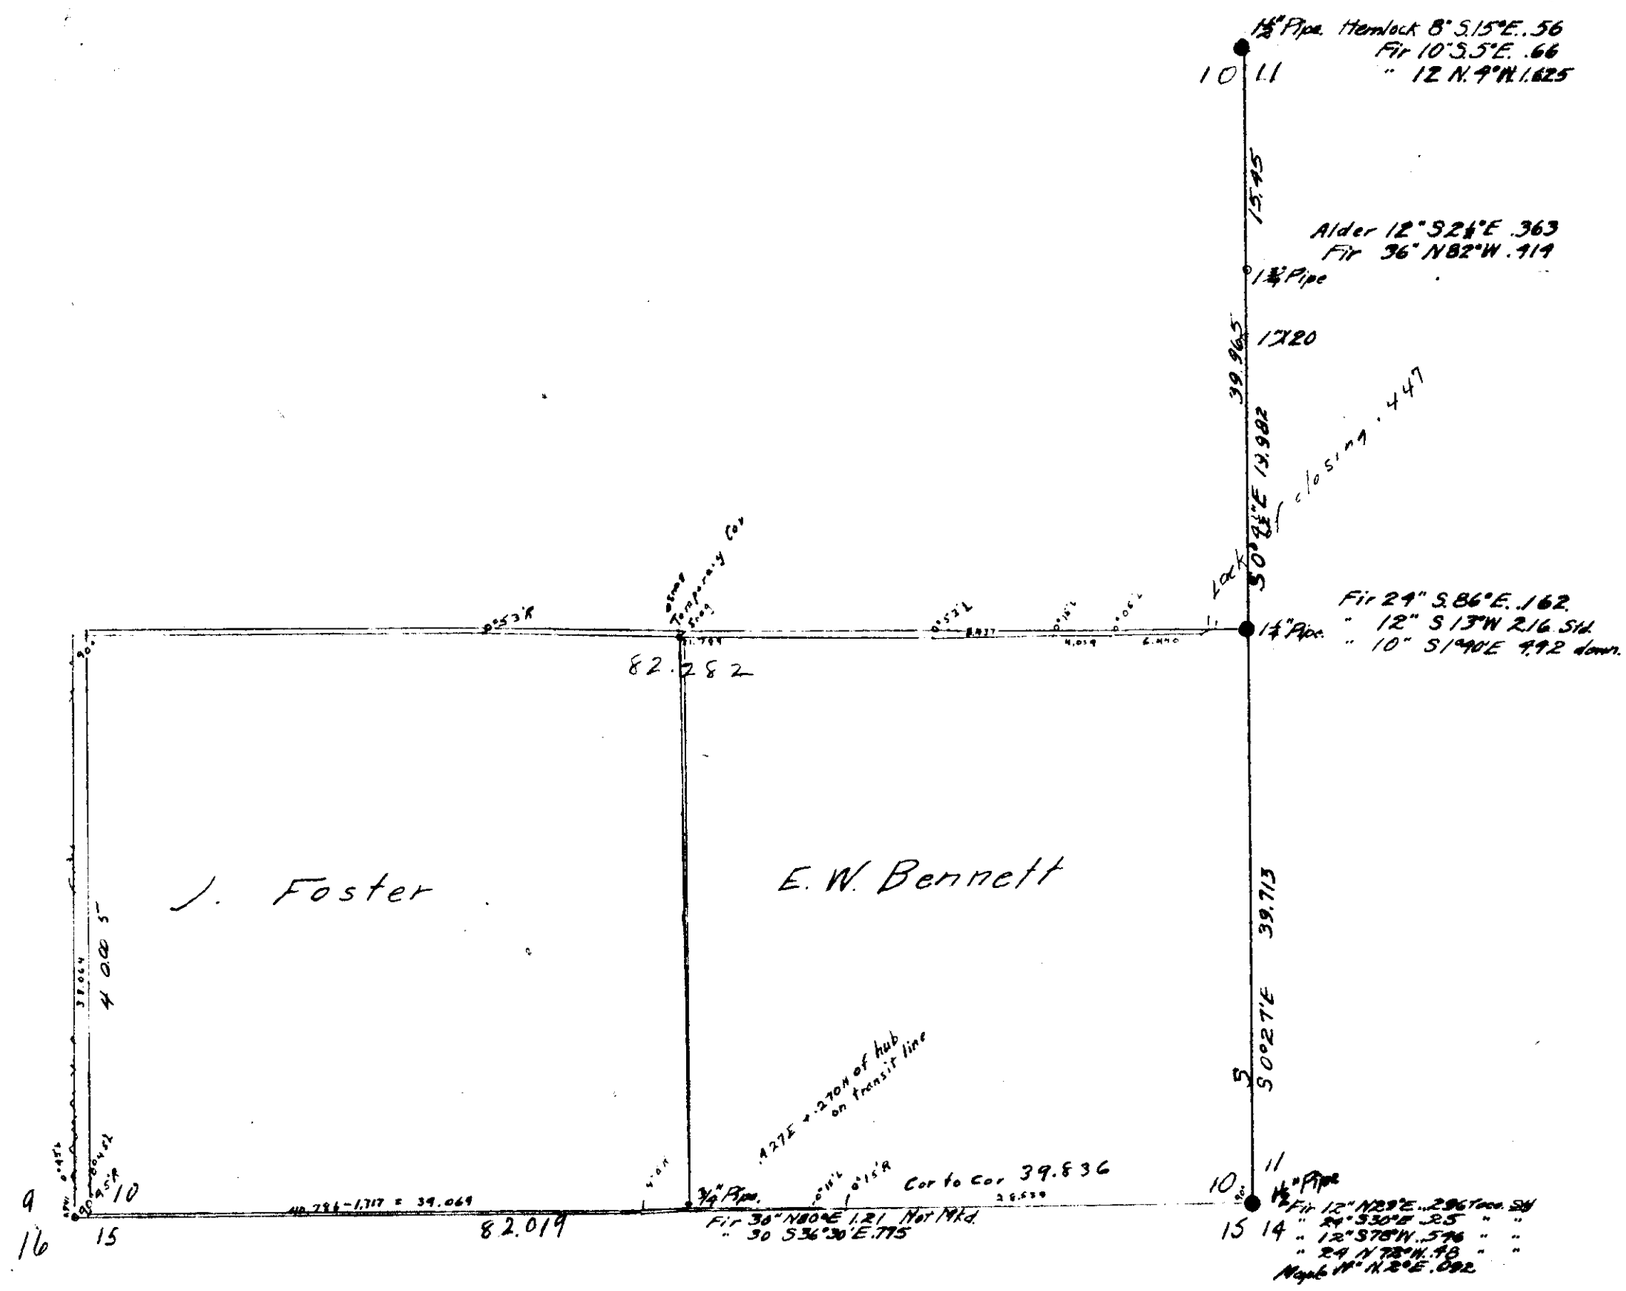
SCALE. 1" = 10 CHS.